


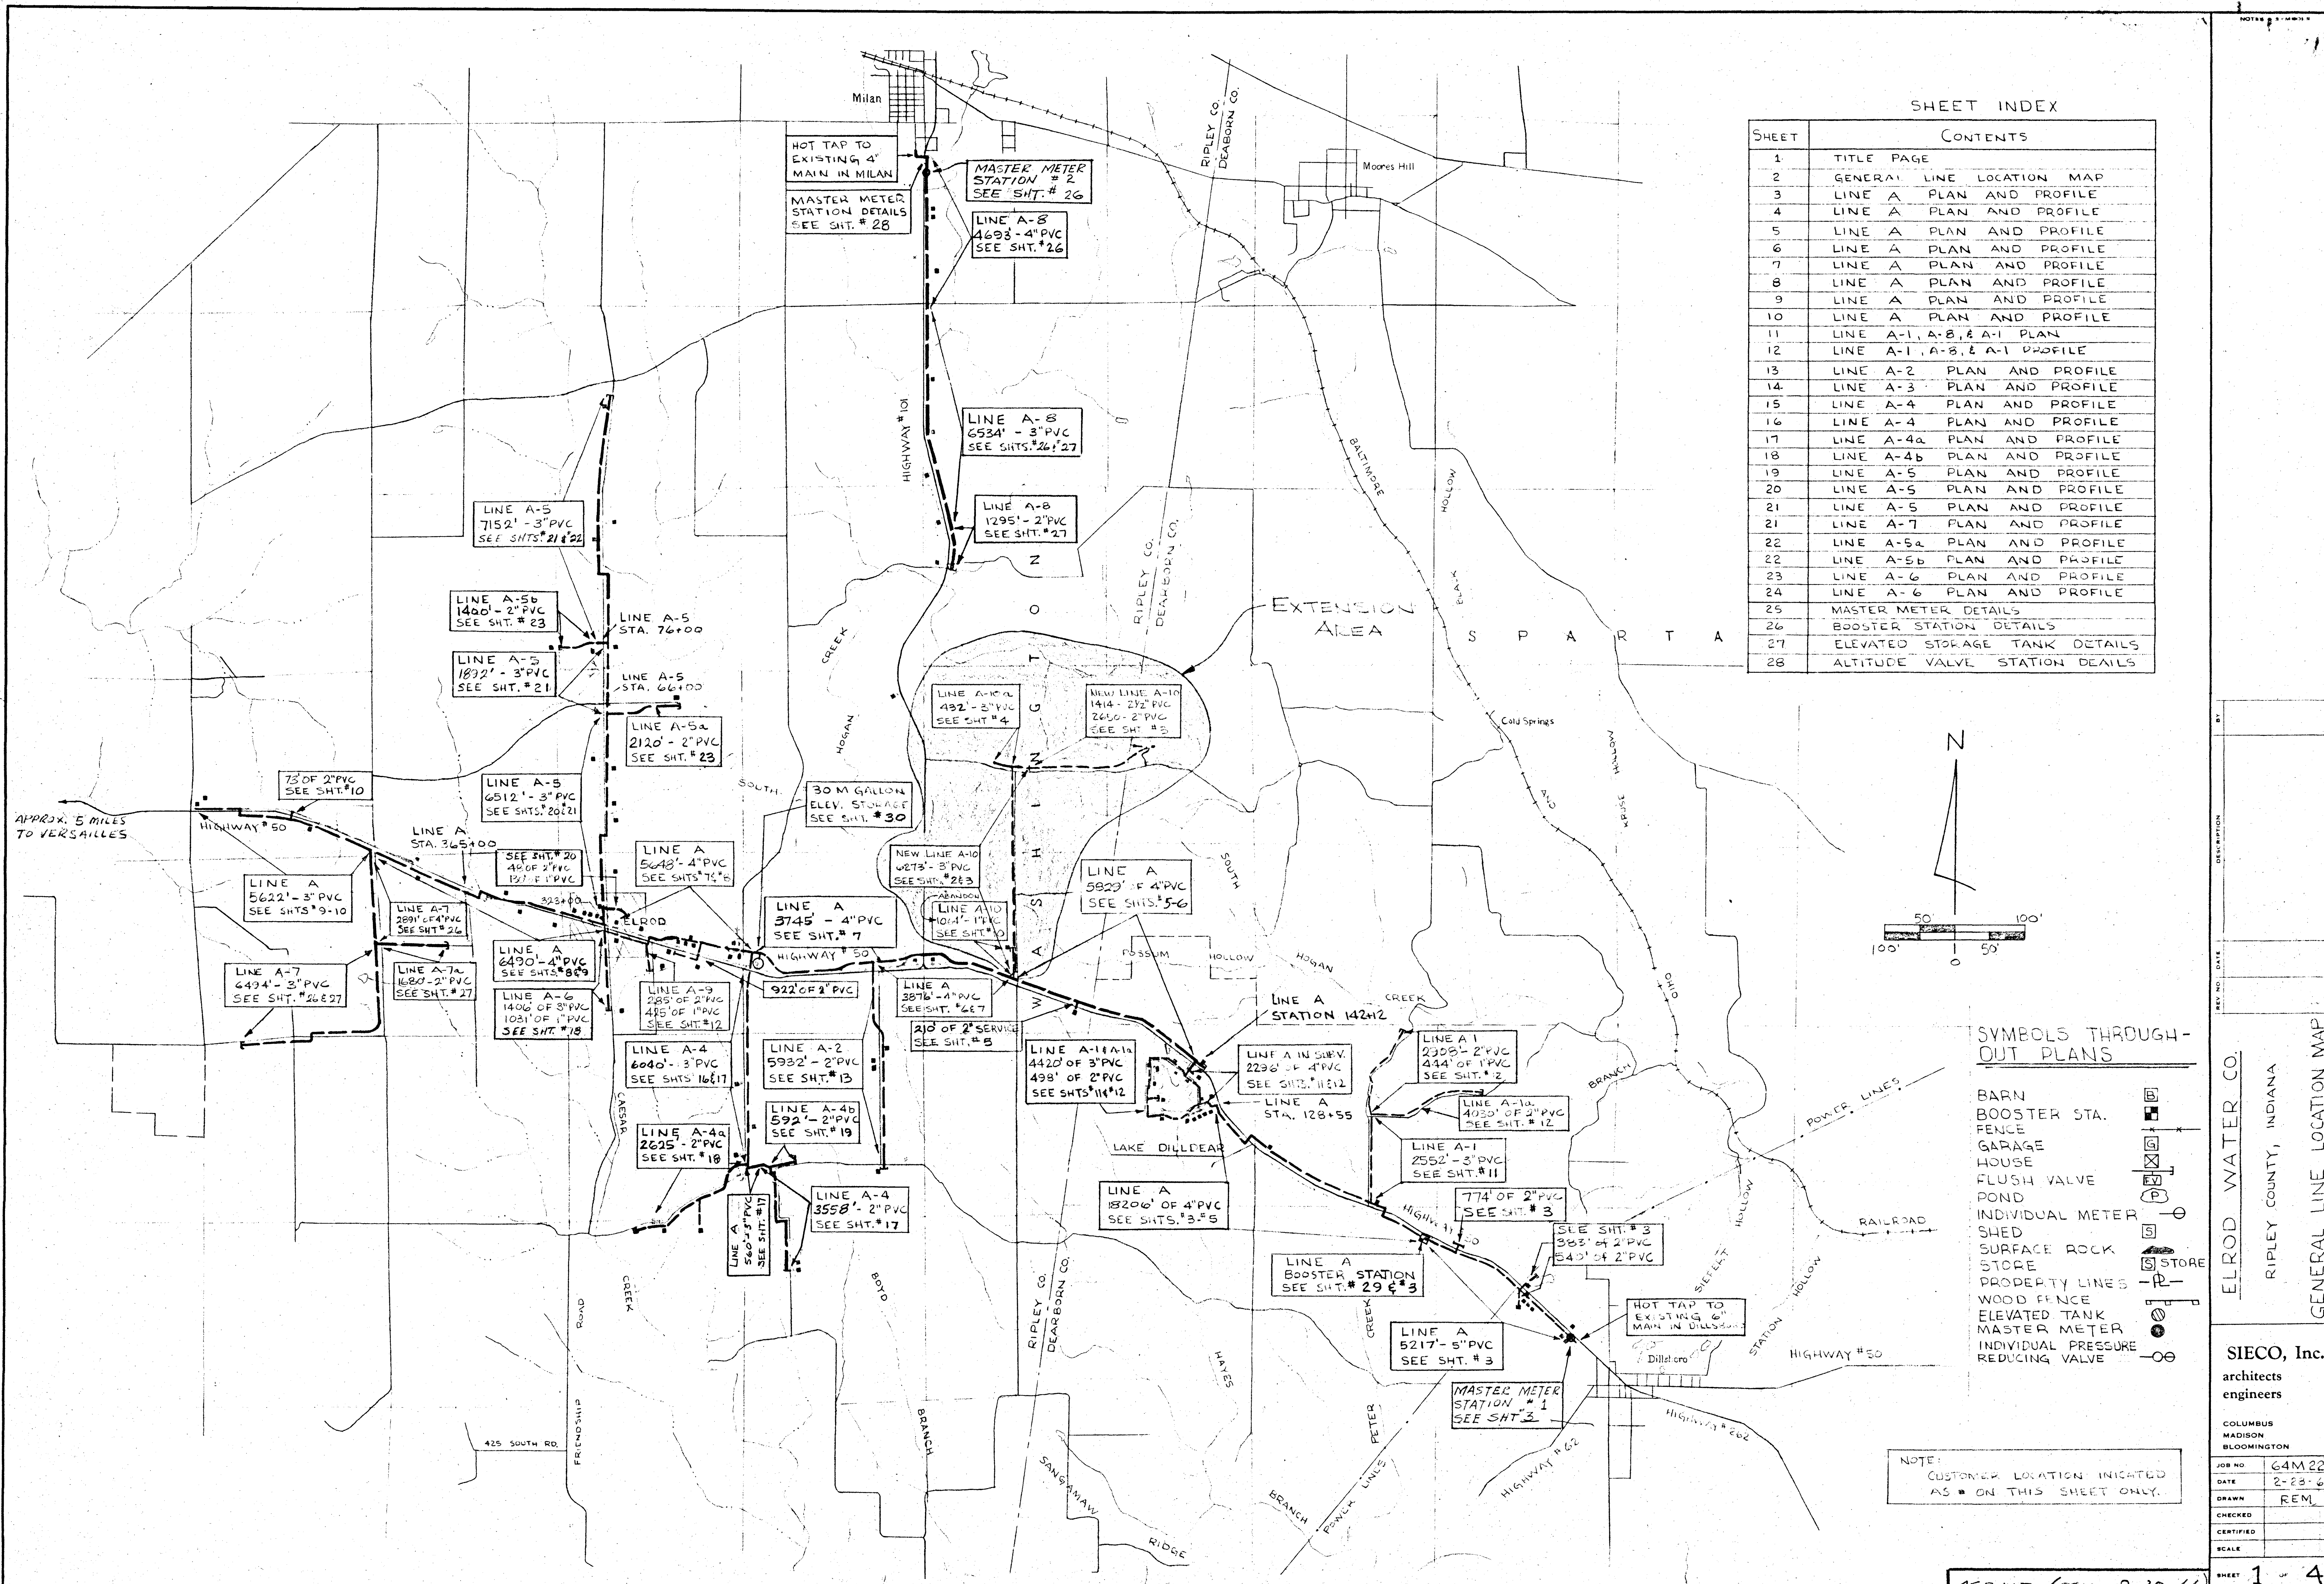

SHEET INDEX	
SHEET	CONTENTS
1	TITLE PAGE
2	GENERAL LINE LOCATION MAP
3	LINE A PLAN AND PROFILE
4	LINE A PLAN AND PROFILE
5	LINE A PLAN AND PROFILE
6	LINE A PLAN AND PROFILE
7	LINE A PLAN AND PROFILE
8	LINE A PLAN AND PROFILE
9	LINE A PLAN AND PROFILE
10	LINE A PLAN AND PROFILE
11	LINE A-1, A-8, & A-1 PLAN
12	LINE A-1, A-8, & A-1 PROFILE
13	LINE A-2 PLAN AND PROFILE
14	LINE A-3 PLAN AND PROFILE
15	LINE A-4 PLAN AND PROFILE
16	LINE A-4 PLAN AND PROFILE
17	LINE A-4a PLAN AND PROFILE
18	LINE A-4b PLAN AND PROFILE
19	LINE A-5 PLAN AND PROFILE
20	LINE A-5 PLAN AND PROFILE
21	LINE A-5 PLAN AND PROFILE
21	LINE A-7 PLAN AND PROFILE
22	LINE A-5a PLAN AND PROFILE
22	LINE A-5b PLAN AND PROFILE
23	LINE A-6 PLAN AND PROFILE
24	LINE A-6 PLAN AND PROFILE
25	MASTER METER DETAILS
26	BOOSTER STATION DETAILS
27	ELEVATED STORAGE TANK DETAILS
28	ALTITUDE VALVE STATION DETAILS

SYMBOLS THROUGH-OUT PLANS

- BARN
- BOOSTER STA.
- FENCE
- GARAGE
- HOUSE
- FLUSH VALVE
- POND
- INDIVIDUAL METER
- SHED
- SURFACE ROCK
- STORE
- PROPERTY LINES
- WOOD FENCE
- ELEVATED TANK
- MASTER METER
- INDIVIDUAL PRESSURE
- REDUCING VALVE

NOTE: CUSTOMER LOCATION INDICATED AS * ON THIS SHEET ONLY.

ELROD WATER CO.
RIPLEY COUNTY, INDIANA
GENERAL LINE LOCATION MAP

SIECO, Inc.
architects
engineers
COLUMBUS
MADISON
BLOOMINGTON

JOB NO. 64M22
DATE 2-23-66
DRAWN REM
CHECKED
CERTIFIED
SCALE

ASBUILT (REM 9-30-66)

SHEET 1 of 4