



PLAN	DATE	BY	NO.
SURVEYED			
NOTE BOOK			
ALIGNMENT CHECKED			
RT. OF WAY CHECKED			

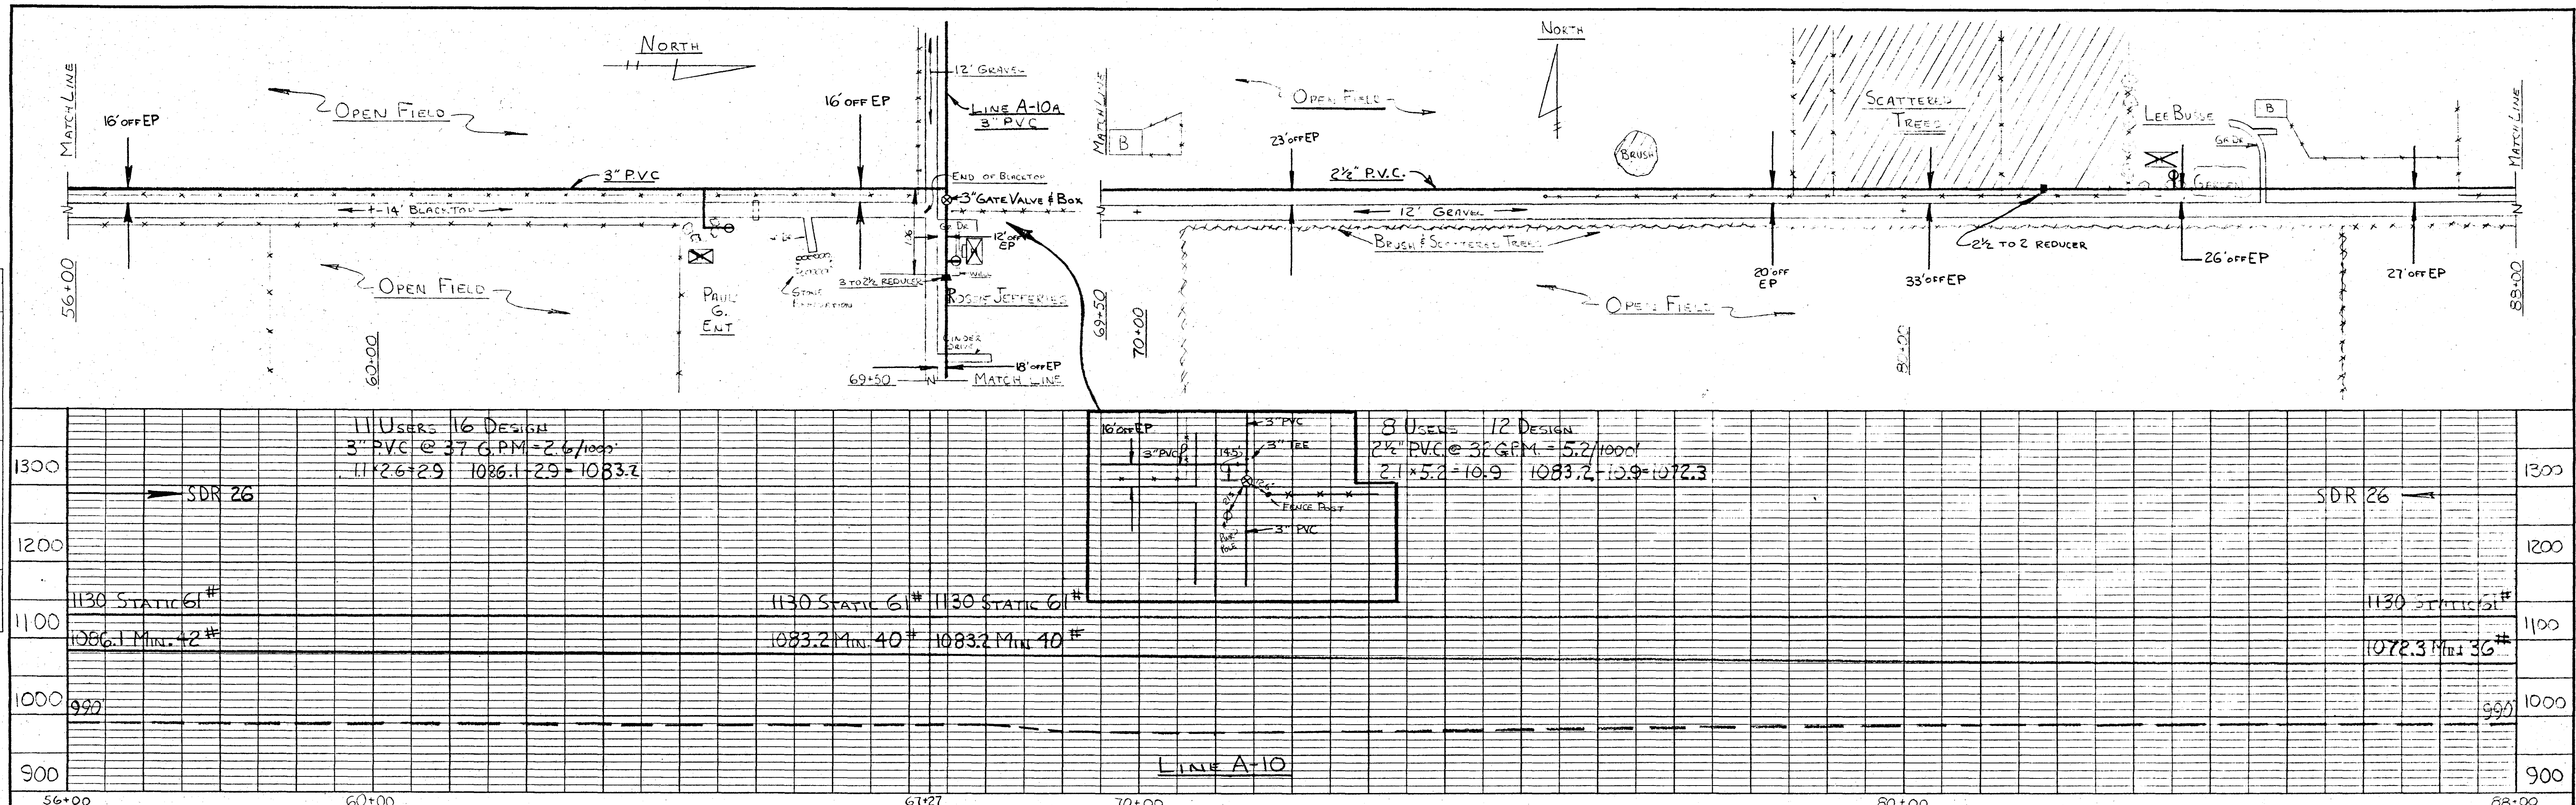

PROFILE	DATE	BY	NO.
SURVEYED			
NOTE BOOK			
GRADES CHECKED			
ST. ELEVATIONS CHECKED			

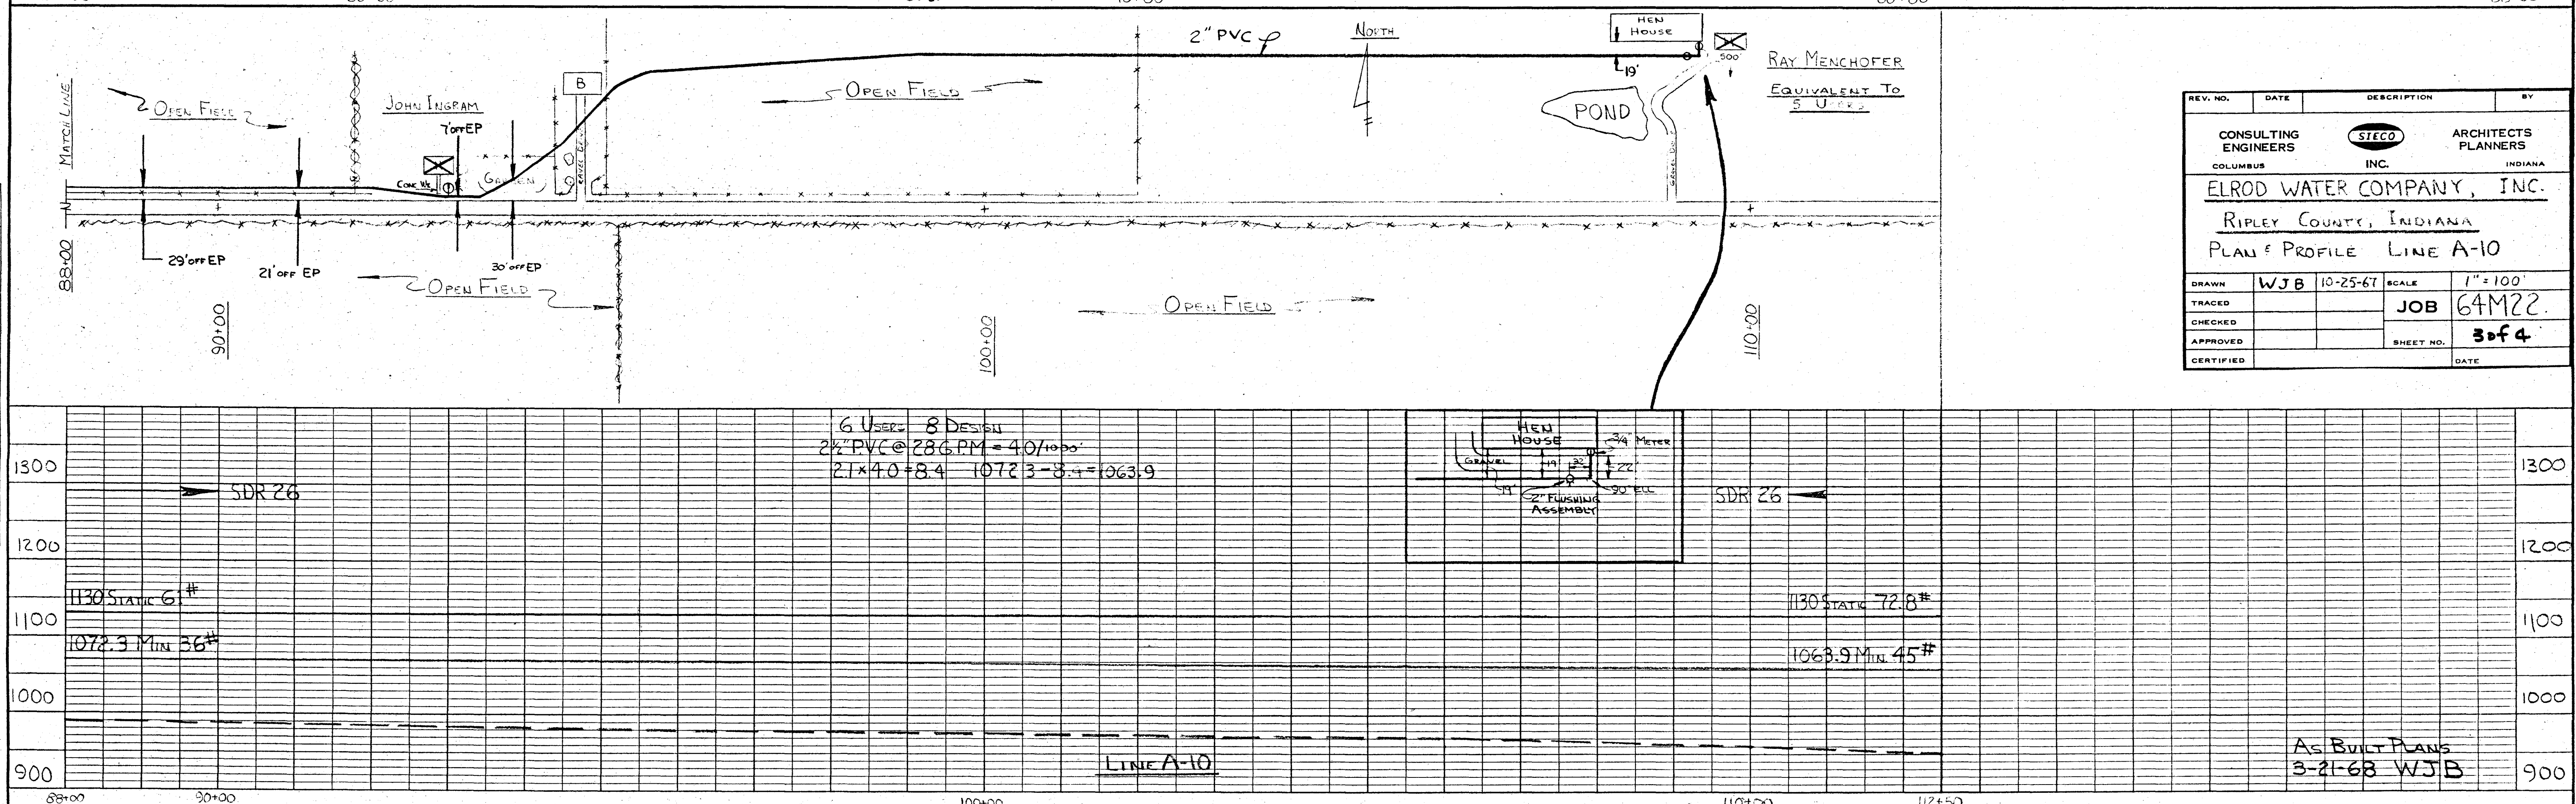

REV. NO.	DATE	DESCRIPTION	BY
1	10-25-67	ELROD WATER COMPANY, INC.	WJB
2	3-21-68	AS BUILT PLANS	WJB