


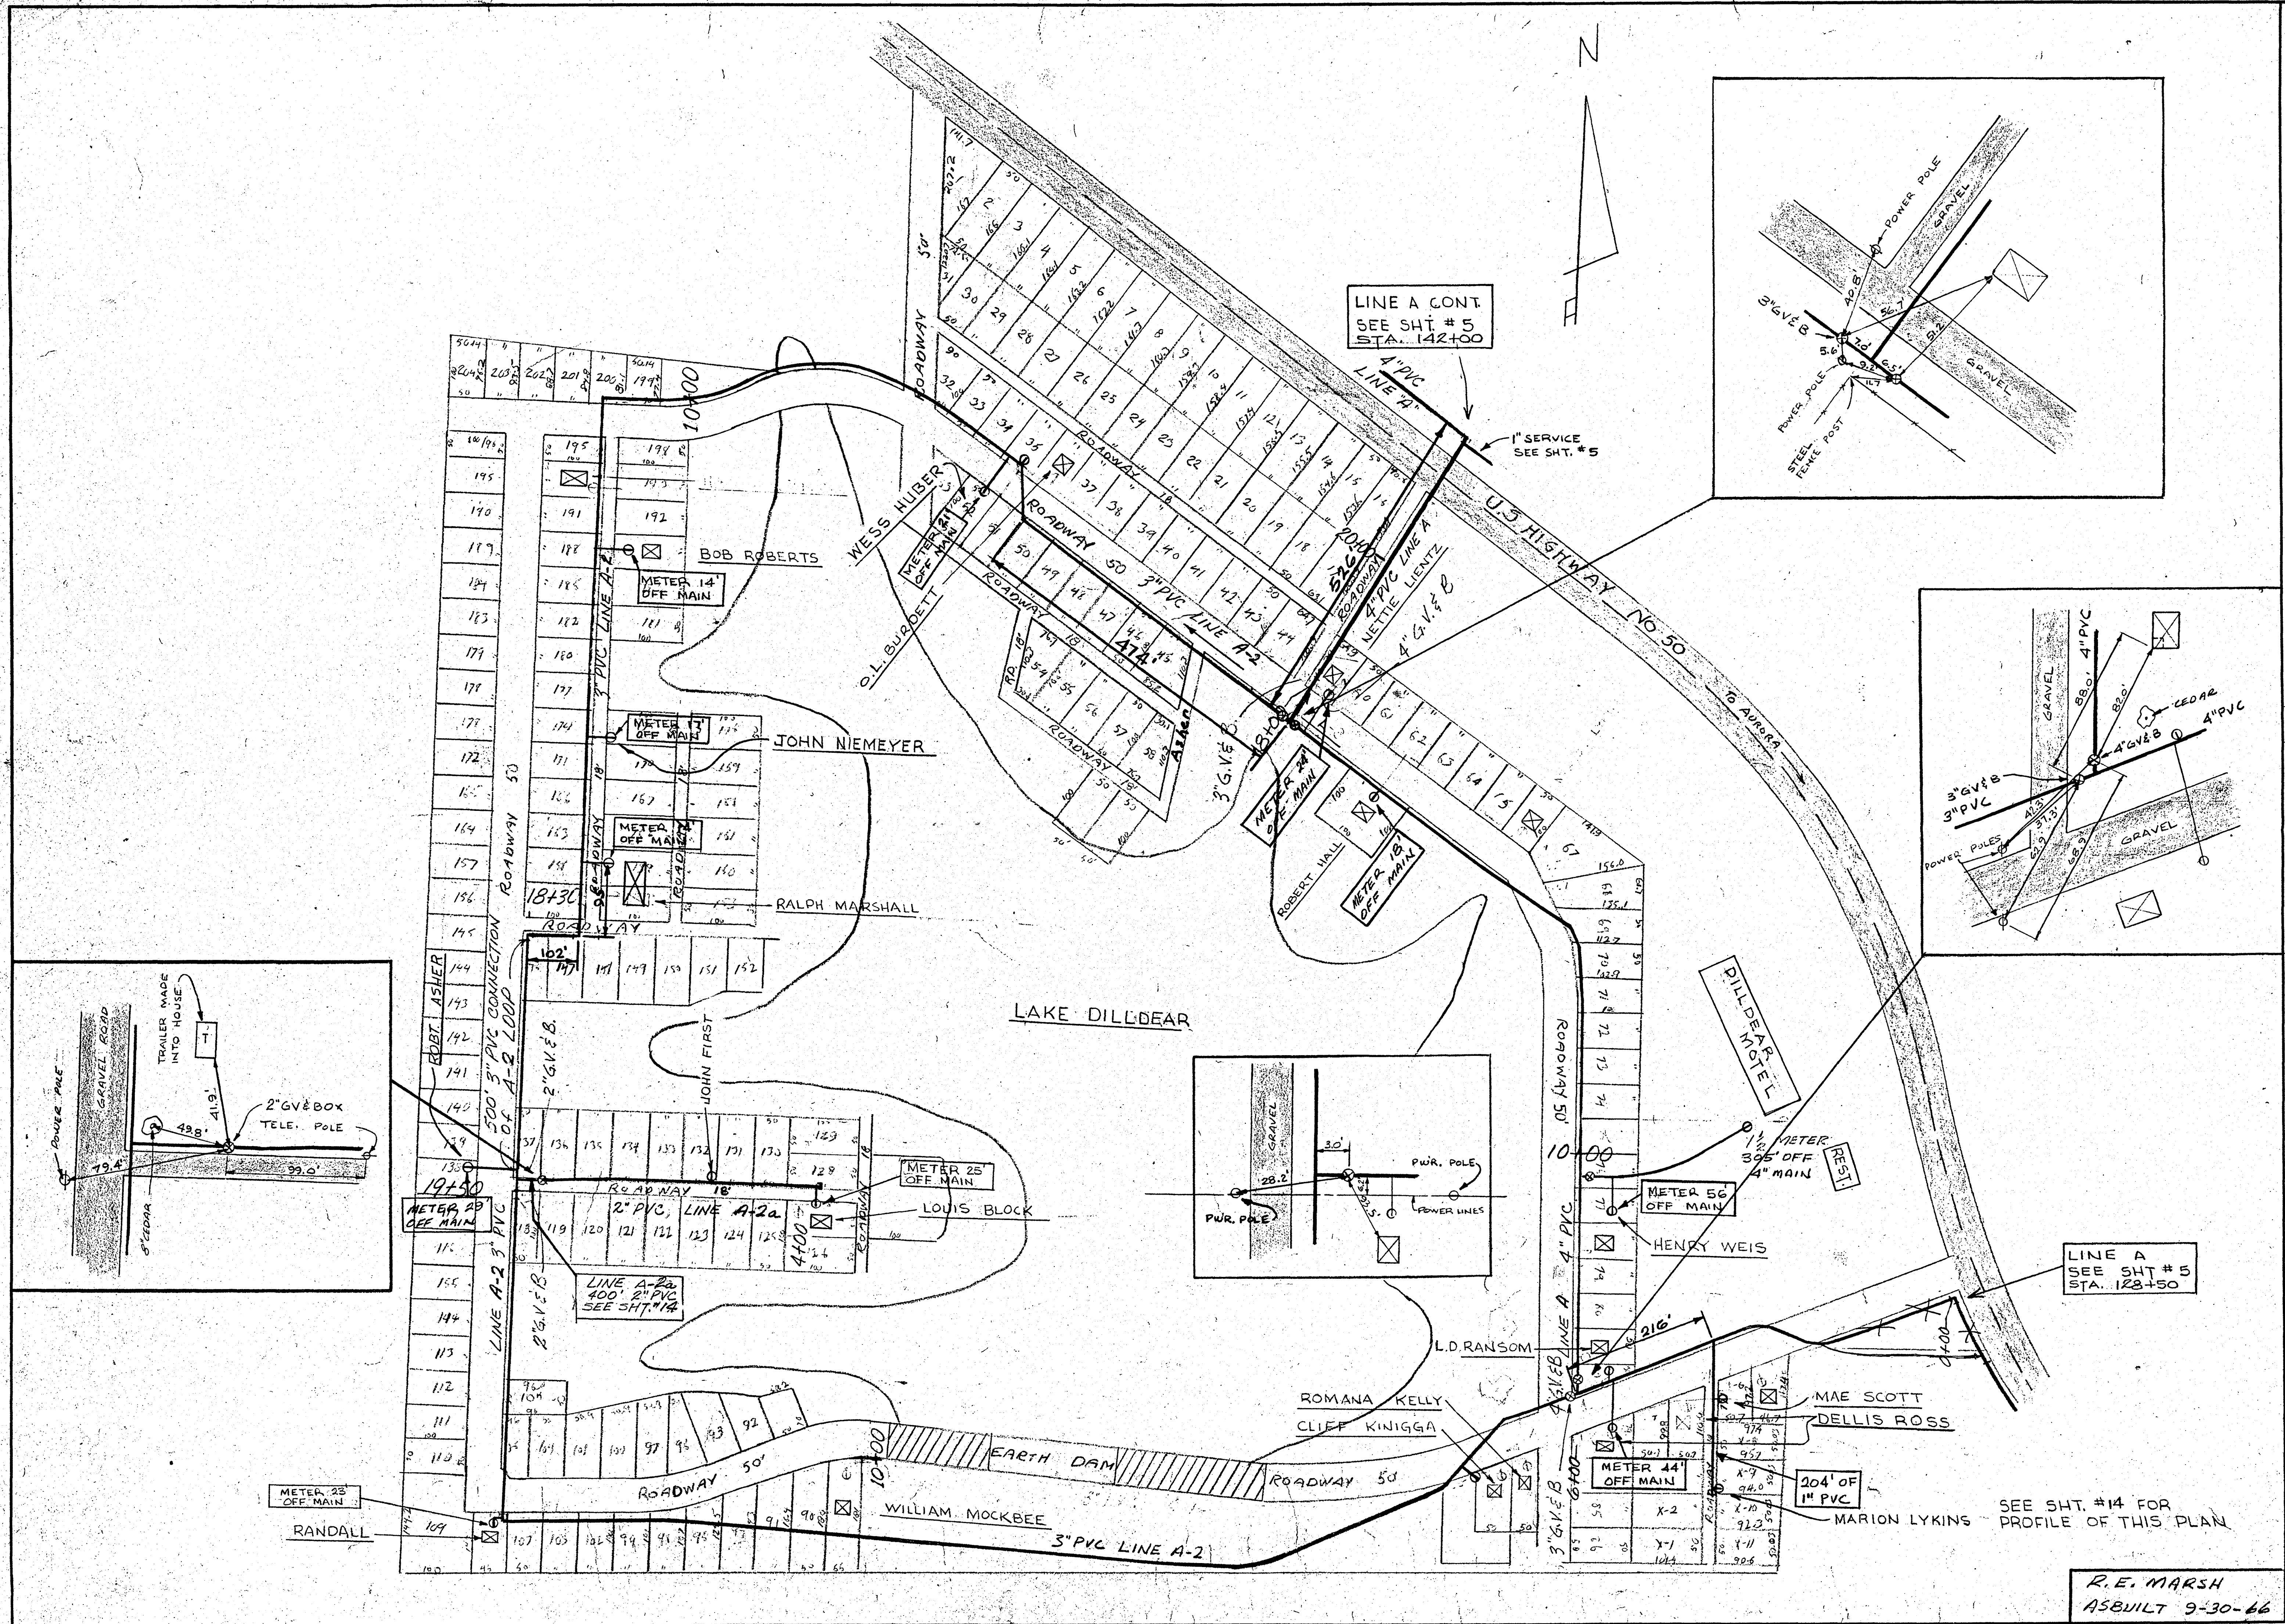

REV. NO.	DATE	DESCRIPTION

ELROD WATER CO. INC.
RIPLEY CO., INDIANA
PLAN LINE A-2, & A-2a.

SIECO, Inc. architects-engineers COLUMBUS MADISON BLOOMINGTON	
JOB NO.	64M22
DATE	2-18-66
DRAWN	AGH & SWT
CHECKED	
CERTIFIED	
SCALE	
SHEET	13 OF 30

R.E. MARSH
ASBUILT 9-30-66

SEE SHT. #14 FOR
PROFILE OF THIS PLAN