




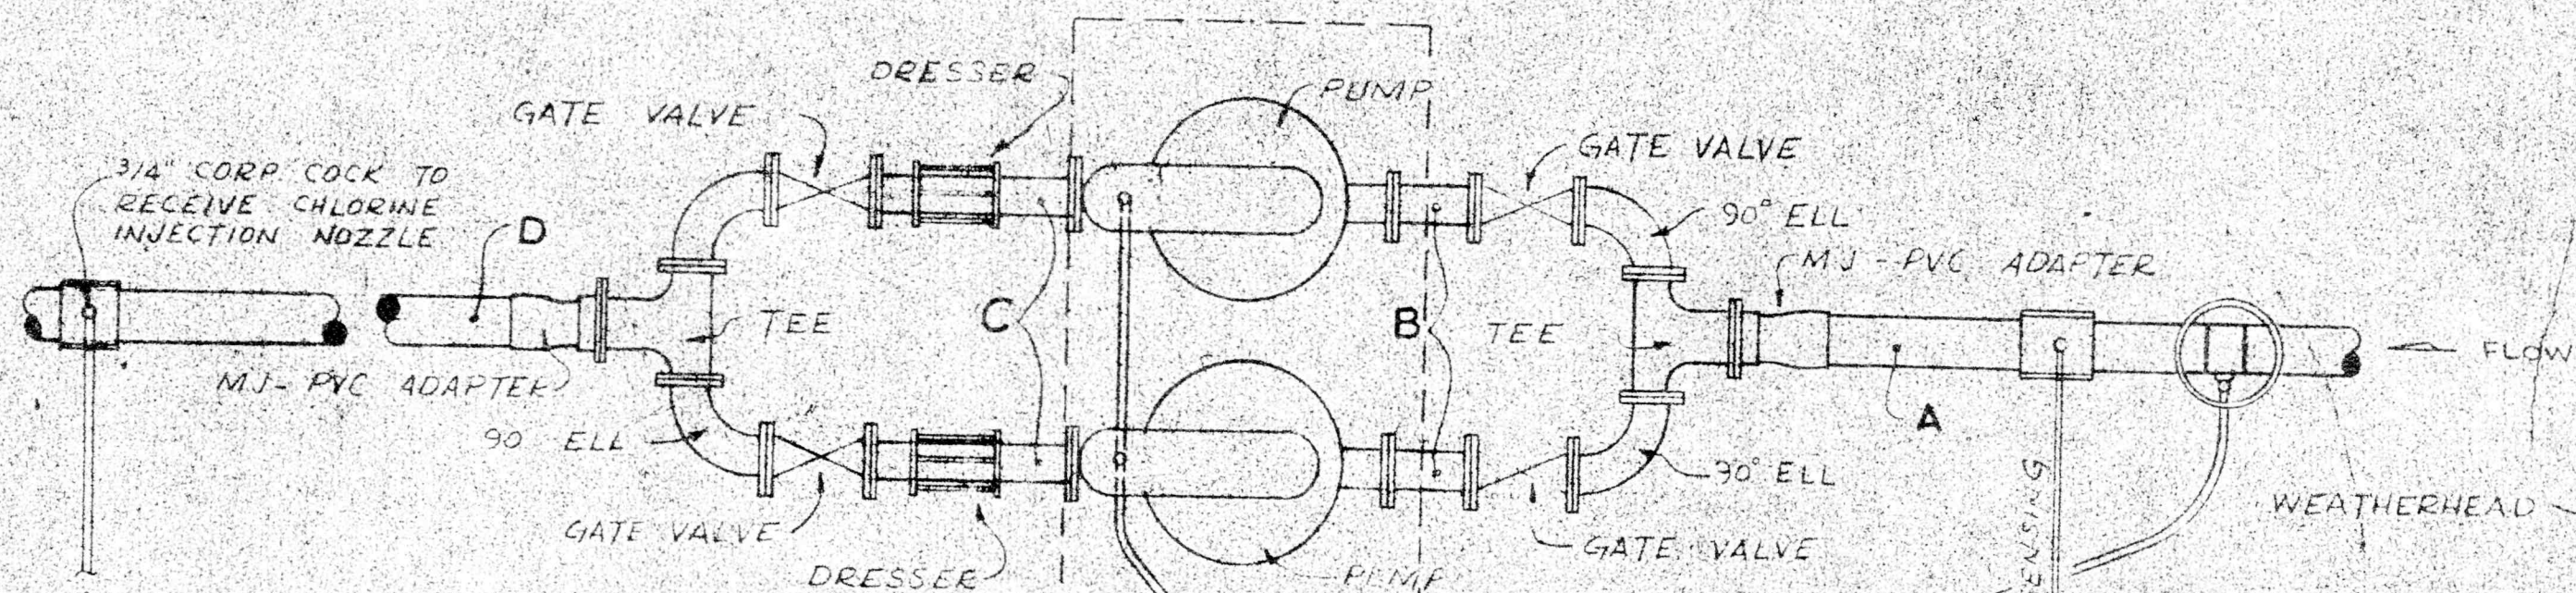


50' FROM CHLORINE INJECTION PIT TO
TAP FOR CHLORINE SAMPLING LINE

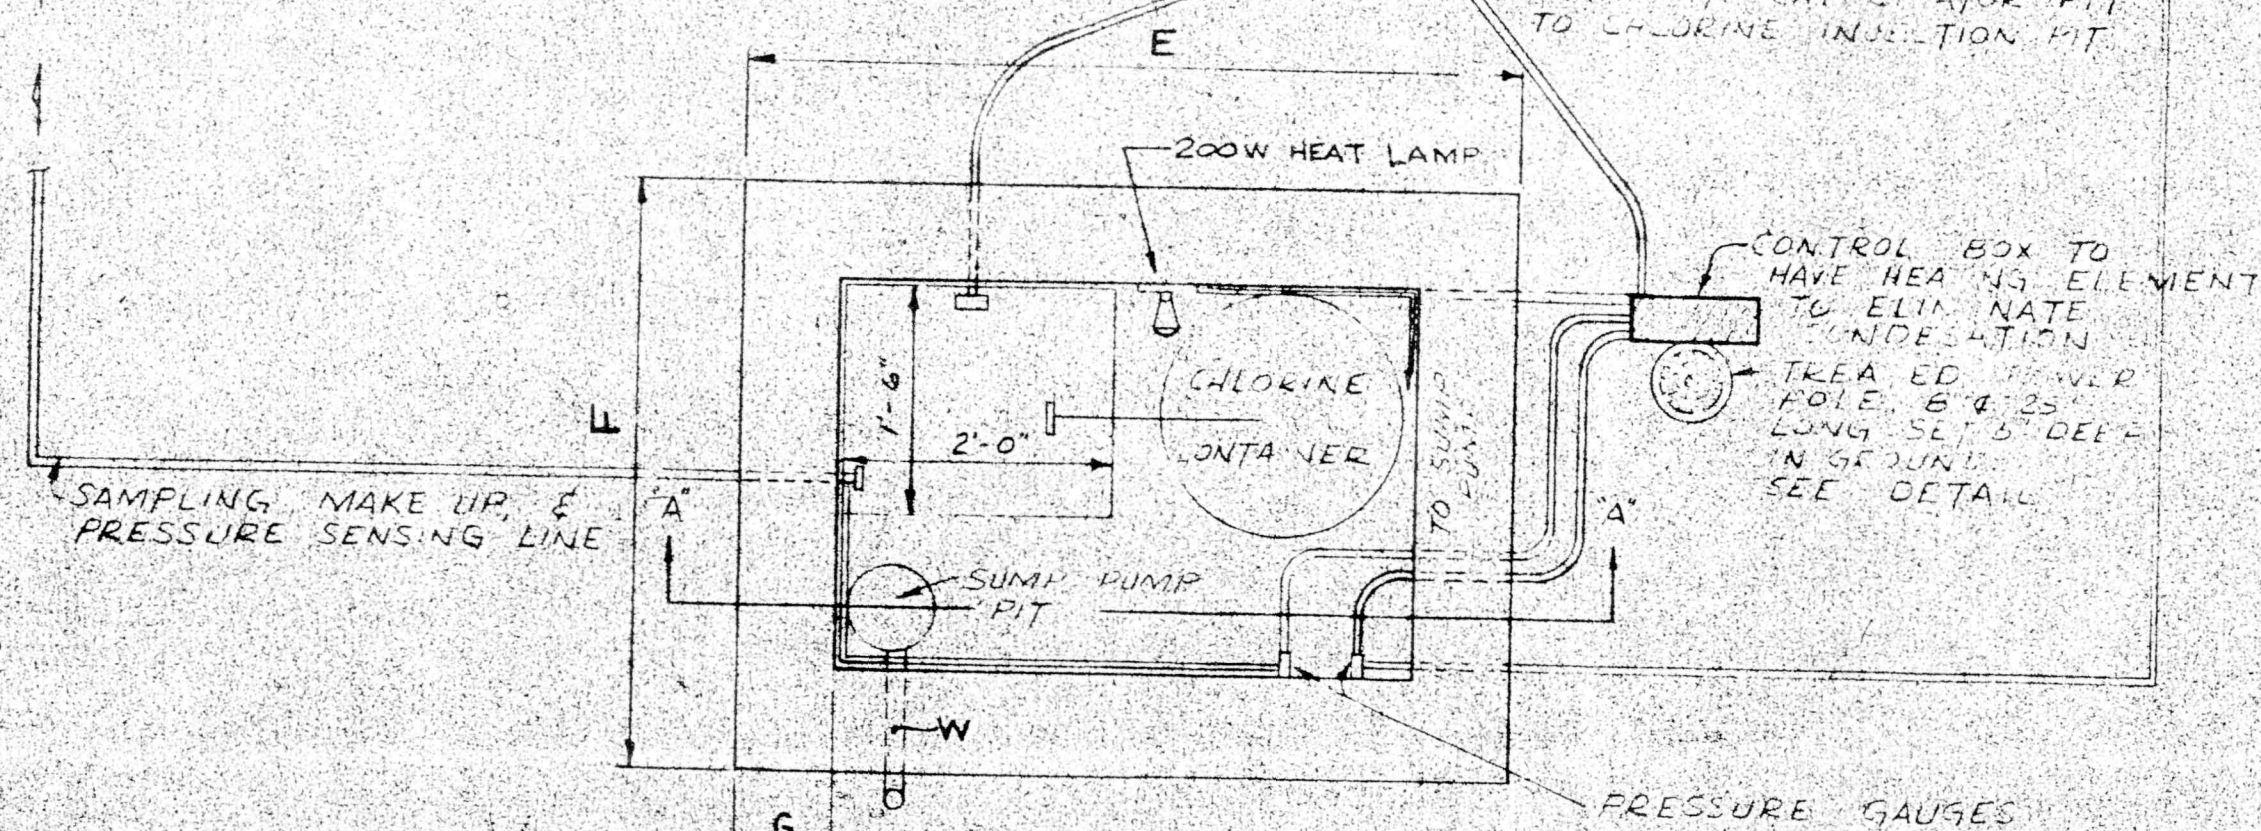


CHLORINATION PIT DETAILS
PLAN VIEW
NO SCALE

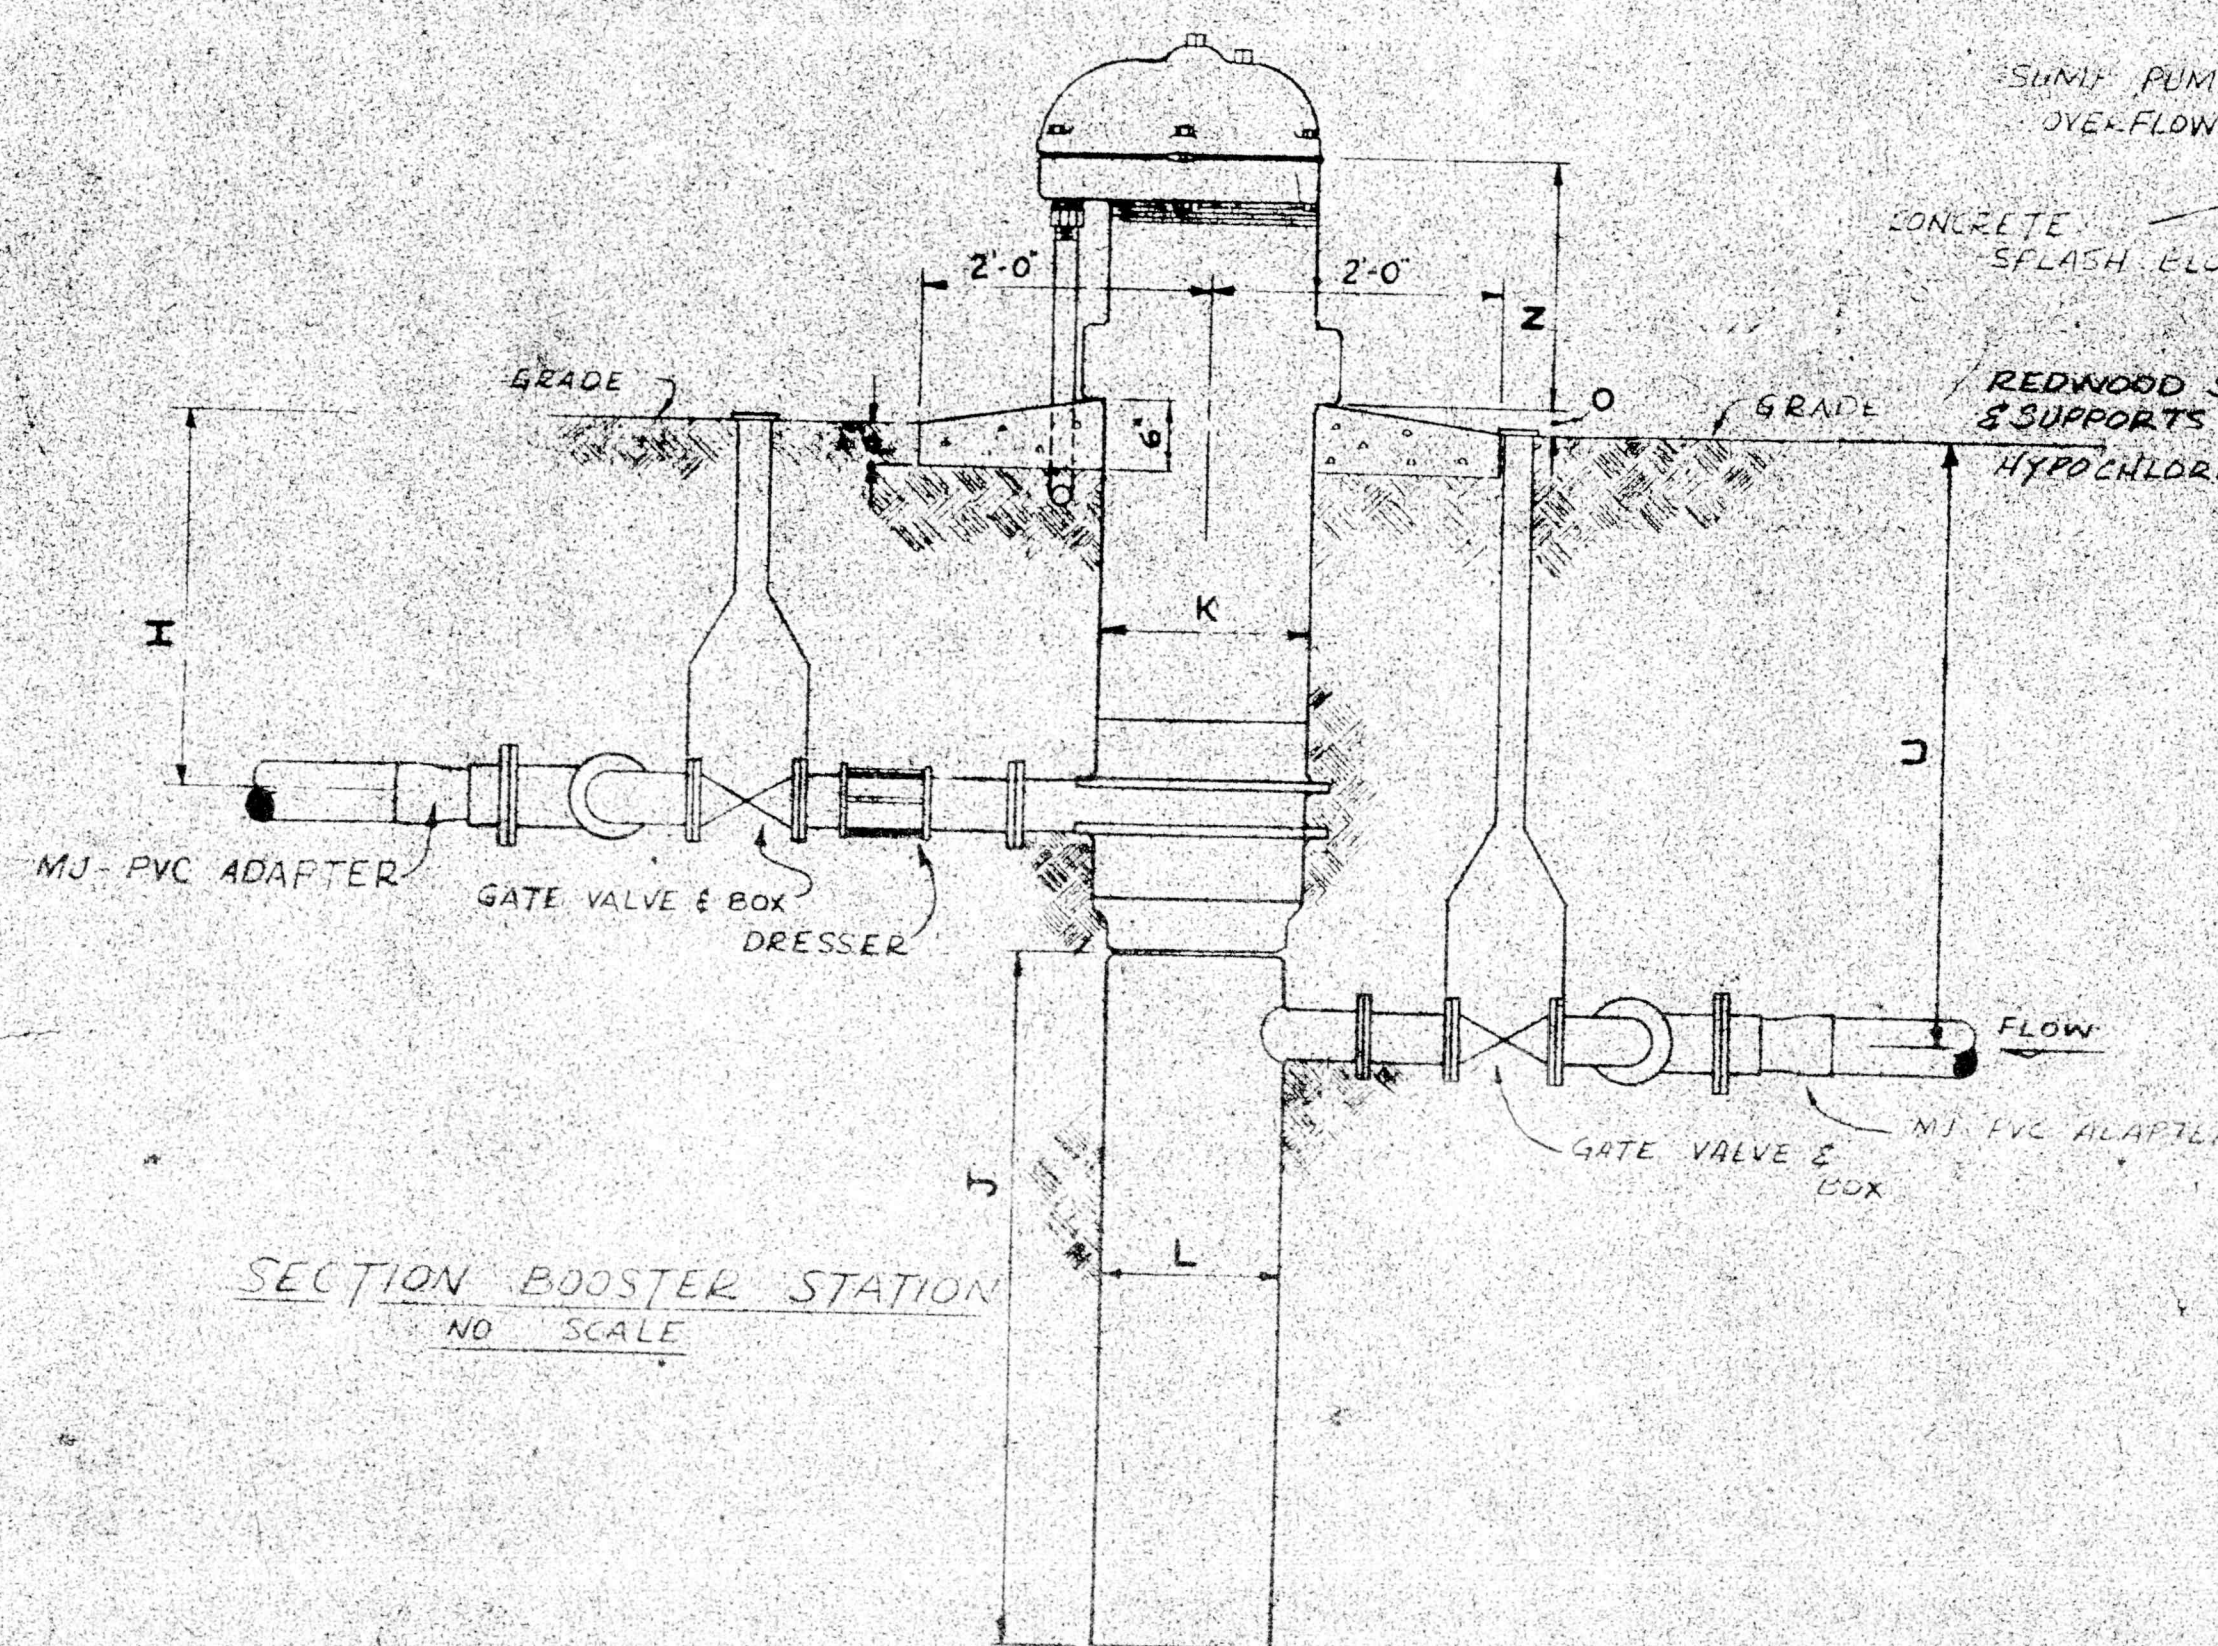

SECTION BOOSTER STATION
NO SCALE

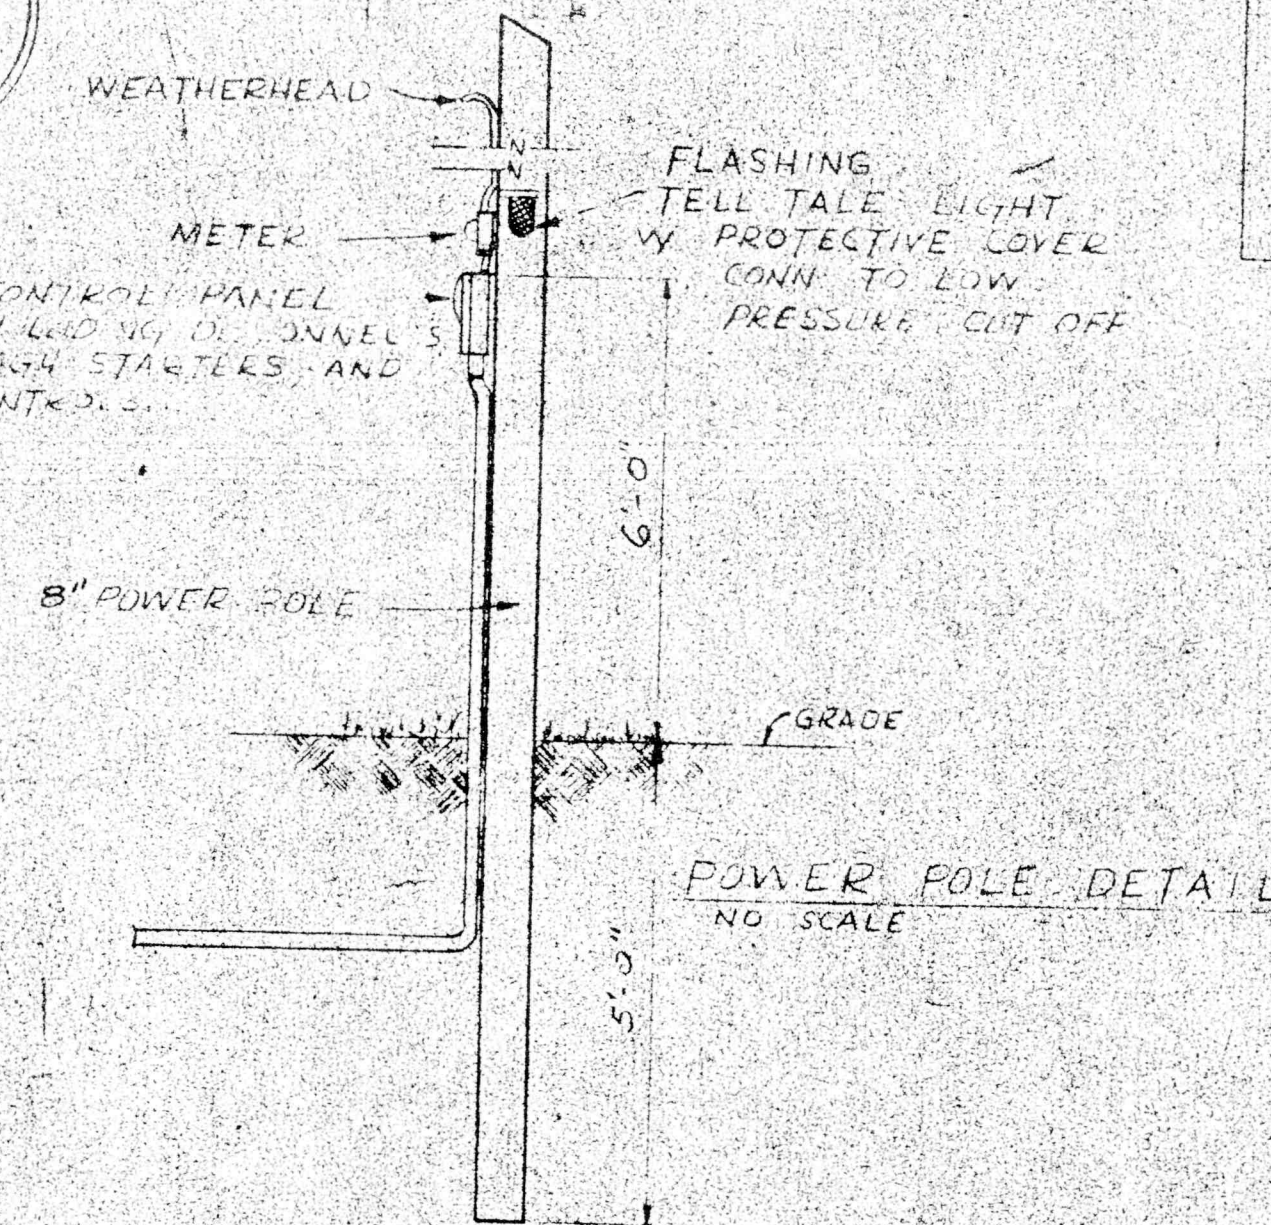


POWER POLE DETAIL
NO SCALE

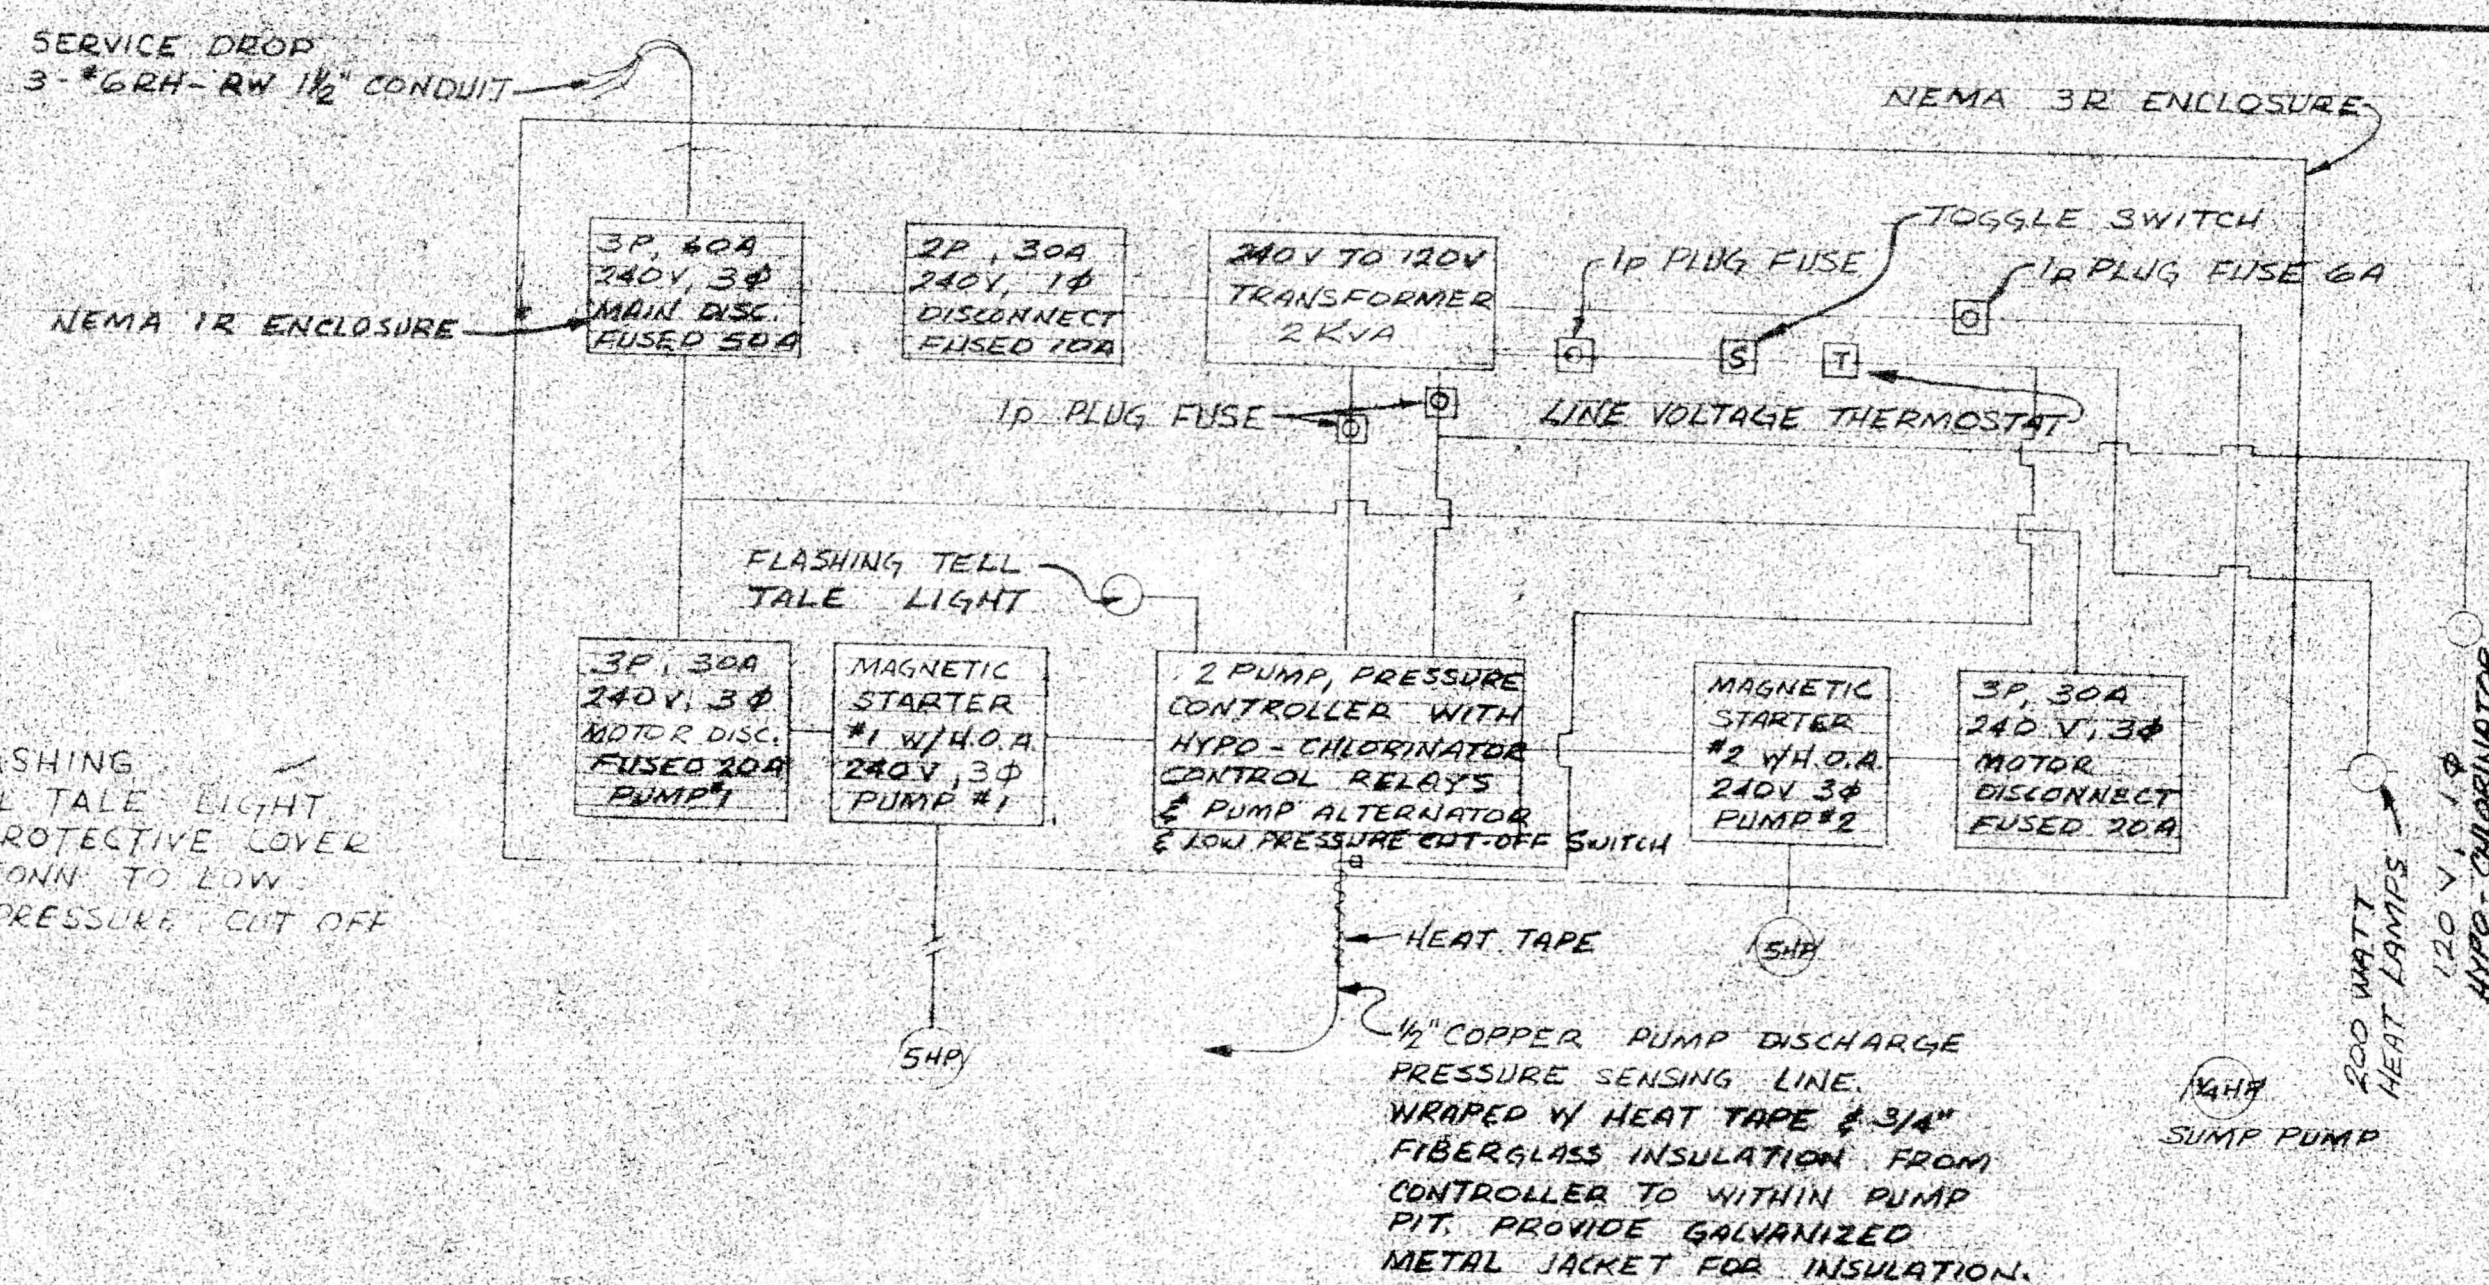

- ELECTRICAL NOTES
1. ALL FUSES TO BE BUSSMAN "LOW PEAK"
 2. MINIMUM WIRE SIZE - #12, AWG.
 3. ALL CONDUIT TO BE GALVANIZED RIGID STEEL W/ WATER TIGHT CONNECTION.
 4. ENTRANCE GROUND AS REQUIRED BY THE LOCAL POWER SUPPLIER.
 5. SYSTEM GROUND: CONDUIT & NEUTRAL WIRE.

ELECTRICAL SCHEMATIC

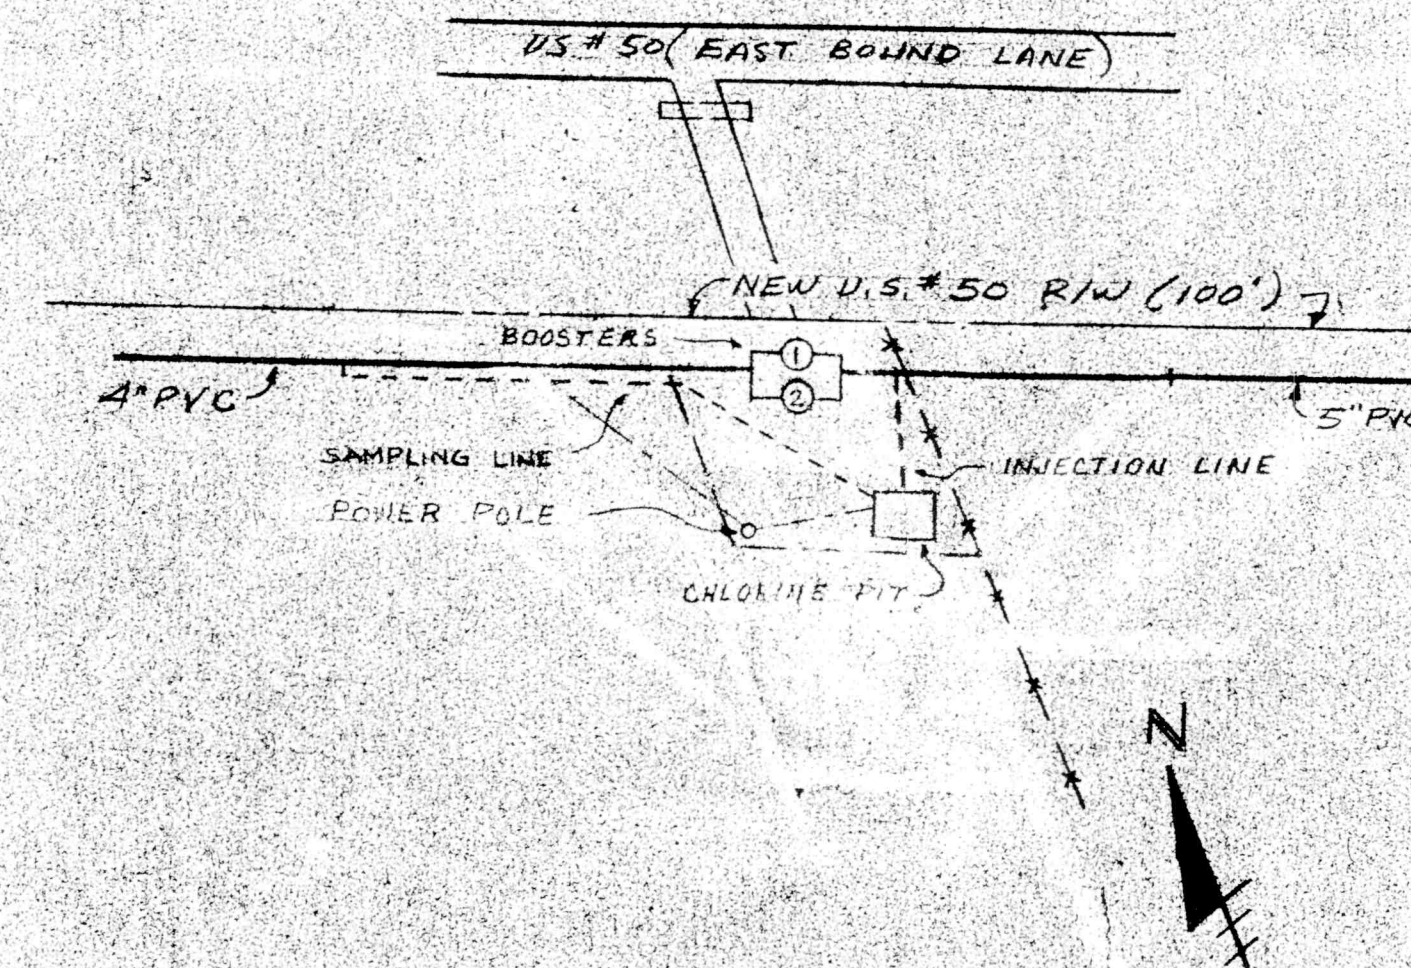

PLOT PLAN

- NOTES
1. ALL PIPING 3\"/>

CHLORINE INJECTION PIT
SECTION

NOTES & SYMBOLS	
DIMENSION SCHEDULE	
A	5\"/>

ELROD WATER CO.
RIPLEY COUNTY, INDIANA
BOOSTER PUMPING STATION

SIECO, Inc.
architects
engineers

COLUMBUS
MADISON
BLOOMINGTON

JOB NO.	24422
DATE	9/26/66
DRAWN	REN
CHECKED	
CERTIFIED	
SCALE	

R.E. MARSH
ASBUILT 9-30-66 SHEET 29 OF 30