
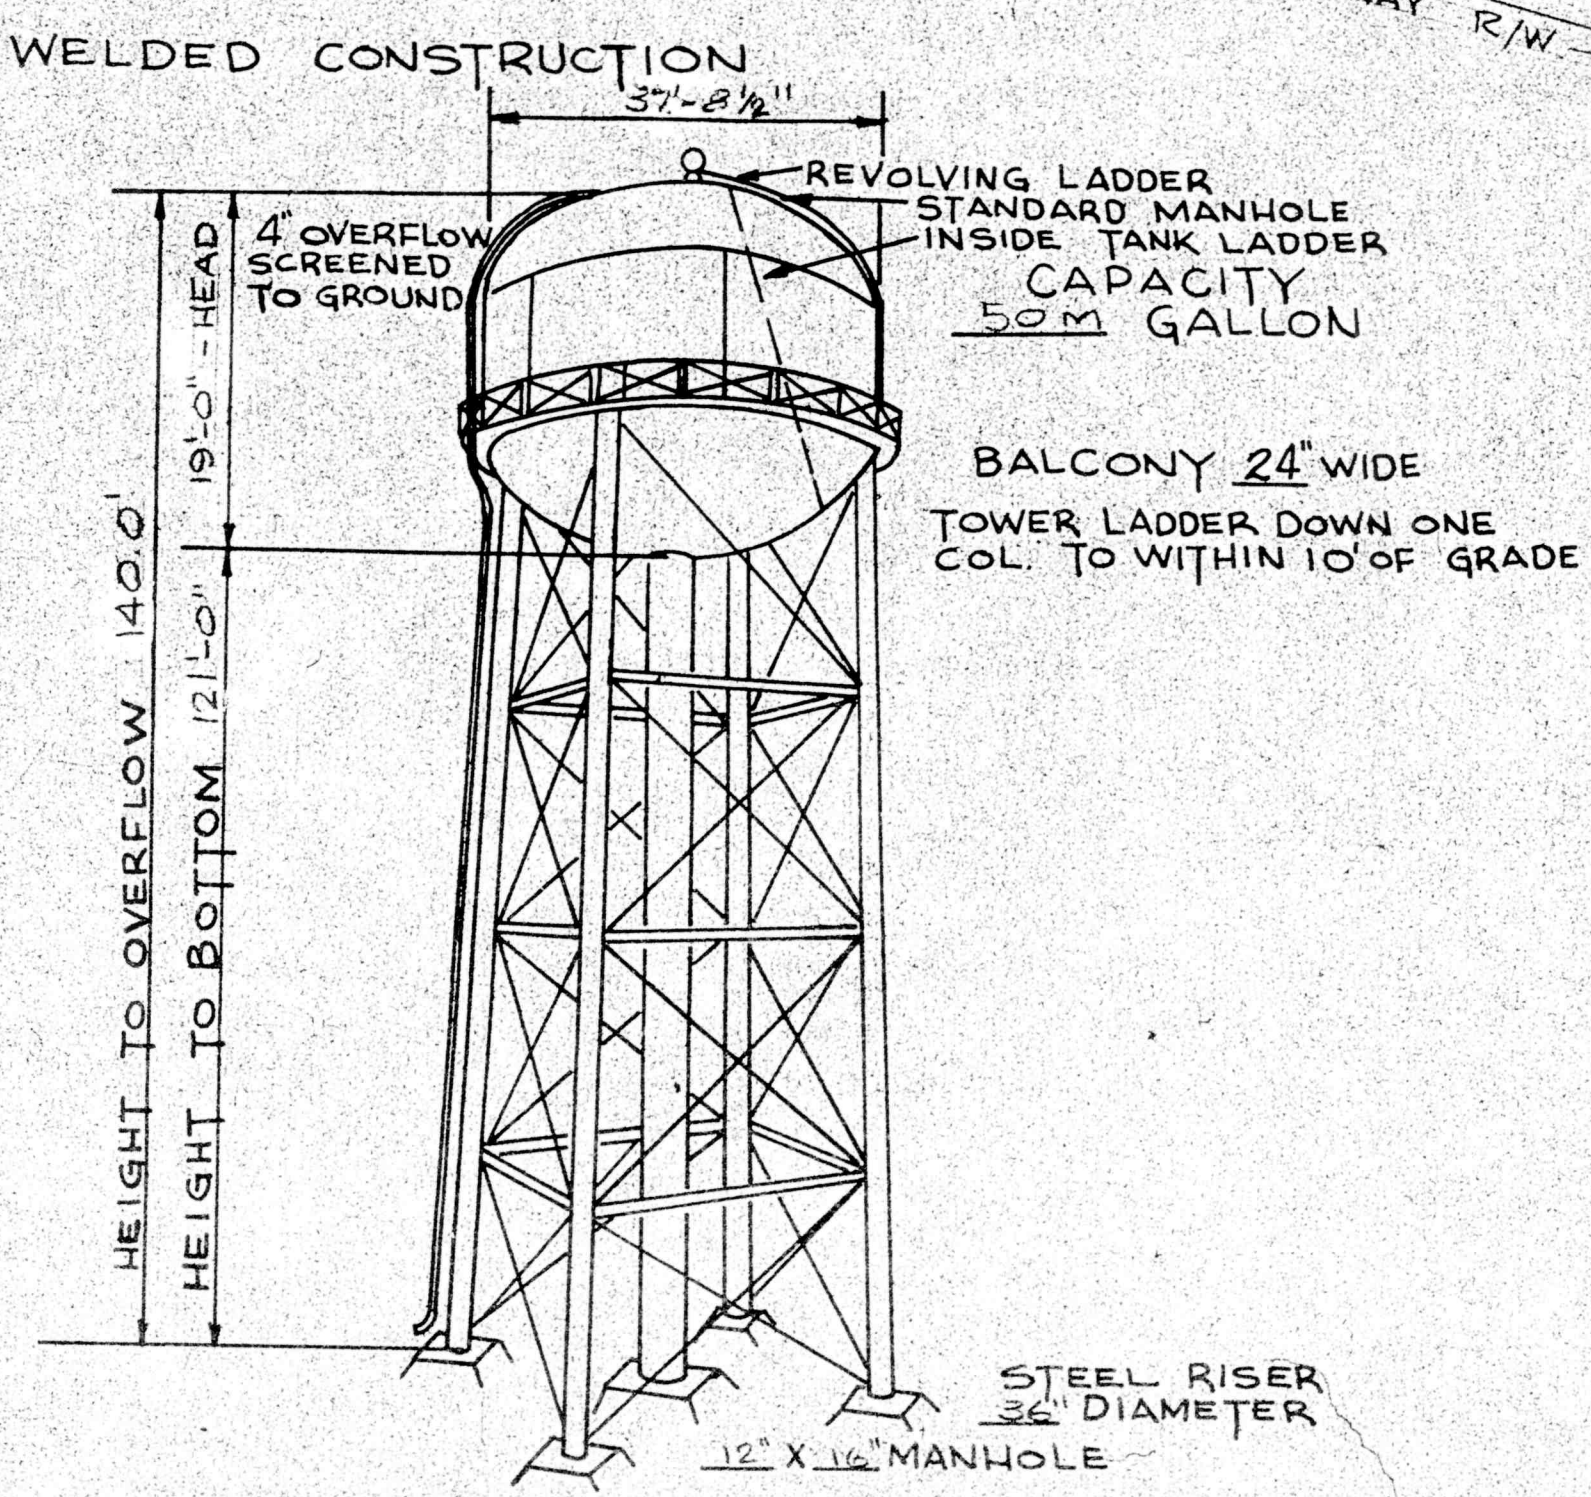
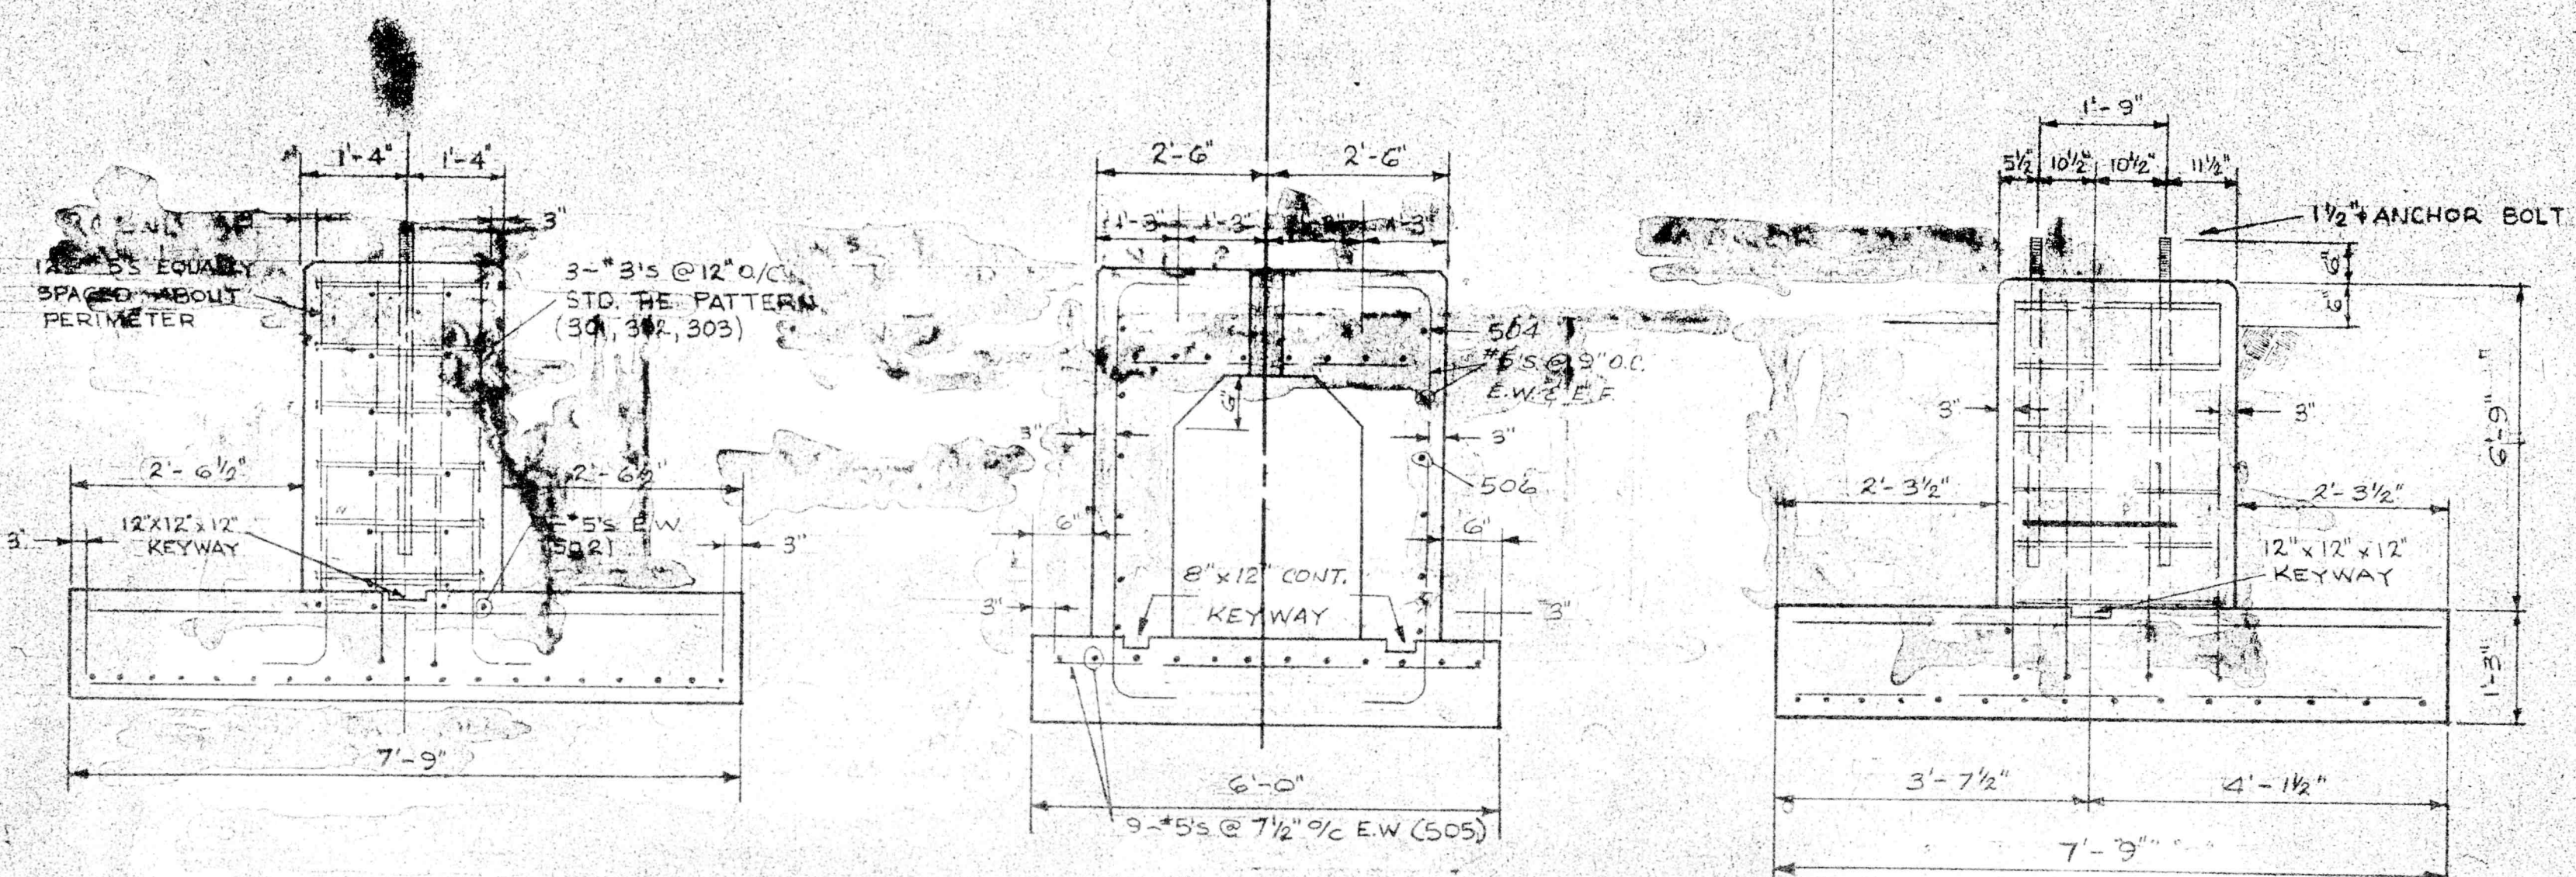
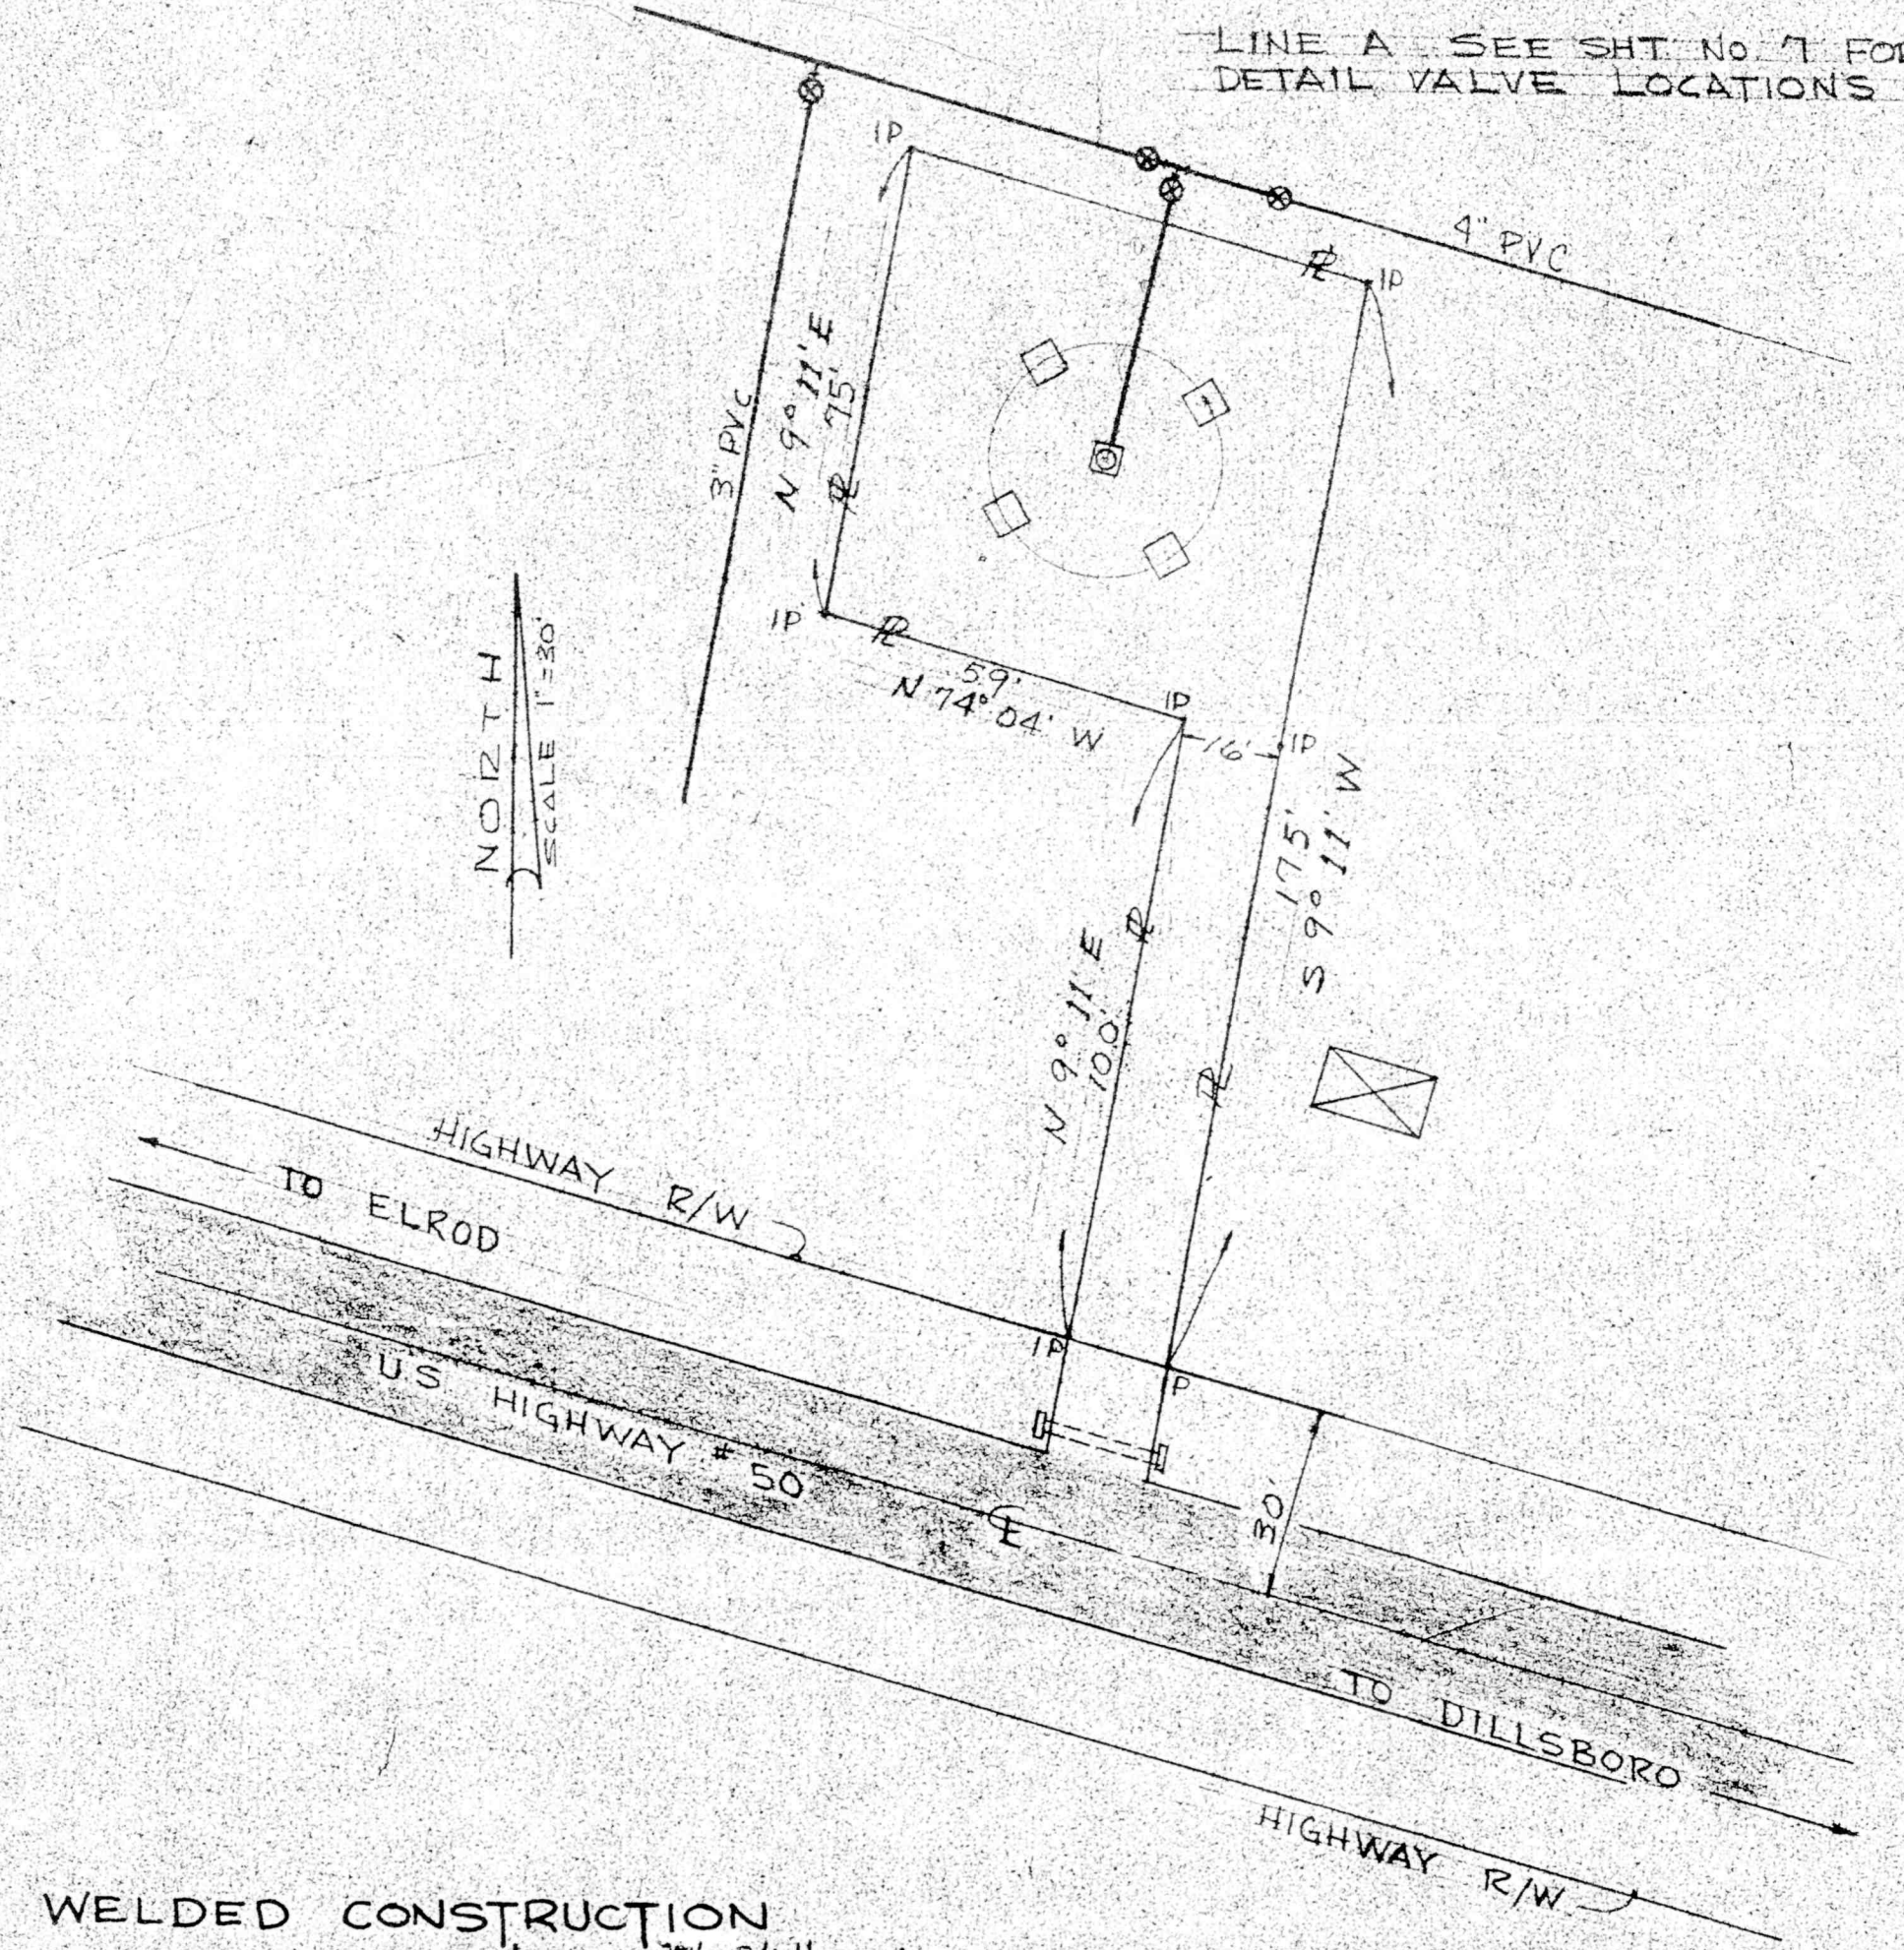
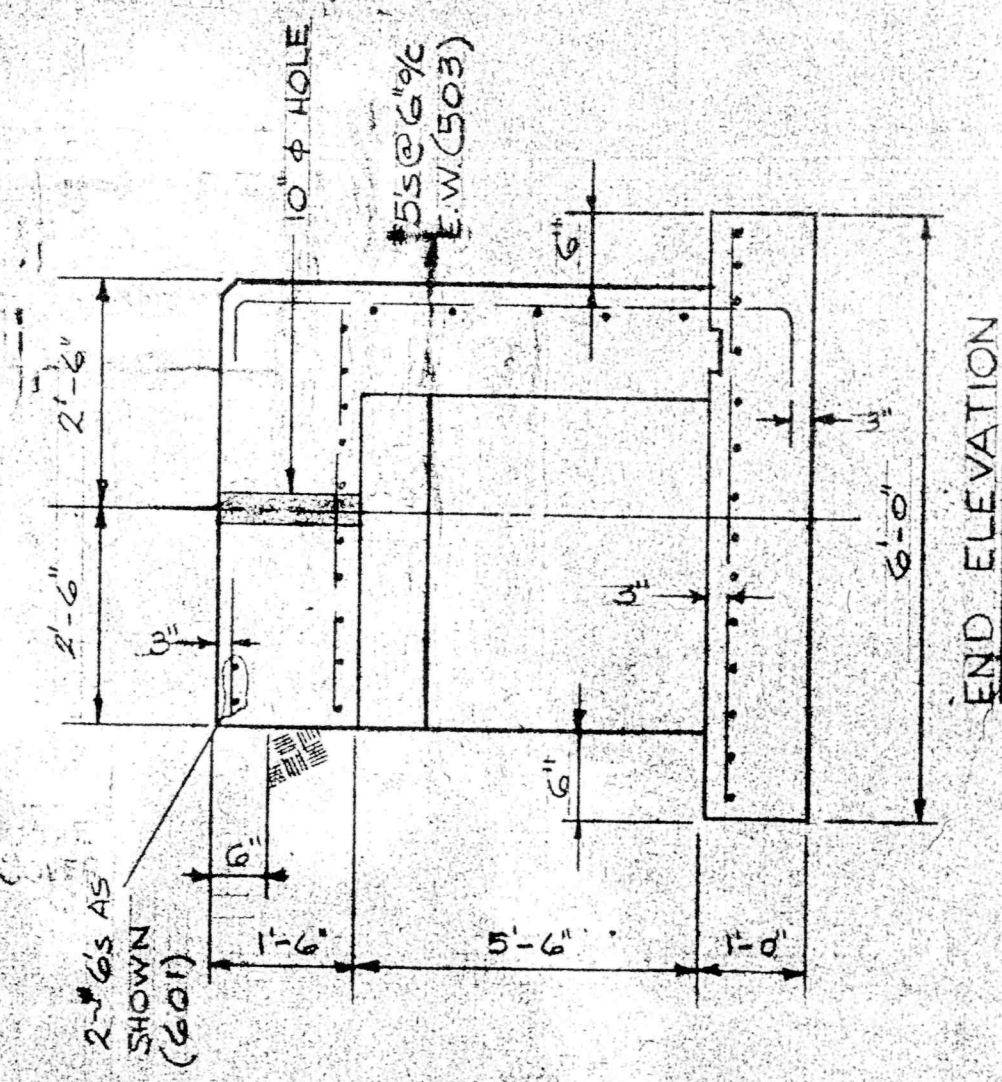


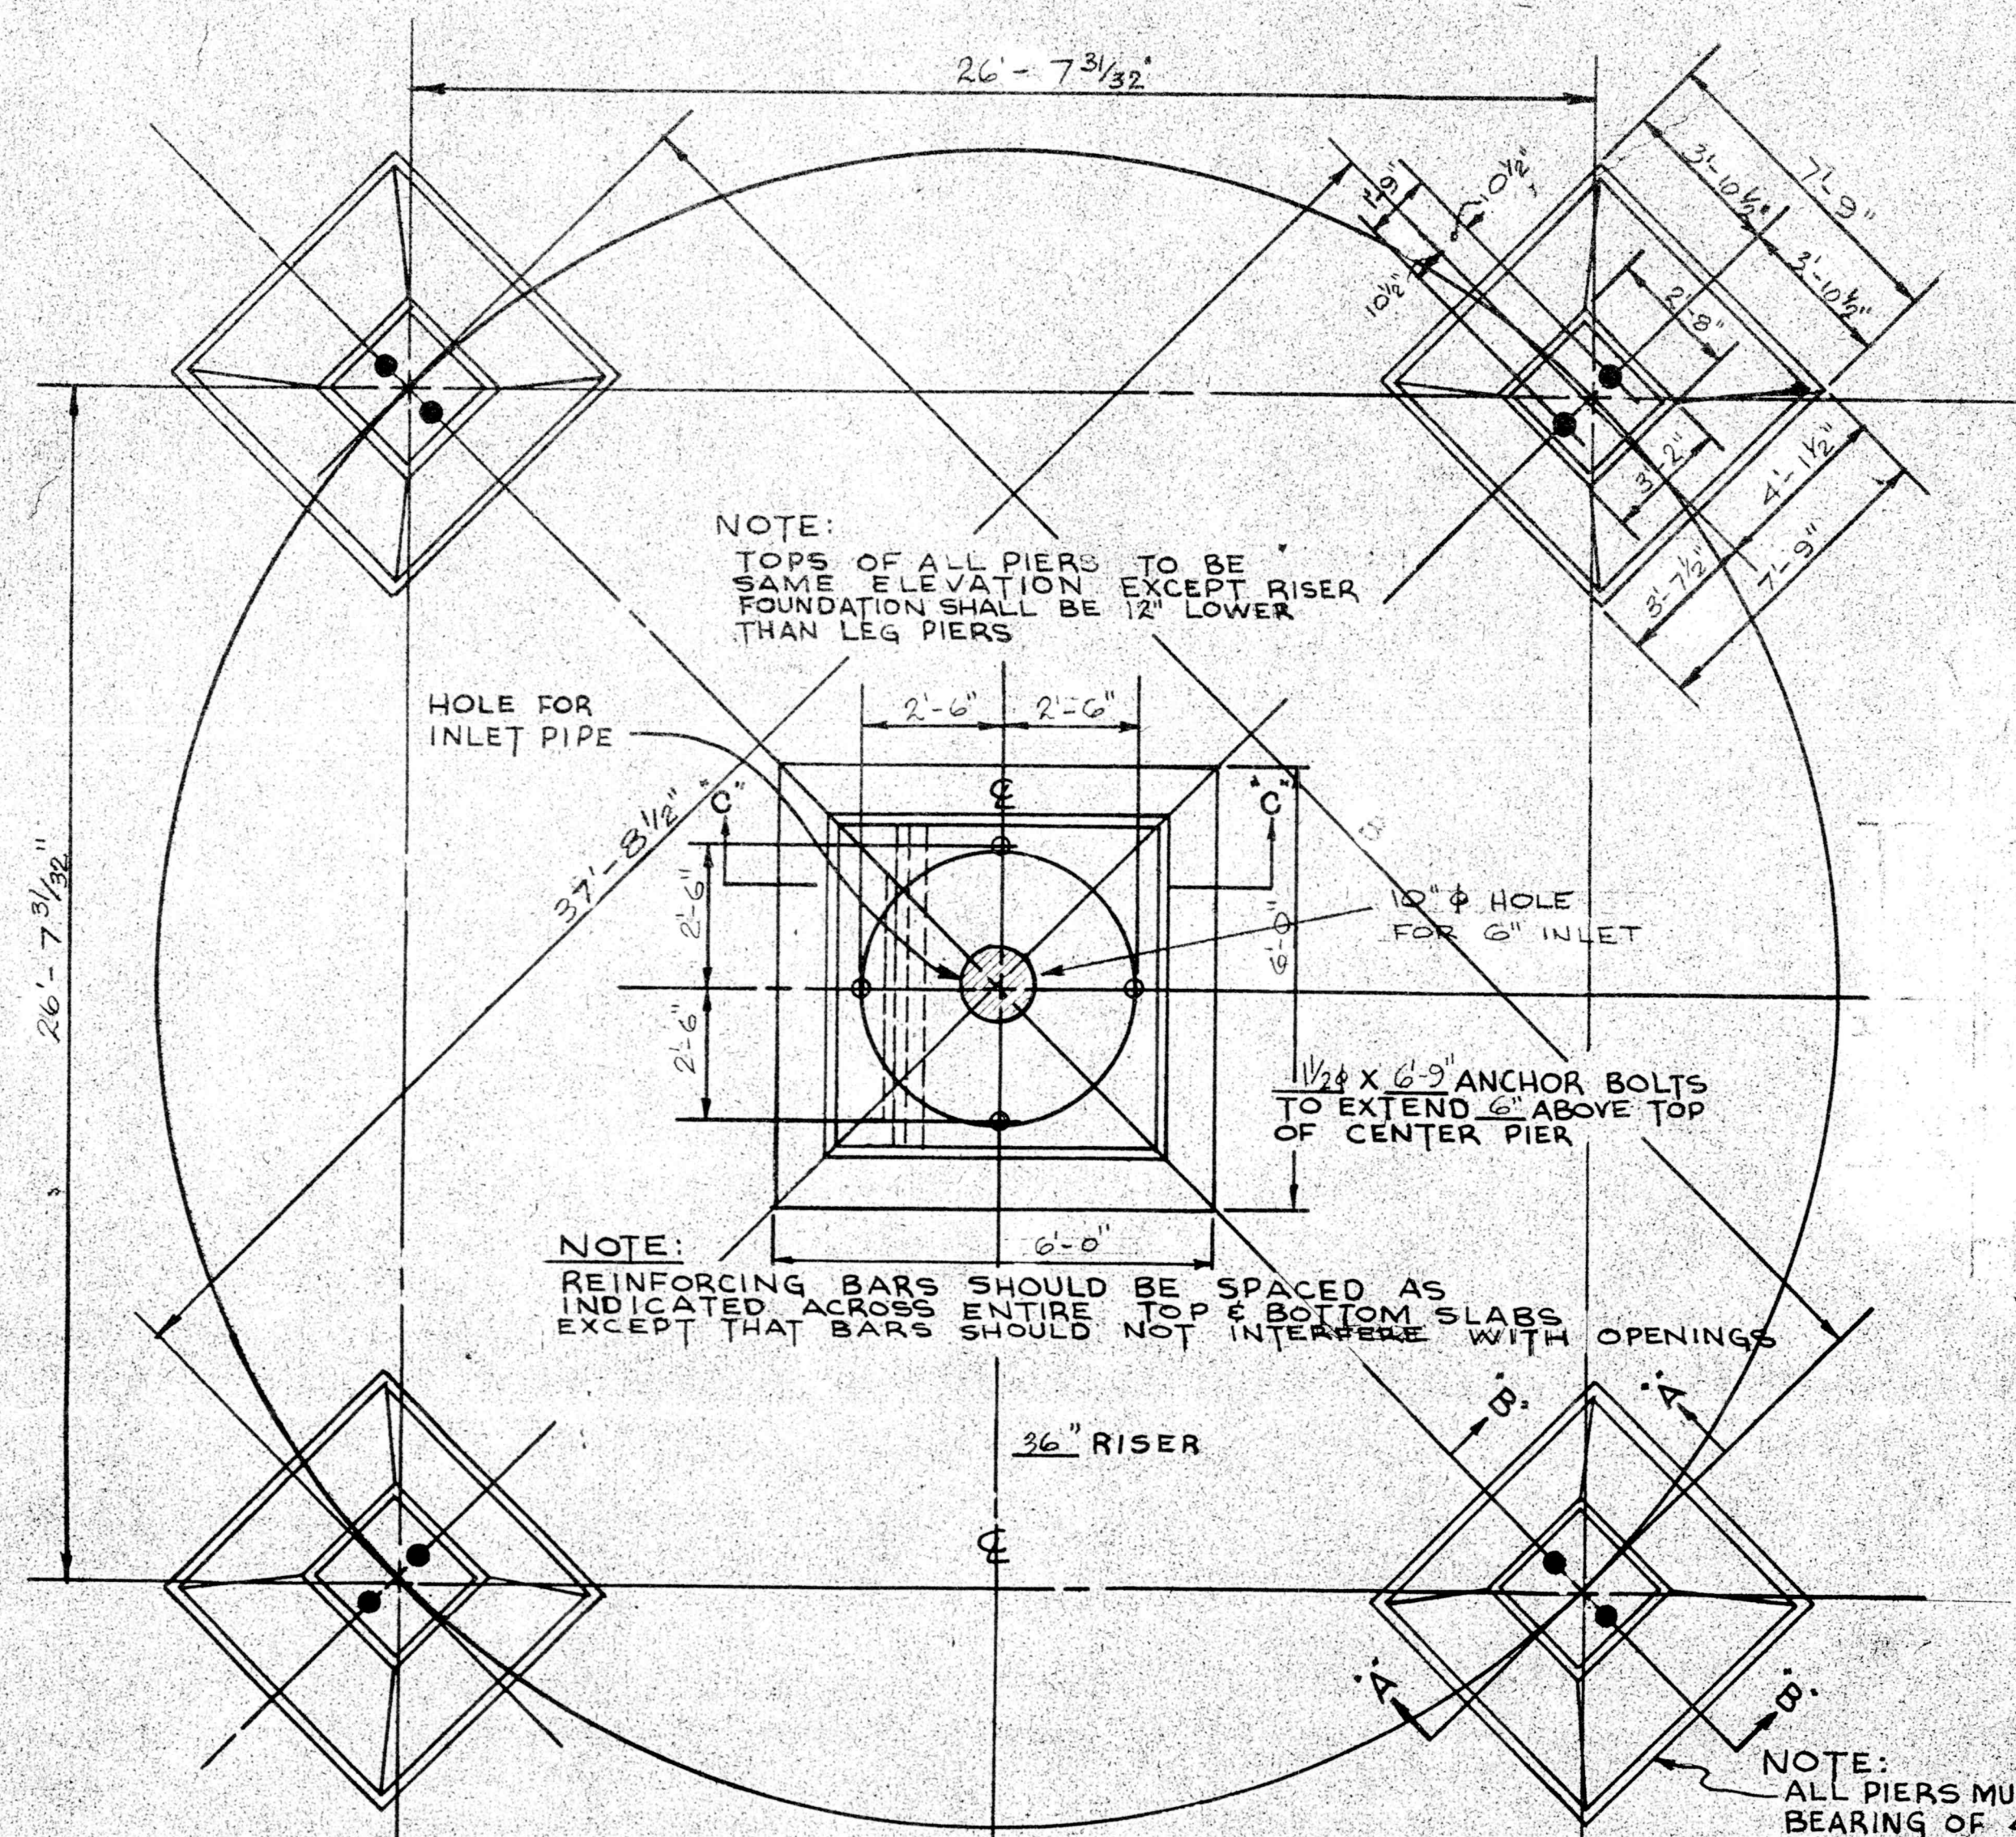

ELEVATED STORAGE TANK

NO SCALE

ELEVATED STORAGE FOUNDATIONS

NO SCALE

NOTES & SYMBOLS	
ELROD WATER CO.	BY
RIPLEY COUNTY, INDIANA	DESCRIPTION
FOUNDATION DETAILS FOR 500 GAL. ELEVATED STOR. TANK	REV. NO. DATE
SIECO, Inc.	architects
engineers	
COLUMBUS	
MADISON	
BLOOMINGTON	
JOB NO. 64M52	
DATE LAB	
DRAWN 9-30-66	
CHECKED	
CERTIFIED	
SCALE	
SHEET 30 OF 30	

R.E. MARSH

ASBUILT 9-30-66