



HOOSIER HILLS REGIONAL WATER DISTRICT LOOKOUT ROAD WATER MAIN EXTENSION

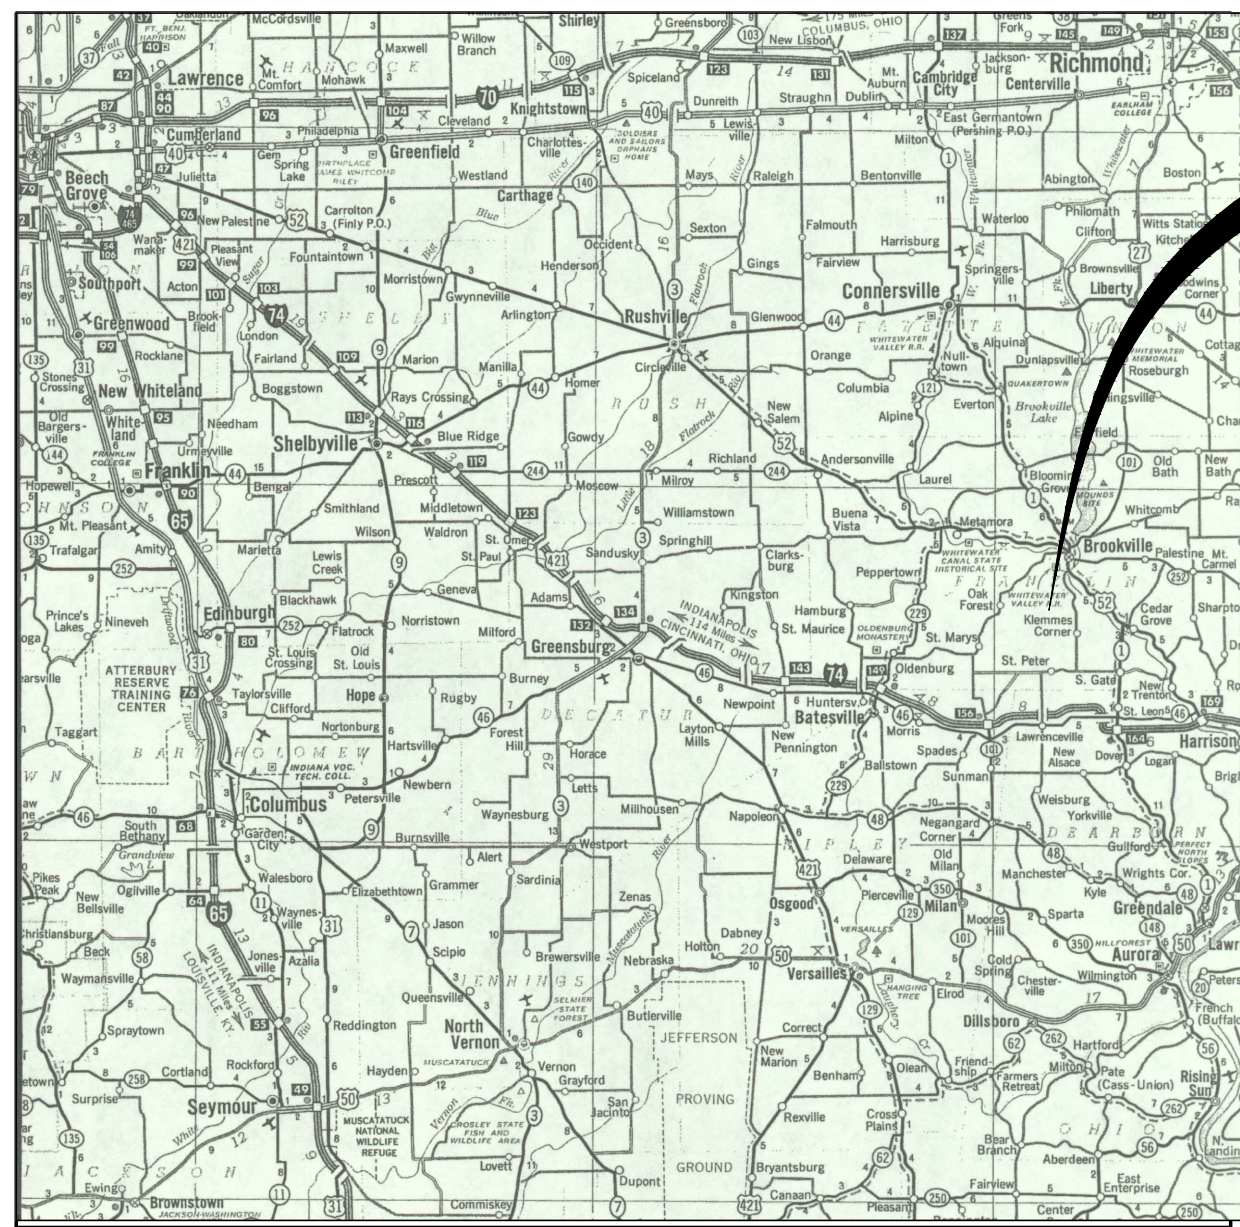

VICINITY MAP

PROJECT LOCATION


PROJECT LOCATION

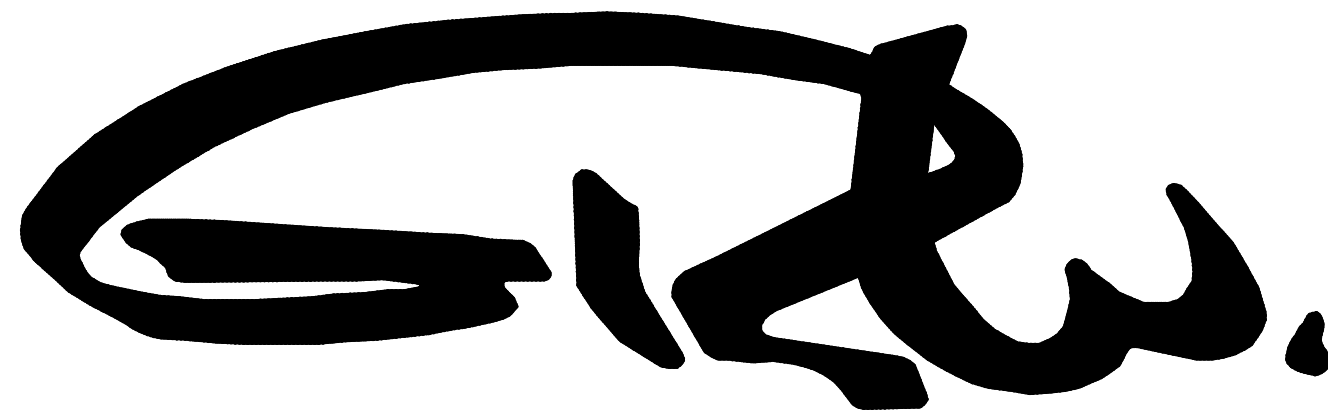

GRW Engineers, Inc.


7112 Waldemar Drive
Indianapolis, Indiana 46268
(317) 347-3650

INDIANAPOLIS, INDIANA
LOUISVILLE & LEXINGTON, KENTUCKY
CINCINNATI, OHIO
NASHVILLE, TENNESSEE

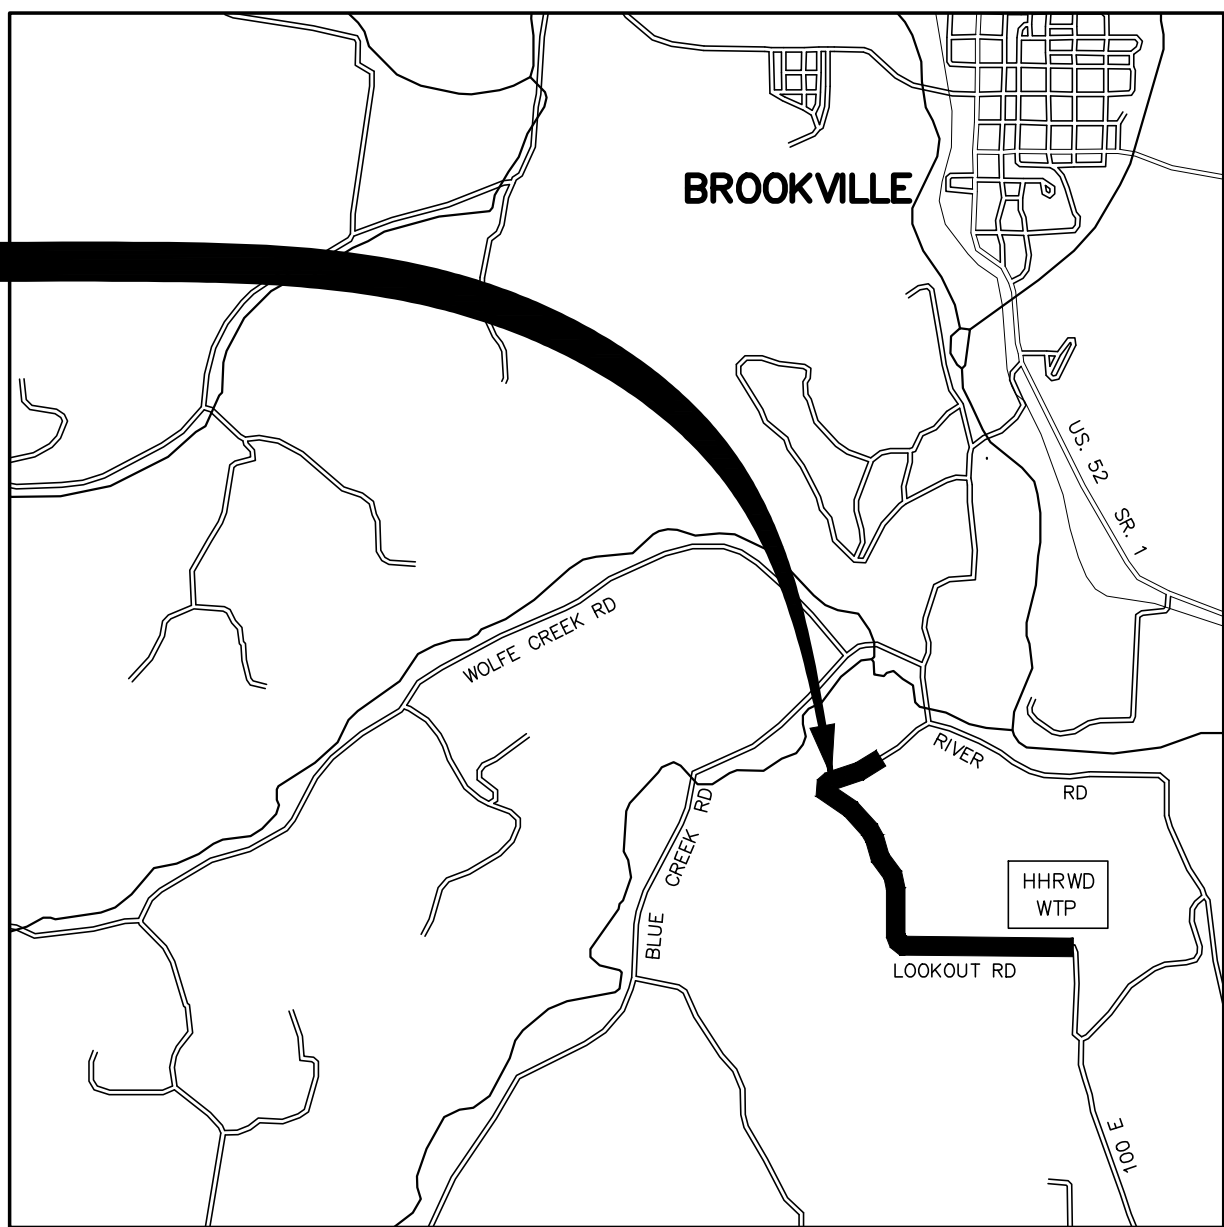

SITE LOCATION MAP

SYMBOL LEGEND

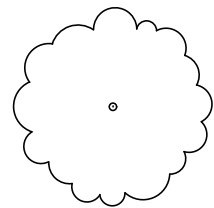-  TEMPORAY BENCHMARK
-  CONTROL POINT
-  TREE
-  FIRE HYDRANT
-  GAS VAVLE
-  POWER POLE
-  TELEPHONE PEDISTAL
-  WATER VAVLE


INDEX OF DRAWINGS	
SHEET NO.	DESCRIPTION
—	COVER SHEET
635—637	PLAN SHEETS

RECORD DRAWING

This drawing has been revised from the original contract drawings to show minor/ major changes made during construction. This drawing is not warranted to be complete and accurate in all respects.

GRW Engineers, Inc.

Date: 6/21/00 By: A.W.

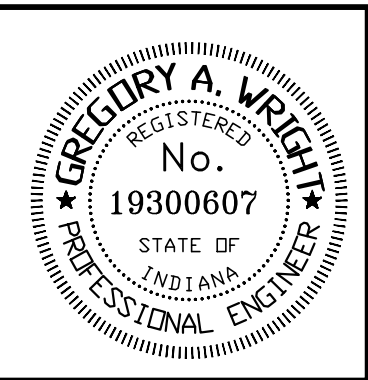

OCTOBER 1999

CERTIFIED: _____ DATE: _____
GREGORY A. WRIGHT, P.E.
INDIANA REG. NO. 19300607