



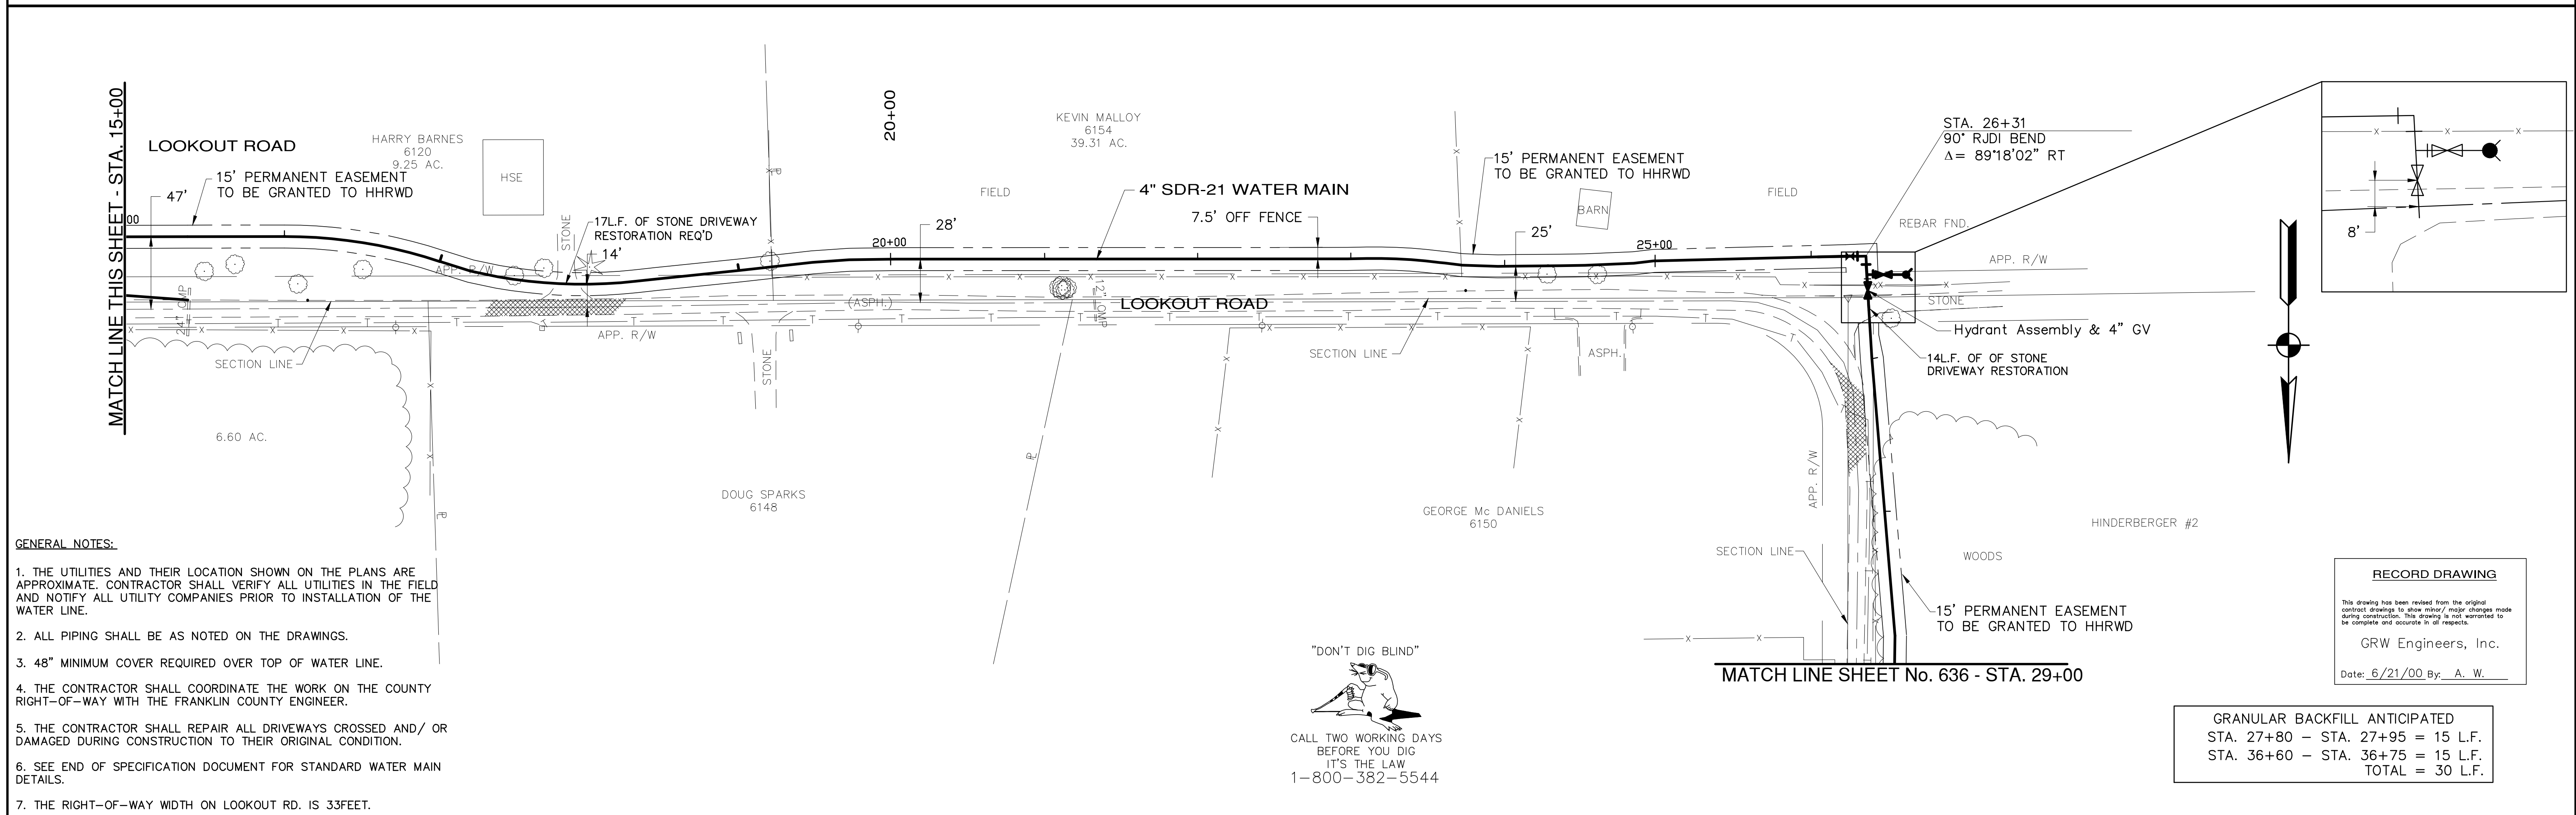

GENERAL NOTES:

1. THE UTILITIES AND THEIR LOCATION SHOWN ON THE PLANS ARE APPROXIMATE. CONTRACTOR SHALL VERIFY ALL UTILITIES IN THE FIELD AND NOTIFY ALL UTILITY COMPANIES PRIOR TO INSTALLATION OF THE WATER LINE.
2. ALL PIPING SHALL BE AS NOTED ON THE DRAWINGS.
3. 48" MINIMUM COVER REQUIRED OVER TOP OF WATER LINE.
4. THE CONTRACTOR SHALL COORDINATE THE WORK ON THE COUNTY RIGHT-OF-WAY WITH THE FRANKLIN COUNTY ENGINEER.
5. THE CONTRACTOR SHALL REPAIR ALL DRIVEWAYS CROSSED AND/ OR DAMAGED DURING CONSTRUCTION TO THEIR ORIGINAL CONDITION.
6. SEE END OF SPECIFICATION DOCUMENT FOR STANDARD WATER MAIN DETAILS.
7. THE RIGHT-OF-WAY WIDTH ON LOOKOUT RD. IS 33 FEET.

"DON'T DIG BLIND"

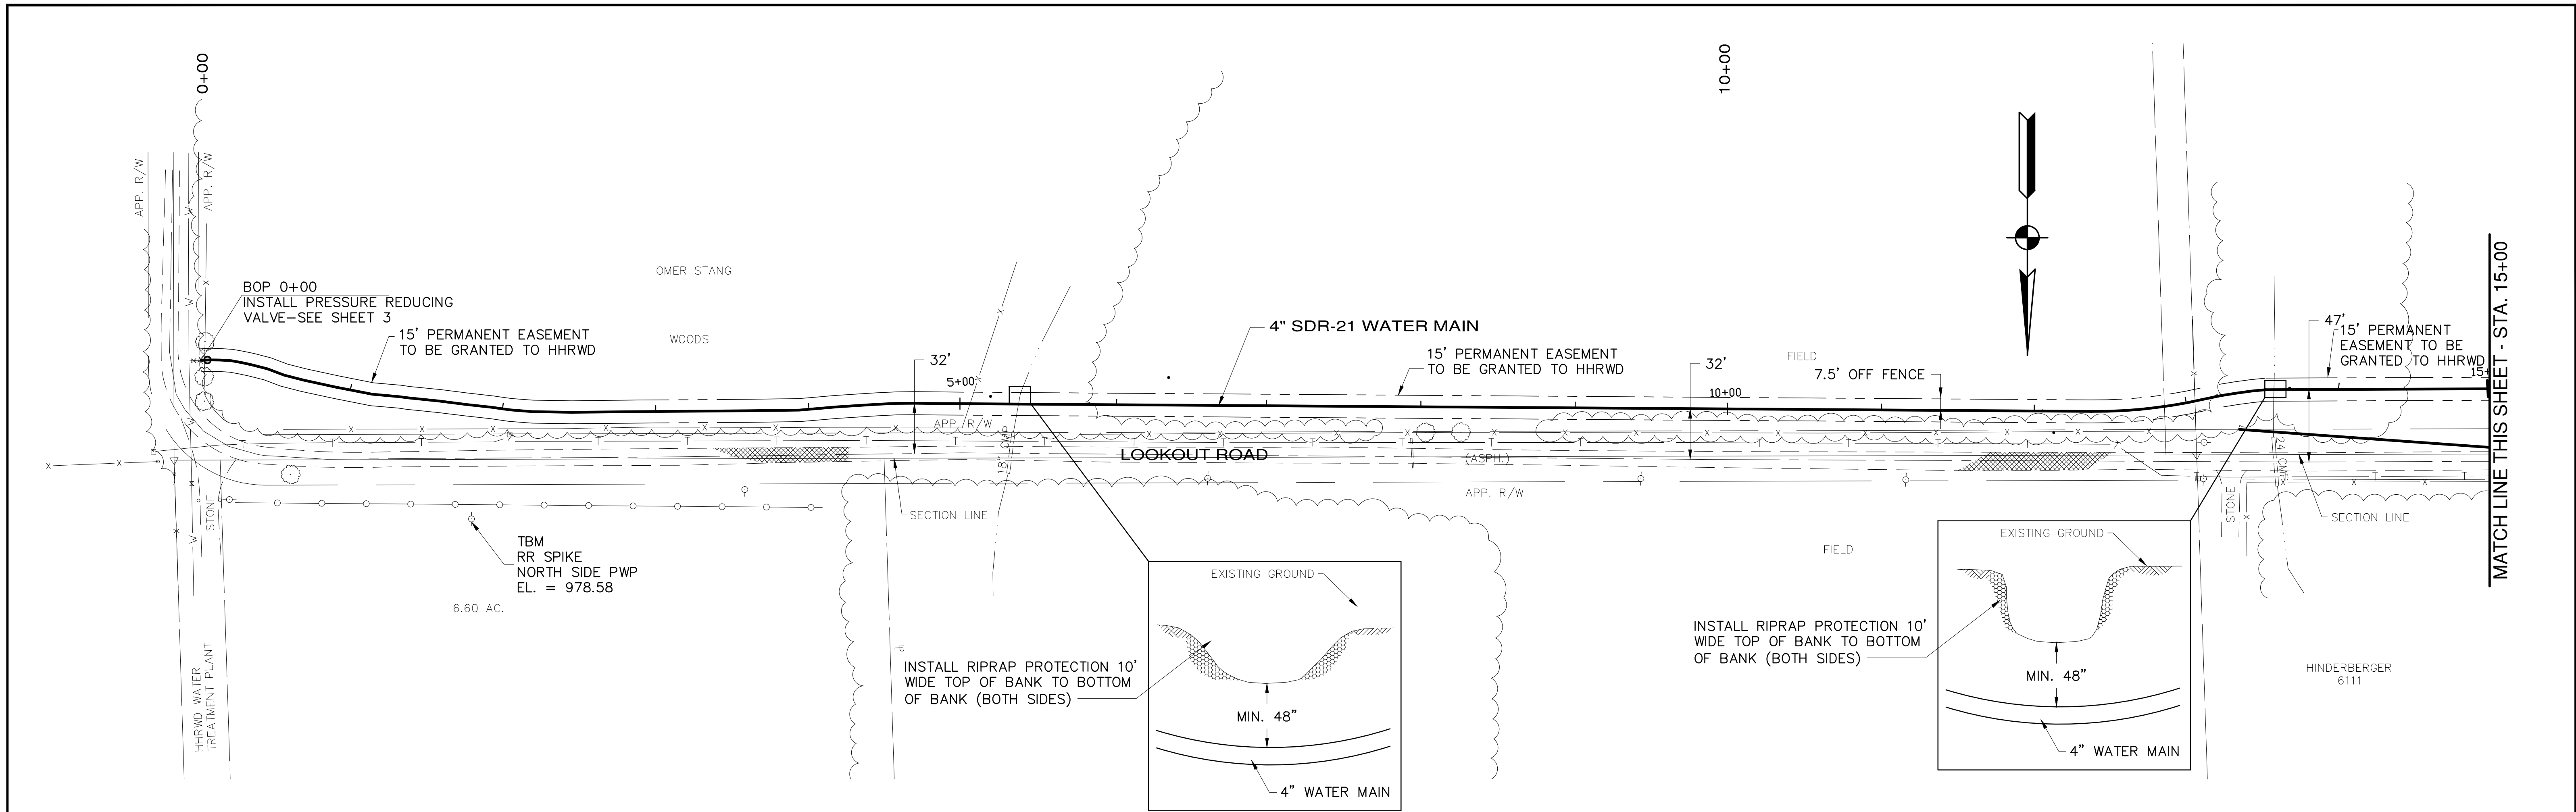

CALL TWO WORKING DAYS
BEFORE YOU DIG
IT'S THE LAW
1-800-382-5544

RECORD DRAWING

This drawing has been revised from the original contract drawings to show minor/ major changes made during construction. This drawing is not warranted to be complete and accurate in all respects.

GRW Engineers, Inc.


Date: 6/21/00 By: A. W.

GRANULAR BACKFILL ANTICIPATED
STA. 27+80 - STA. 27+95 = 15 L.F.
STA. 36+60 - STA. 36+75 = 15 L.F.
TOTAL = 30 L.F.

HOOSIER HILLS REGIONAL
WATER DISTRICT

LOOKOUT ROAD WATER MAIN EXTENSION

GRW PROJECT NO. 2543-20

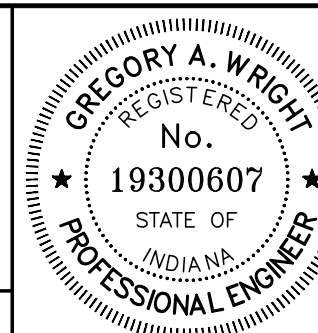

DRAWN: BJD	DATE: OCTOBER-1999
FILE NAME: SHT635.DWG	SCALE: 1"=50'
CHECKED: DRC	SHEET NO.
APPROVED: GAW	635

NO.	DESCRIPTION	DATE	BY
2	RENUMBERED	6-03	GCR
1	AS-BUILT	6-00	AW
	REVISIONS		