
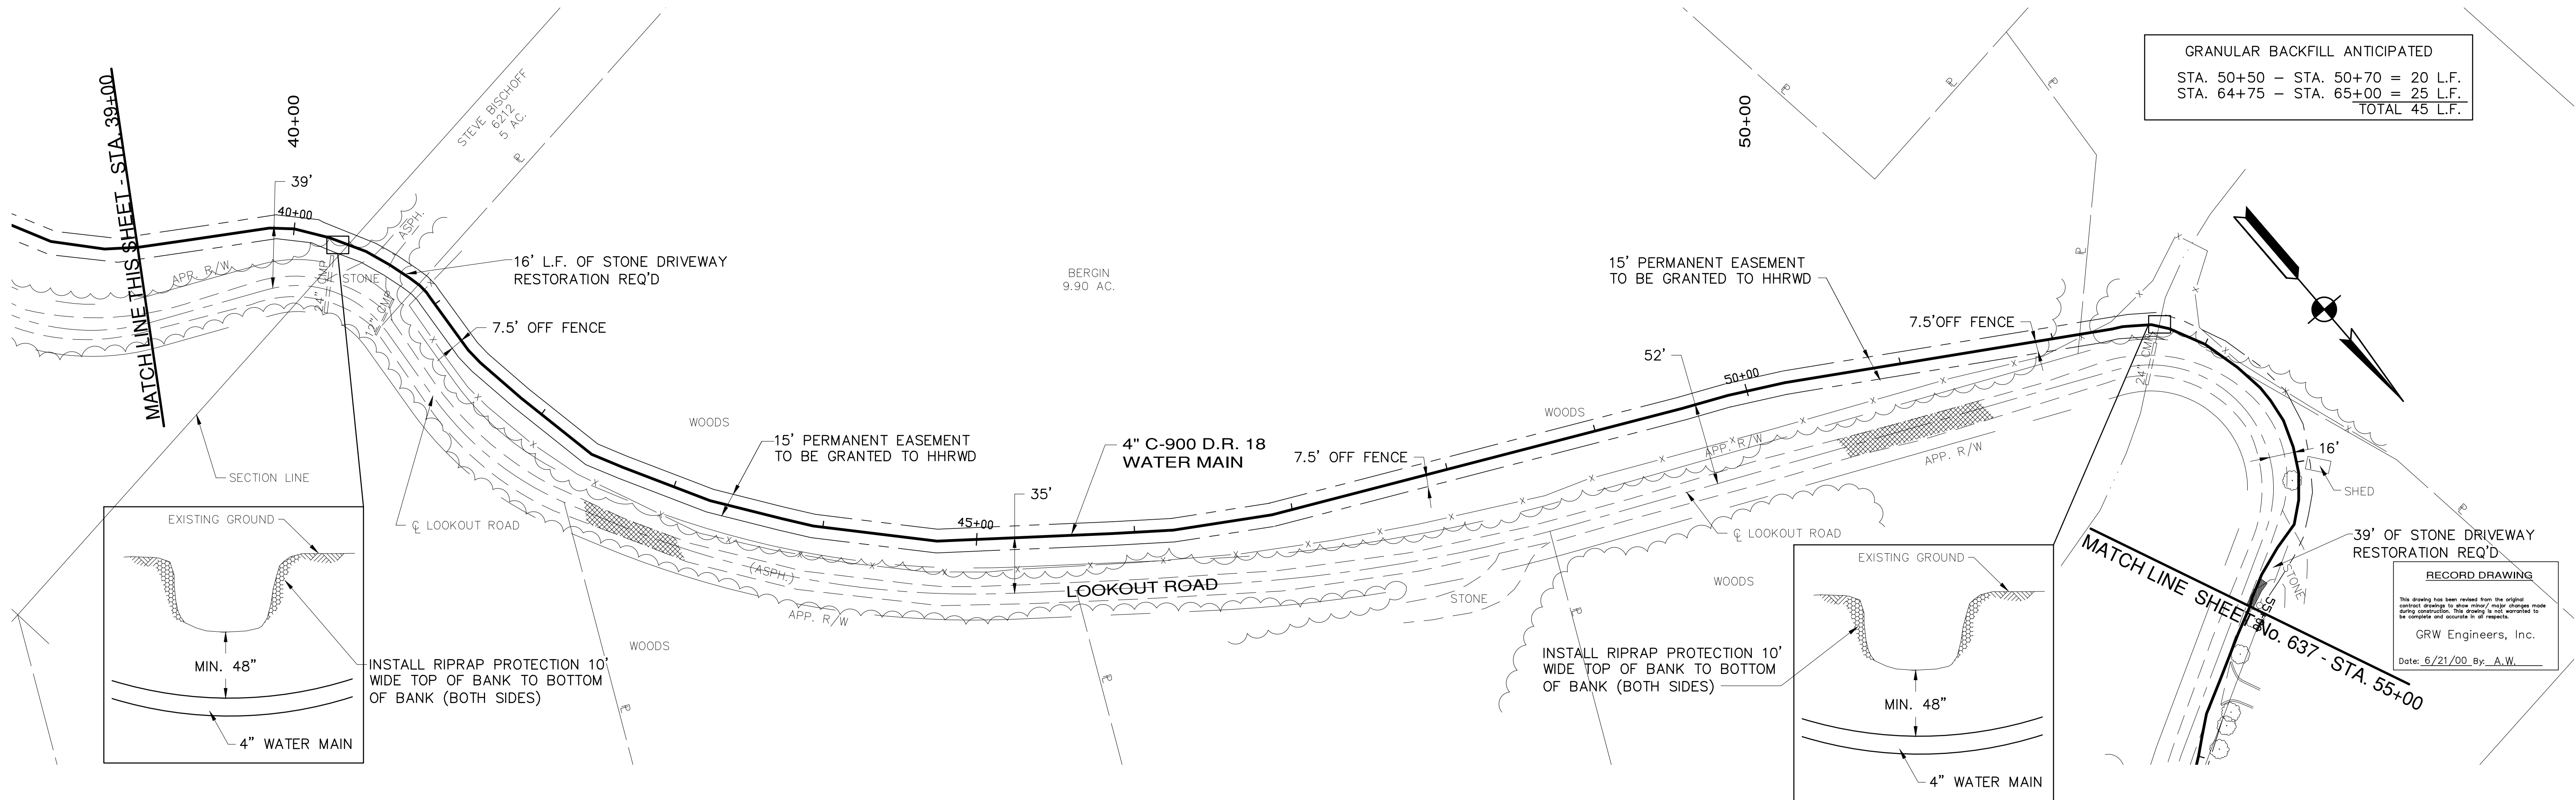


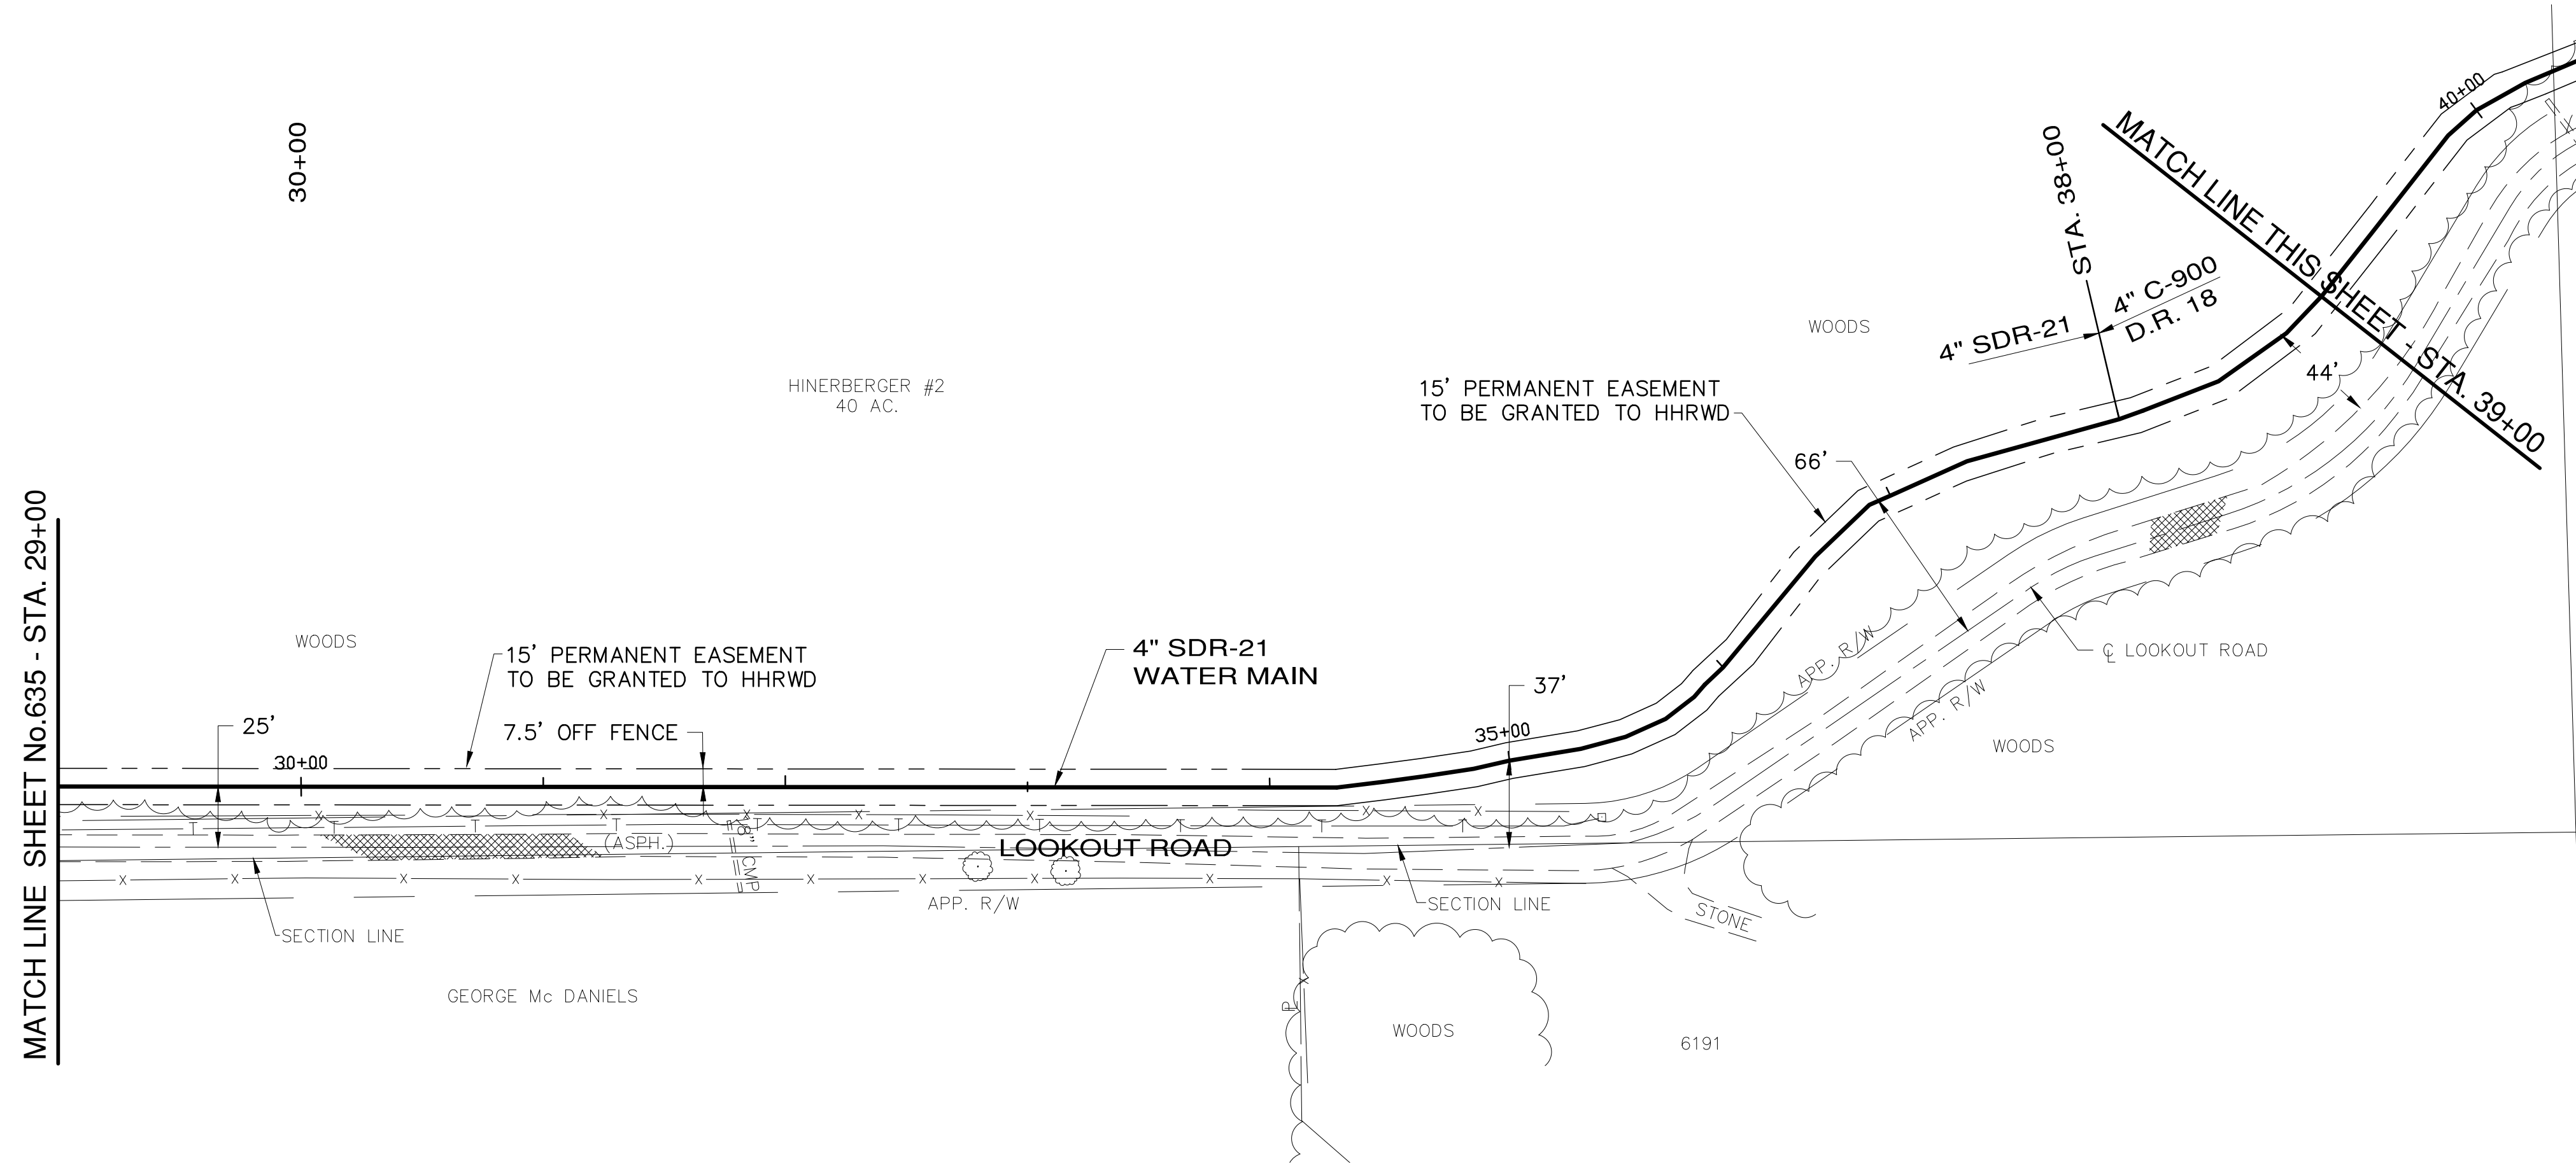


| NO.       | DESCRIPTION | DATE | BY  |
|-----------|-------------|------|-----|
| 2         | RENUMBERED  | 6-99 | GCR |
| 1         | AS-BUILT    | 6-00 | AW  |
| NO.       | DESCRIPTION | DATE | BY  |
| REVISIONS |             |      |     |

## HOOSIER HILLS REGIONAL WATER DISTRICT

LOOKOUT ROAD WATER MAIN EXTENSION

GRW PROJECT NO. 2543-20

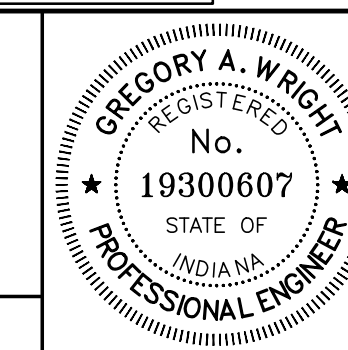

|                          |                       |
|--------------------------|-----------------------|
| DRAWN:<br>BJD            | DATE:<br>OCTOBER-1999 |
| FILE NAME:<br>SHT636.DWG | SCALE:<br>1"=50'      |
| CHECKED:<br>DRC          | SHEET NO.             |
| APPROVED:<br>GAW         | 636                   |