

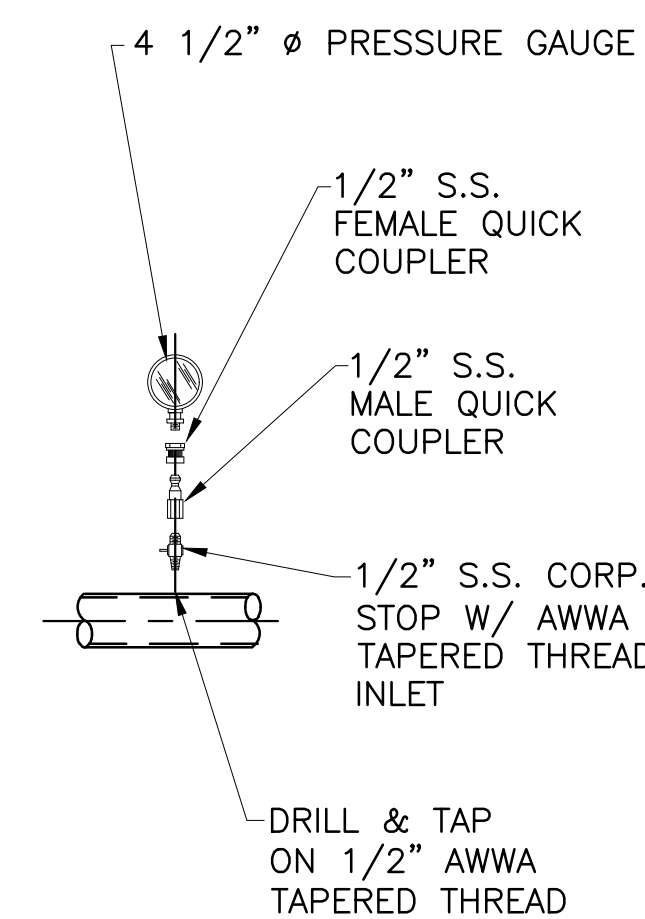
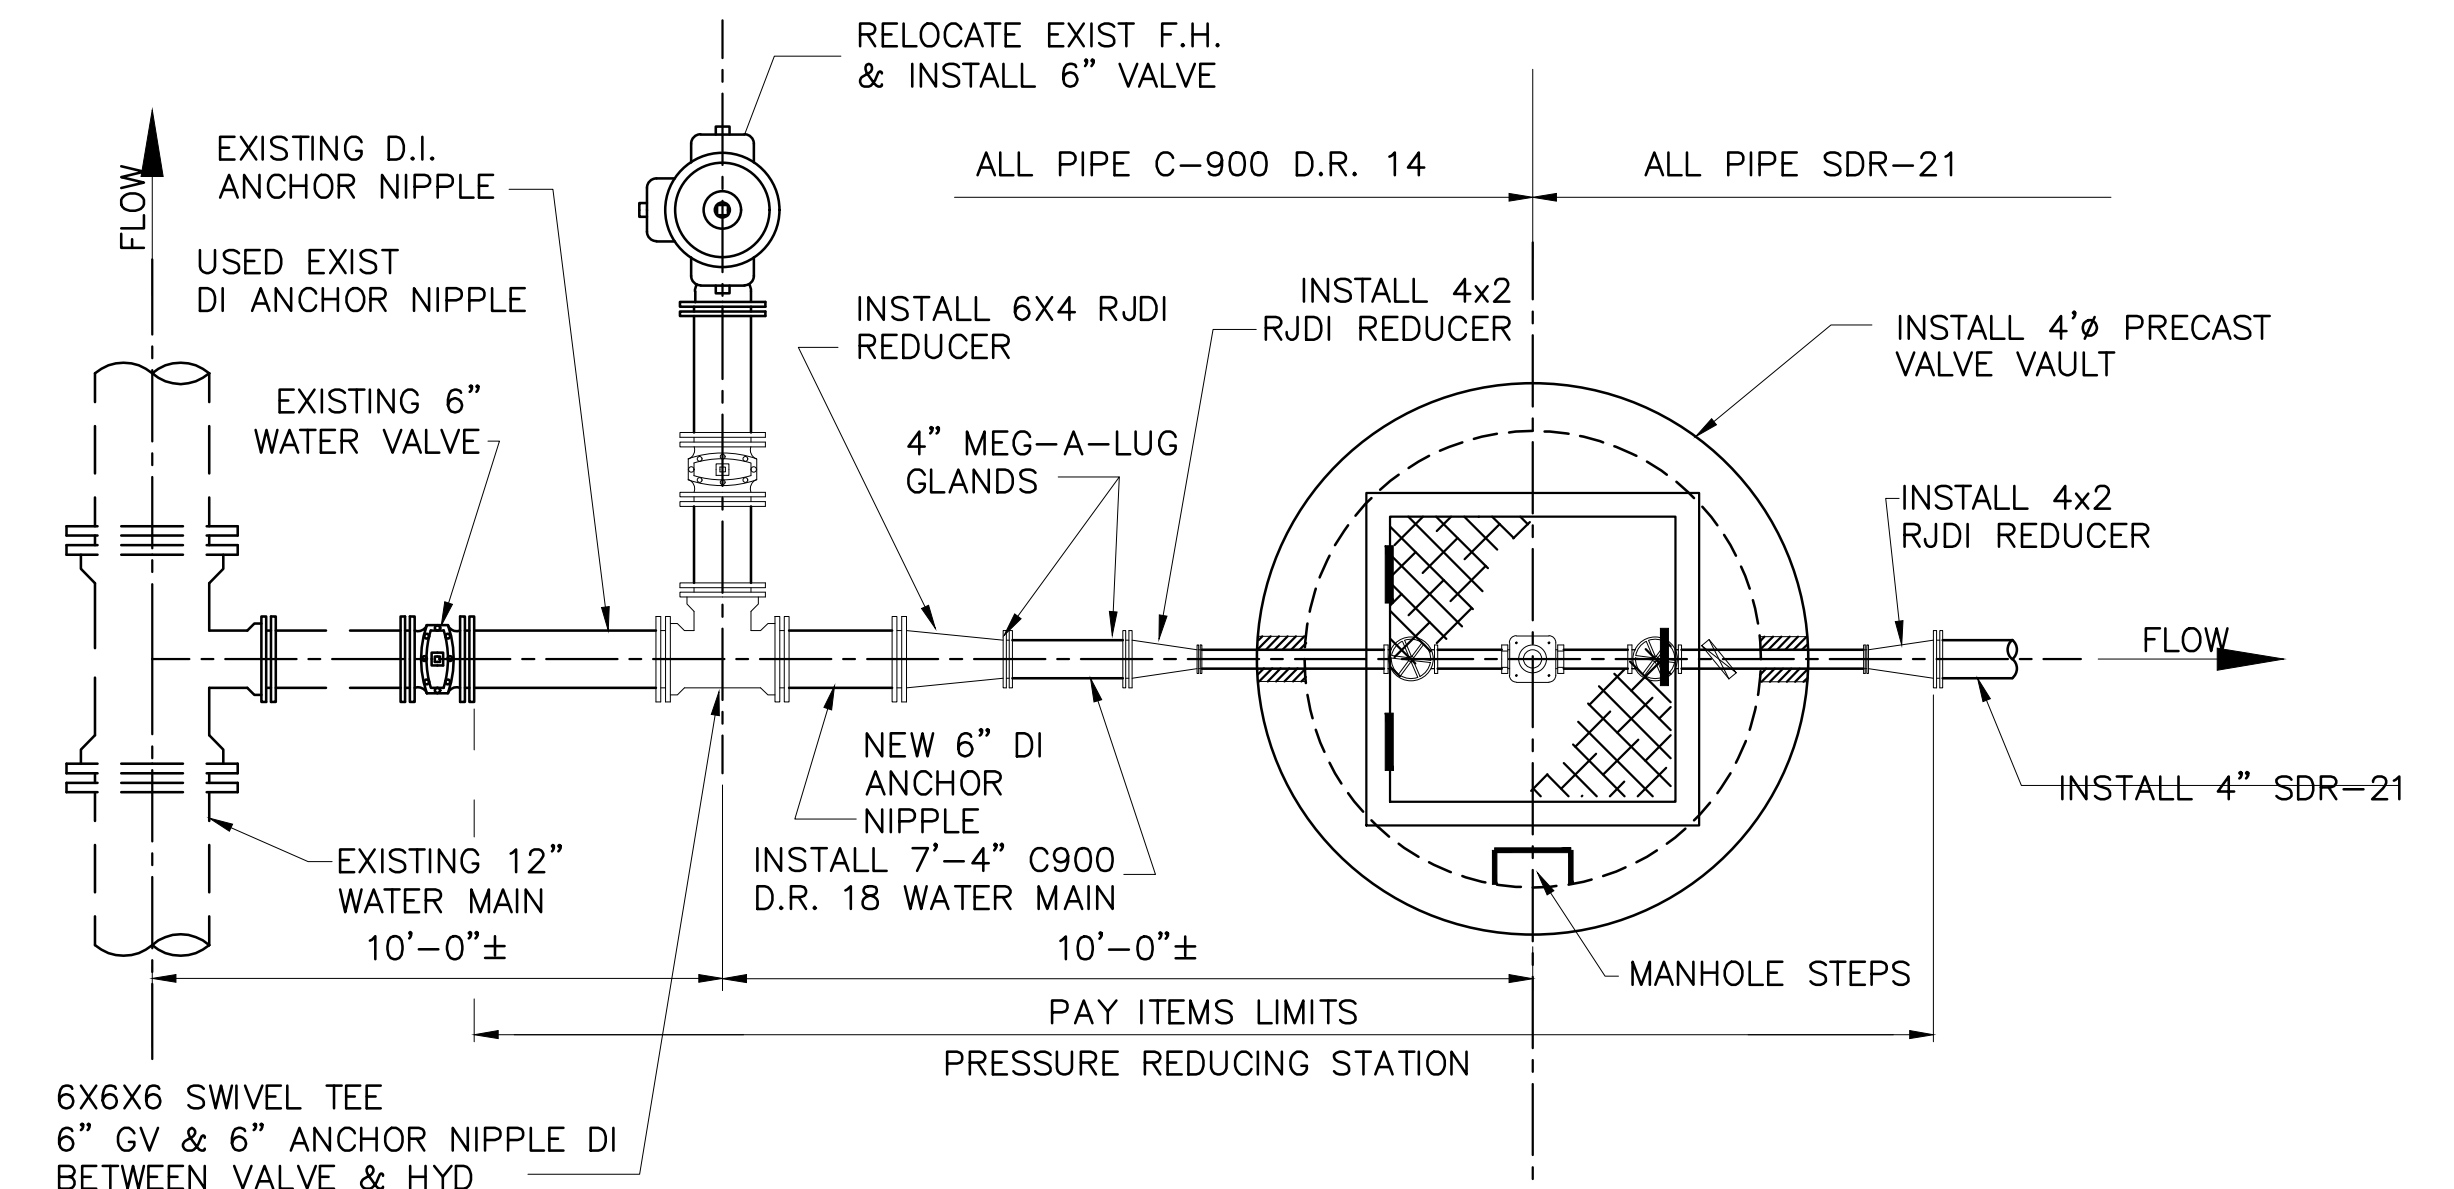


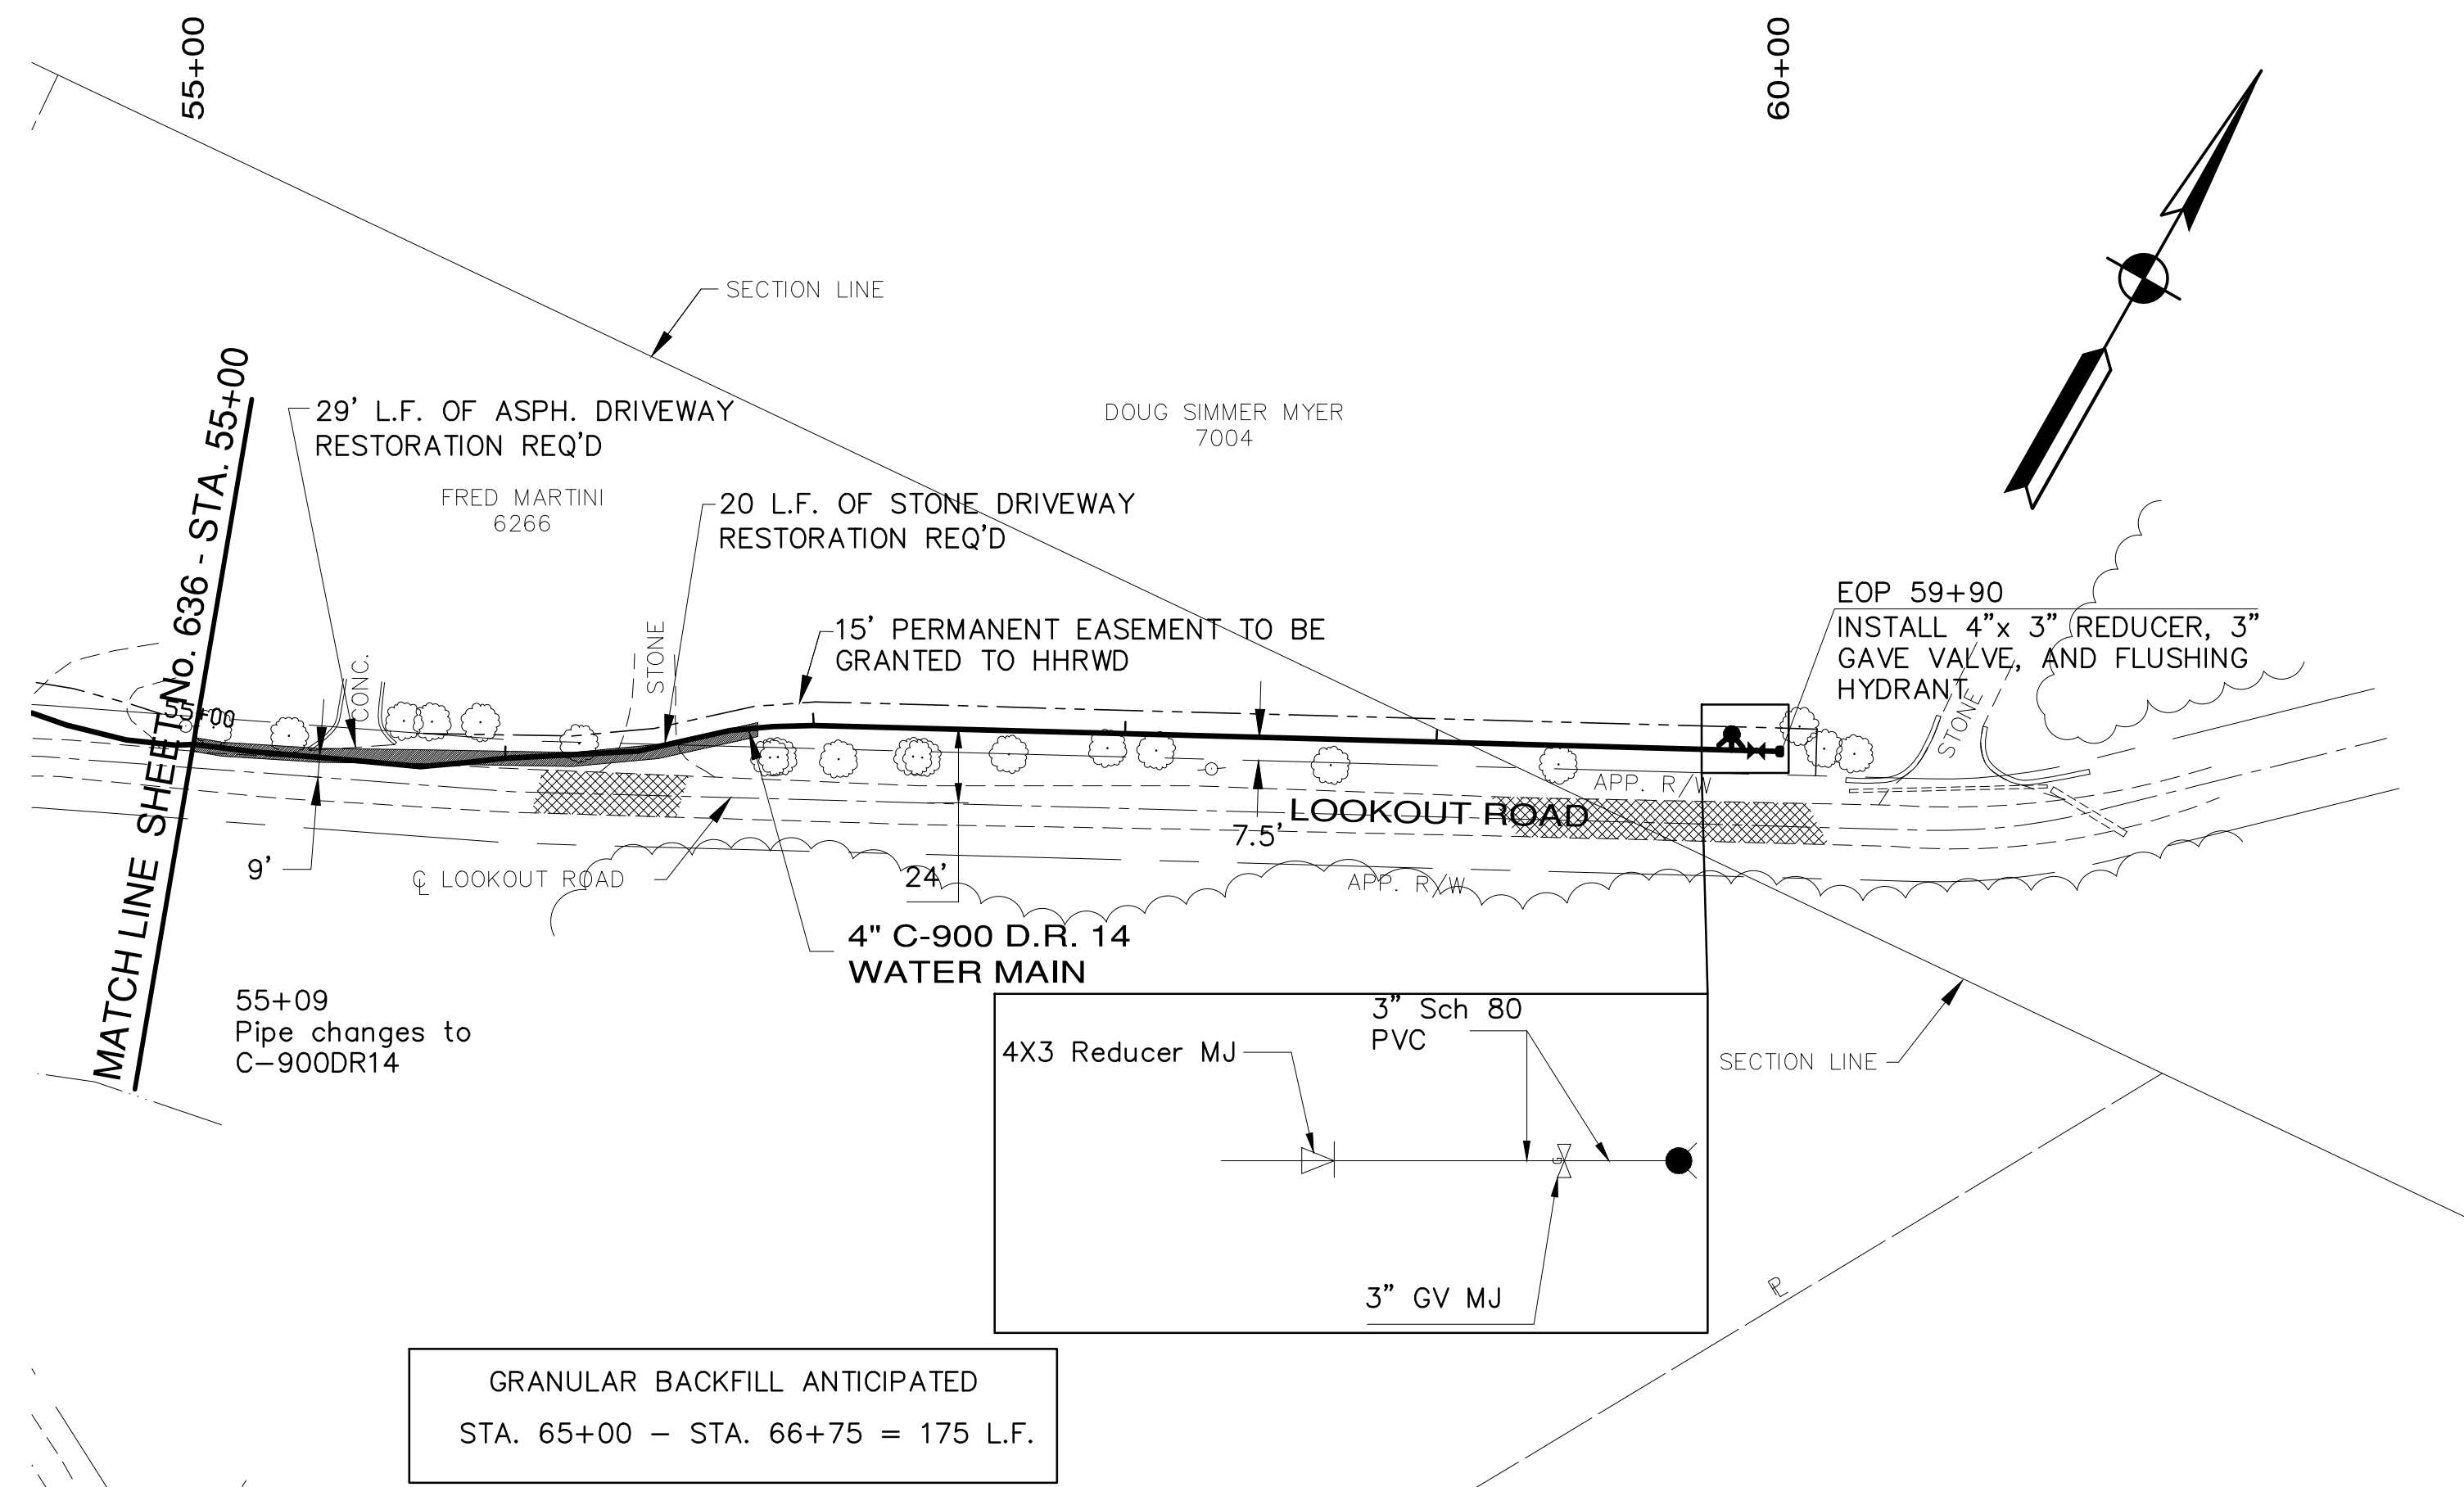

PRESSURE GAUGE QUICK COUPLER
SCALE: N.T.S.

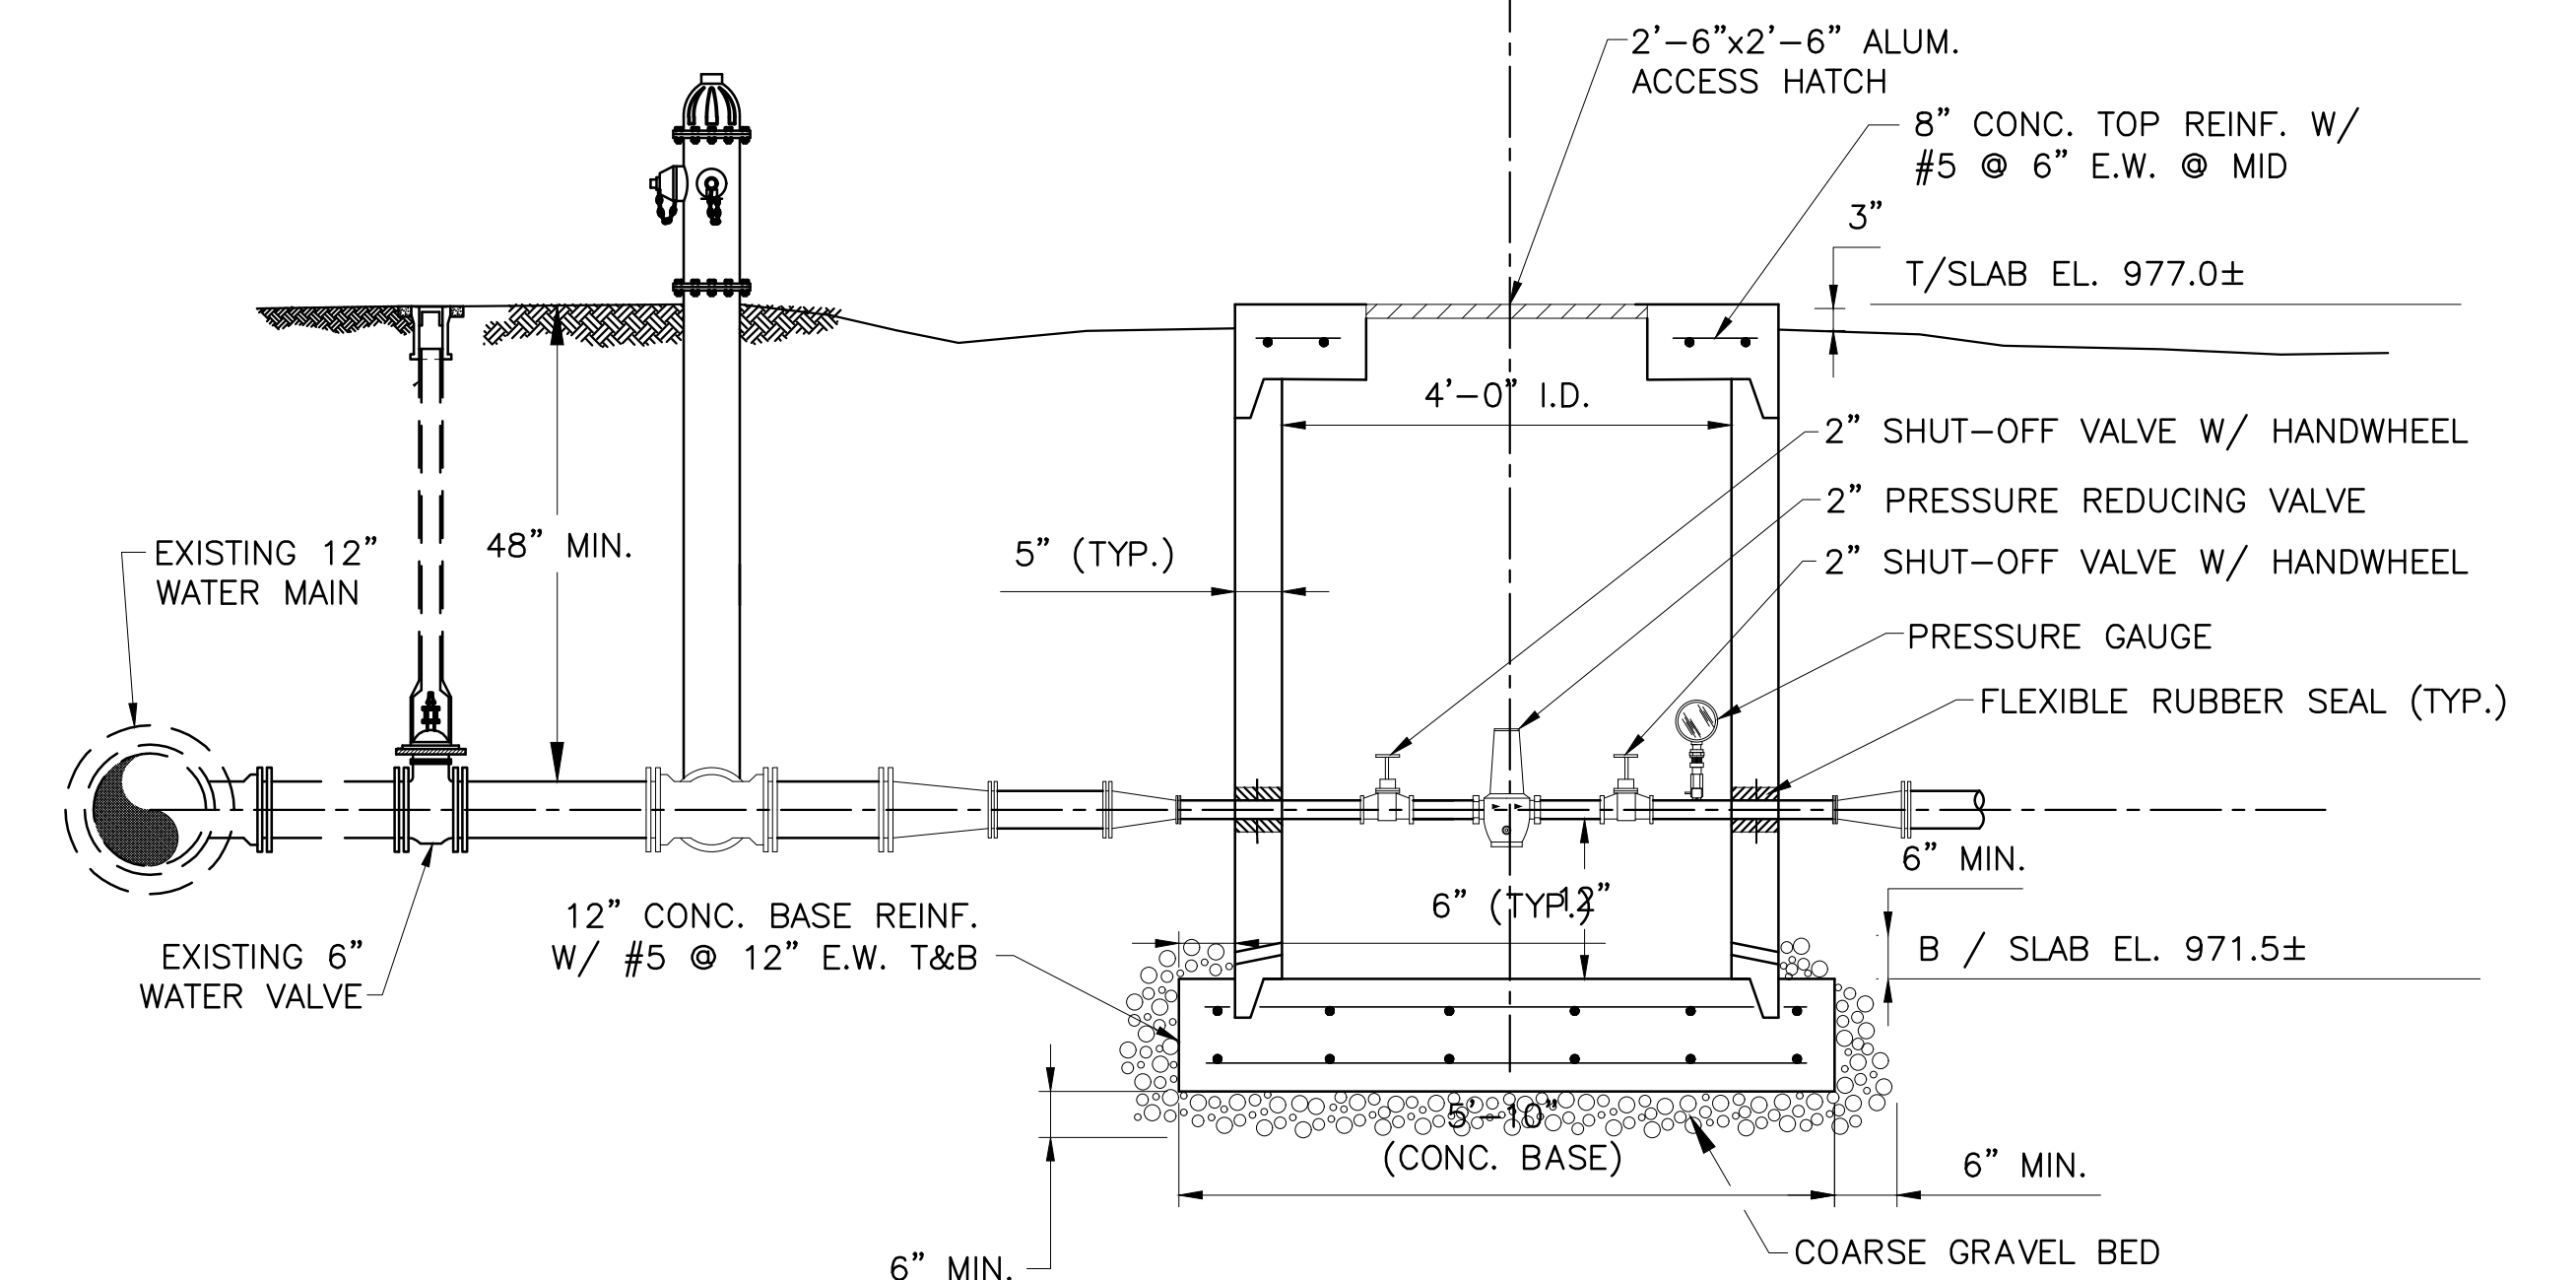

PRESSURE REDUCING STATION DETAIL
SCALE: 1"=1'

RECORD DRAWING

This drawing has been revised from the original contract drawings to show minor changes made during construction. This drawing is not warranted to be complete and accurate in all respects.

GRW Engineers, Inc.


Date: 6/21/00 By: A.W.

NO.	REVISIONS	DATE	BY
1	AS-BUILT	6-00	AW
2	RENUMBERED	6-99	GCR

HOOSIER HILLS REGIONAL WATER DISTRICT

LOOKOUT ROAD WATER MAIN EXTENSION

GRW PROJECT NO. 2543-20

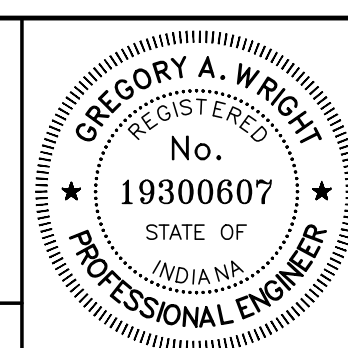

DRAWN: BJD	DATE: OCTOBER-1999
FILE NAME: SHT637.DWG	SCALE: 1"=50'
CHECKED: DRG	SHEET NO. 637
APPROVED: GAW	