


HOOSIER HILLS REGIONAL WATER DISTRICT MILAN & VICINITY WATER MAIN IMPROVEMENTS




PROJECT
LOCATION

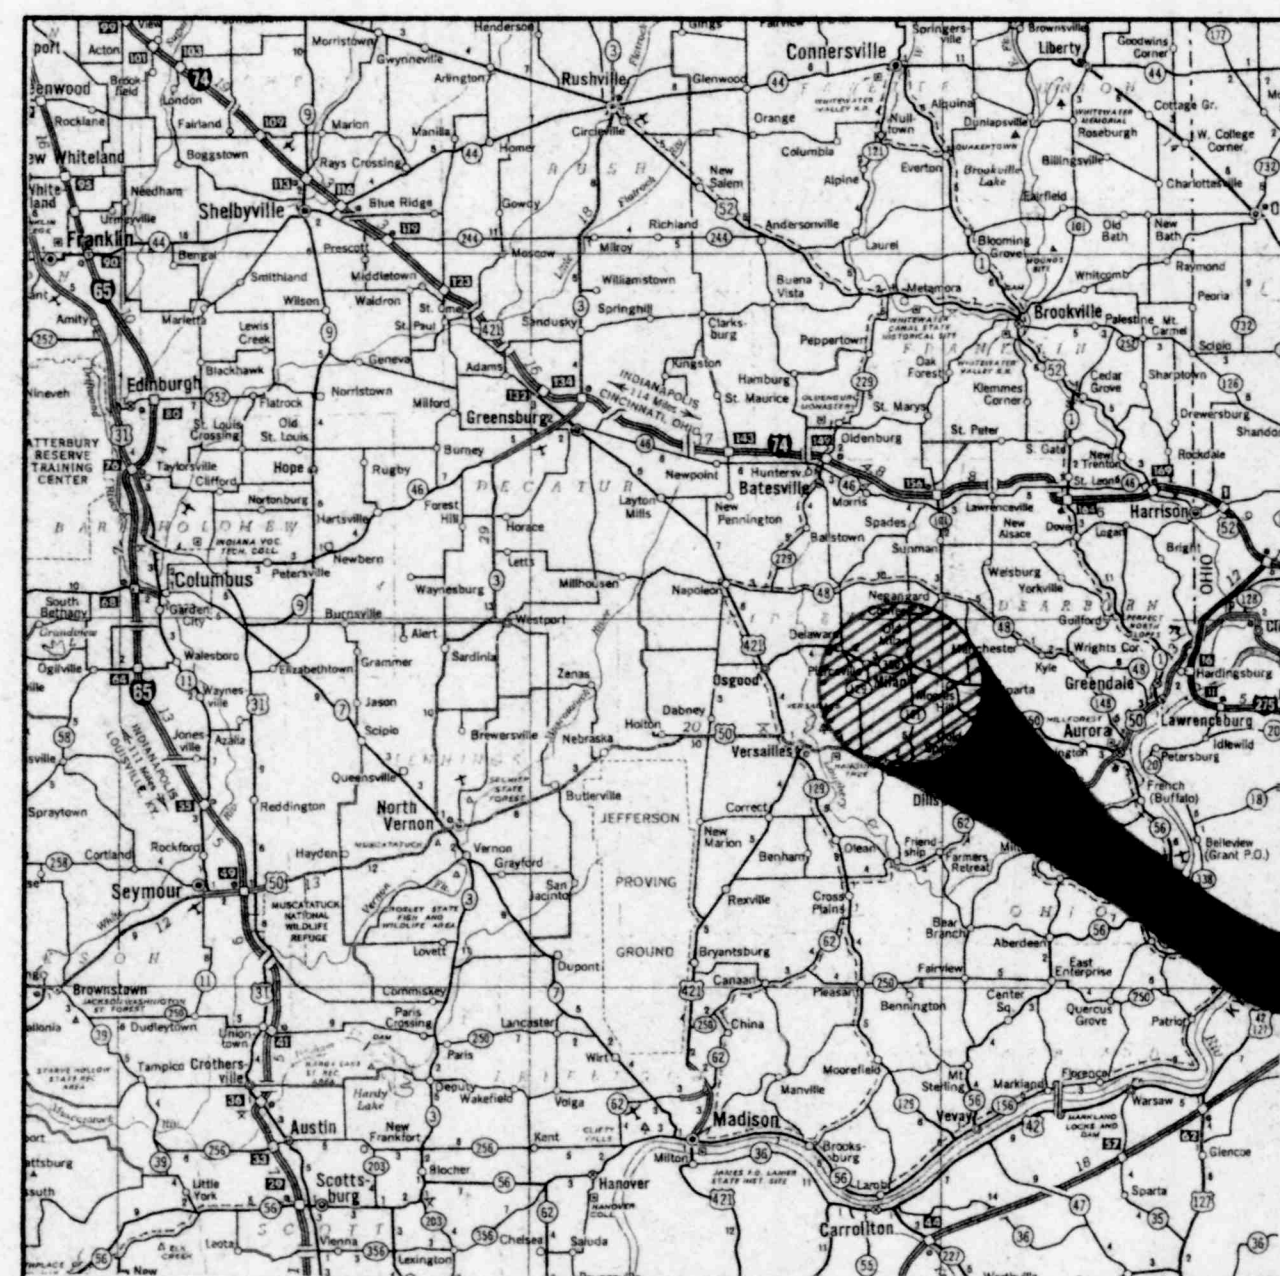

GRW Engineers, Inc.
1099 N. MERIDIAN STREET, SUITE 250
INDIANAPOLIS, IN. 46204
(317) 630-3883

INDIANAPOLIS, INDIANA
LEXINGTON & LOUISVILLE, KENTUCKY
NASHVILLE, TENNESSEE
ARLINGTON, TEXAS
CINCINNATI, OHIO

SITE LOCATION MAP

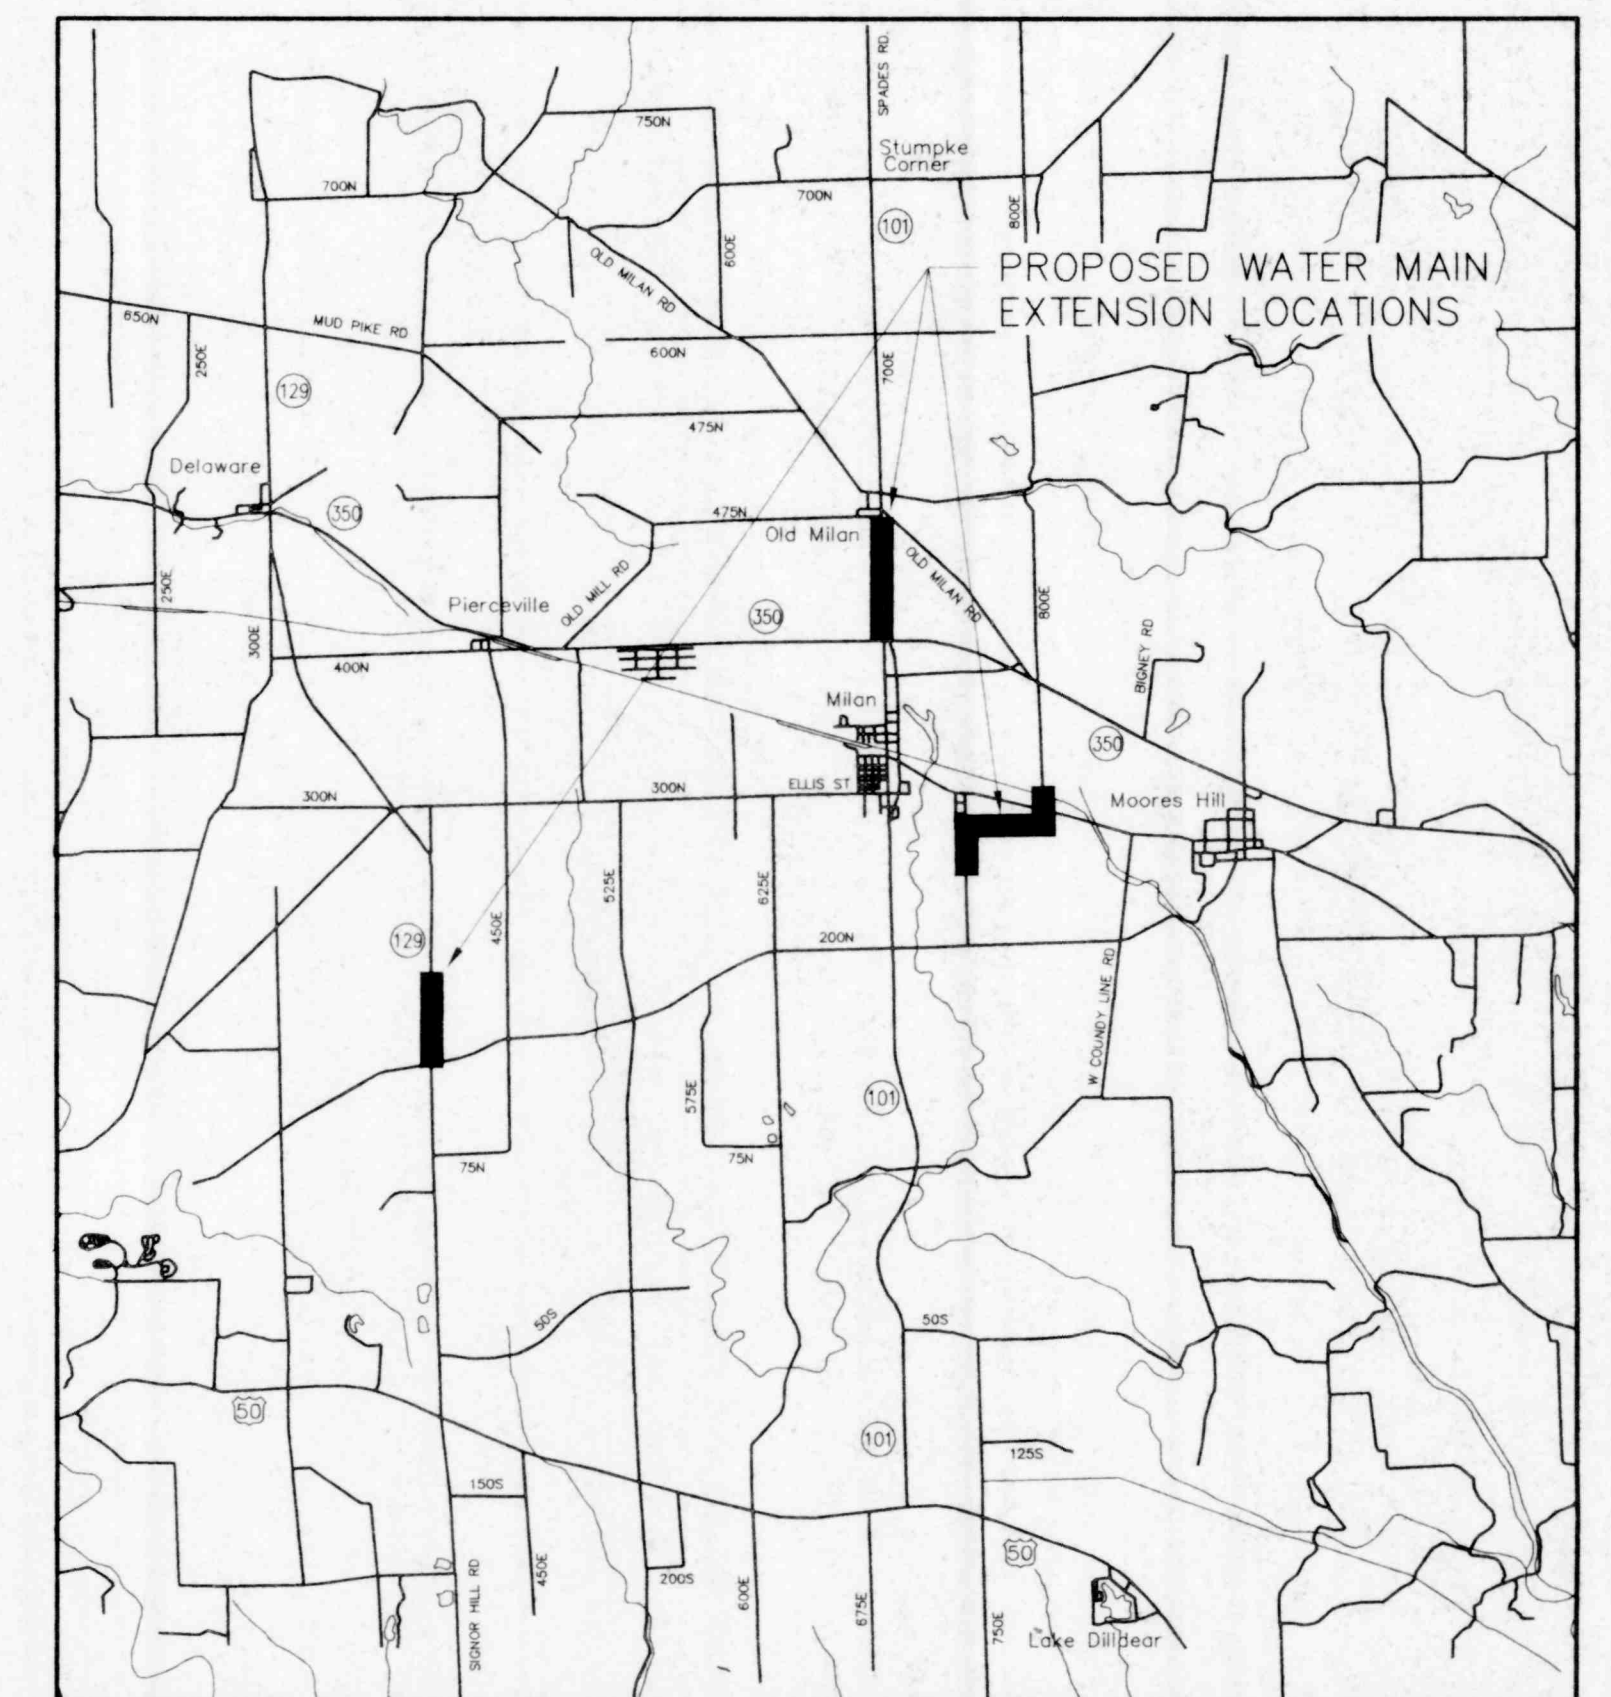

INDEX OF DRAWINGS


SHEET NO.	DESCRIPTION
---	COVER SHEET
1	(NOT CONSTRUCTED) STATE ROAD 101 WATER MAIN
2	(NOT CONSTRUCTED) MILAN MASTER METER VAULT DETAILS
3	CR 750E - CR 300N - CR 800E WATER MAIN
4	STATE ROAD 129 - CR 200N WATER MAIN
5	STANDARD DETAILS

RECORD DRAWING
This drawing has been revised from the original
contract drawings to show minor / major changes made
during construction. This drawing is not warranted to
be complete and accurate in all respects.
GRW Engineers, Inc.
Date: 8/2/99 By: BD

MARCH 1998

CERTIFIED
GREGORY A. WRIGHT, P.E.
INDIANA REG. NO. 19300607

DATE 8/2/99

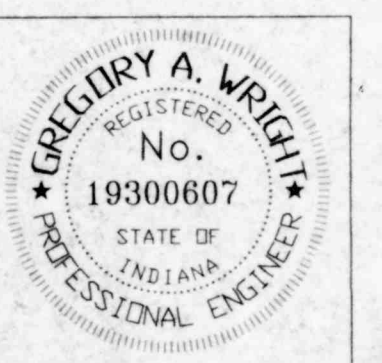

GRW PROJECT NO. 2543