



START PROJECT
INDOT R.P. 29+20±

2.3± MILES TO U.S. 50

END PROJECT
INDOT R.P. 27+99±

2.4± MILES TO S.R. 48

NOTE: TRACER WIRE BURIED WITH ALL PIPE

- NOTES:
- 1). THE UTILITIES AND THEIR LOCATION SHOWN ON PLANS ARE APPROXIMATE. CONTRACTOR SHALL VERIFY ALL UTILITIES IN THE FIELD AND NOTIFY ALL UTILITY COMPANIES PRIOR TO INSTALLATION OF THE WATER LINE.
 - 2). ALL PIPING SHALL BE SDR 21 PVC UNLESS OTHERWISE NOTED.
 - 3). 48" MINIMUM COVER REQUIRED OVER TOP OF WATER LINE.
 - 4). THE LOCATION OF AIR RELEASE VALVES IS APPROXIMATE. VALVES SHALL BE LOCATED AND INSTALLED BY THE CONTRACTOR AT THE HIGH POINT ALONG THE WATER LINE.


- 5). ALL WATER LINES ARE TO BE LOCATED AS FOLLOWS:
 - a). ON STATE HIGHWAY R/W; 5 FEET INSIDE R/W LINE.
 - b). ON COUNTY HIGHWAY R/W; 5 FEET INSIDE R/W LINE.
 - c). ON TOWNSHIP HIGHWAY R/W; 5 FEET INSIDE R/W LINE.
 - d). ON PRIVATE PROPERTY; ON THE CENTERLINE OF 10 FOOT PERMANENT EASEMENT.
 - e). ANY EXCEPTIONS TO THE ABOVE LISTED DISTANCES WILL BE NOTED ON THE PLANS OR EASEMENTS.

NO.	DESCRIPTION	DATE	BY
2	RENUMBERED	6-03	GCR
1	AS-BUILT	8-99	BD
REVISIONS			

HOOSIER HILLS REGOINAL
WATER DISTRICT

MILAN & VICINITY
WATER MAIN IMPROVEMENTS

GRW PROJECT NO. 2543-04

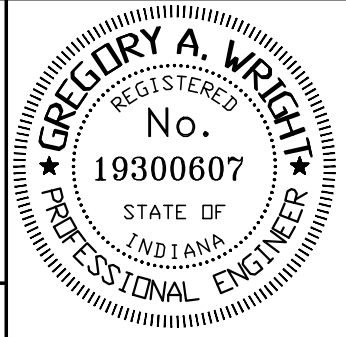

GRW Engineers, Inc.
Engineers, Architects, Planners
INDIANAPOLIS, INDIANA
LOUISVILLE & LEXINGTON, KENTUCKY
CINCINNATI, OHIO
NASHVILLE, TENNESSEE
ARLINGTON, TEXAS

DRAWN: BJD	DATE: 3/17/98
FILE NAME: Shi623.dwg	SCALE: 1"=100'
CHECKED:	SHEET NO.
APPROVED:	623

RECORD DRAWING

This drawing has been revised from the original contract drawings to show minor/ major changes made during construction. This drawing is not warranted to be complete and accurate in all respects.

GRW Engineers, Inc.

Date: 8-2-99 By: BD