 


HOOSIER HILLS REGIONAL WATER DISTRICT NEAL SUBDIVISION WATER MAIN EXTENTION




VICINITY MAP



GRW Engineers, Inc.
7112 WALDEMAR DR.
INDIANAPOLIS, IN. 46268
(317) 347-3650

INDIANAPOLIS, INDIANA
LEXINGTON & LOUISVILLE, KENTUCKY
NASHVILLE, TENNESSEE
ARLINGTON, TEXAS
CINCINNATI, OHIO

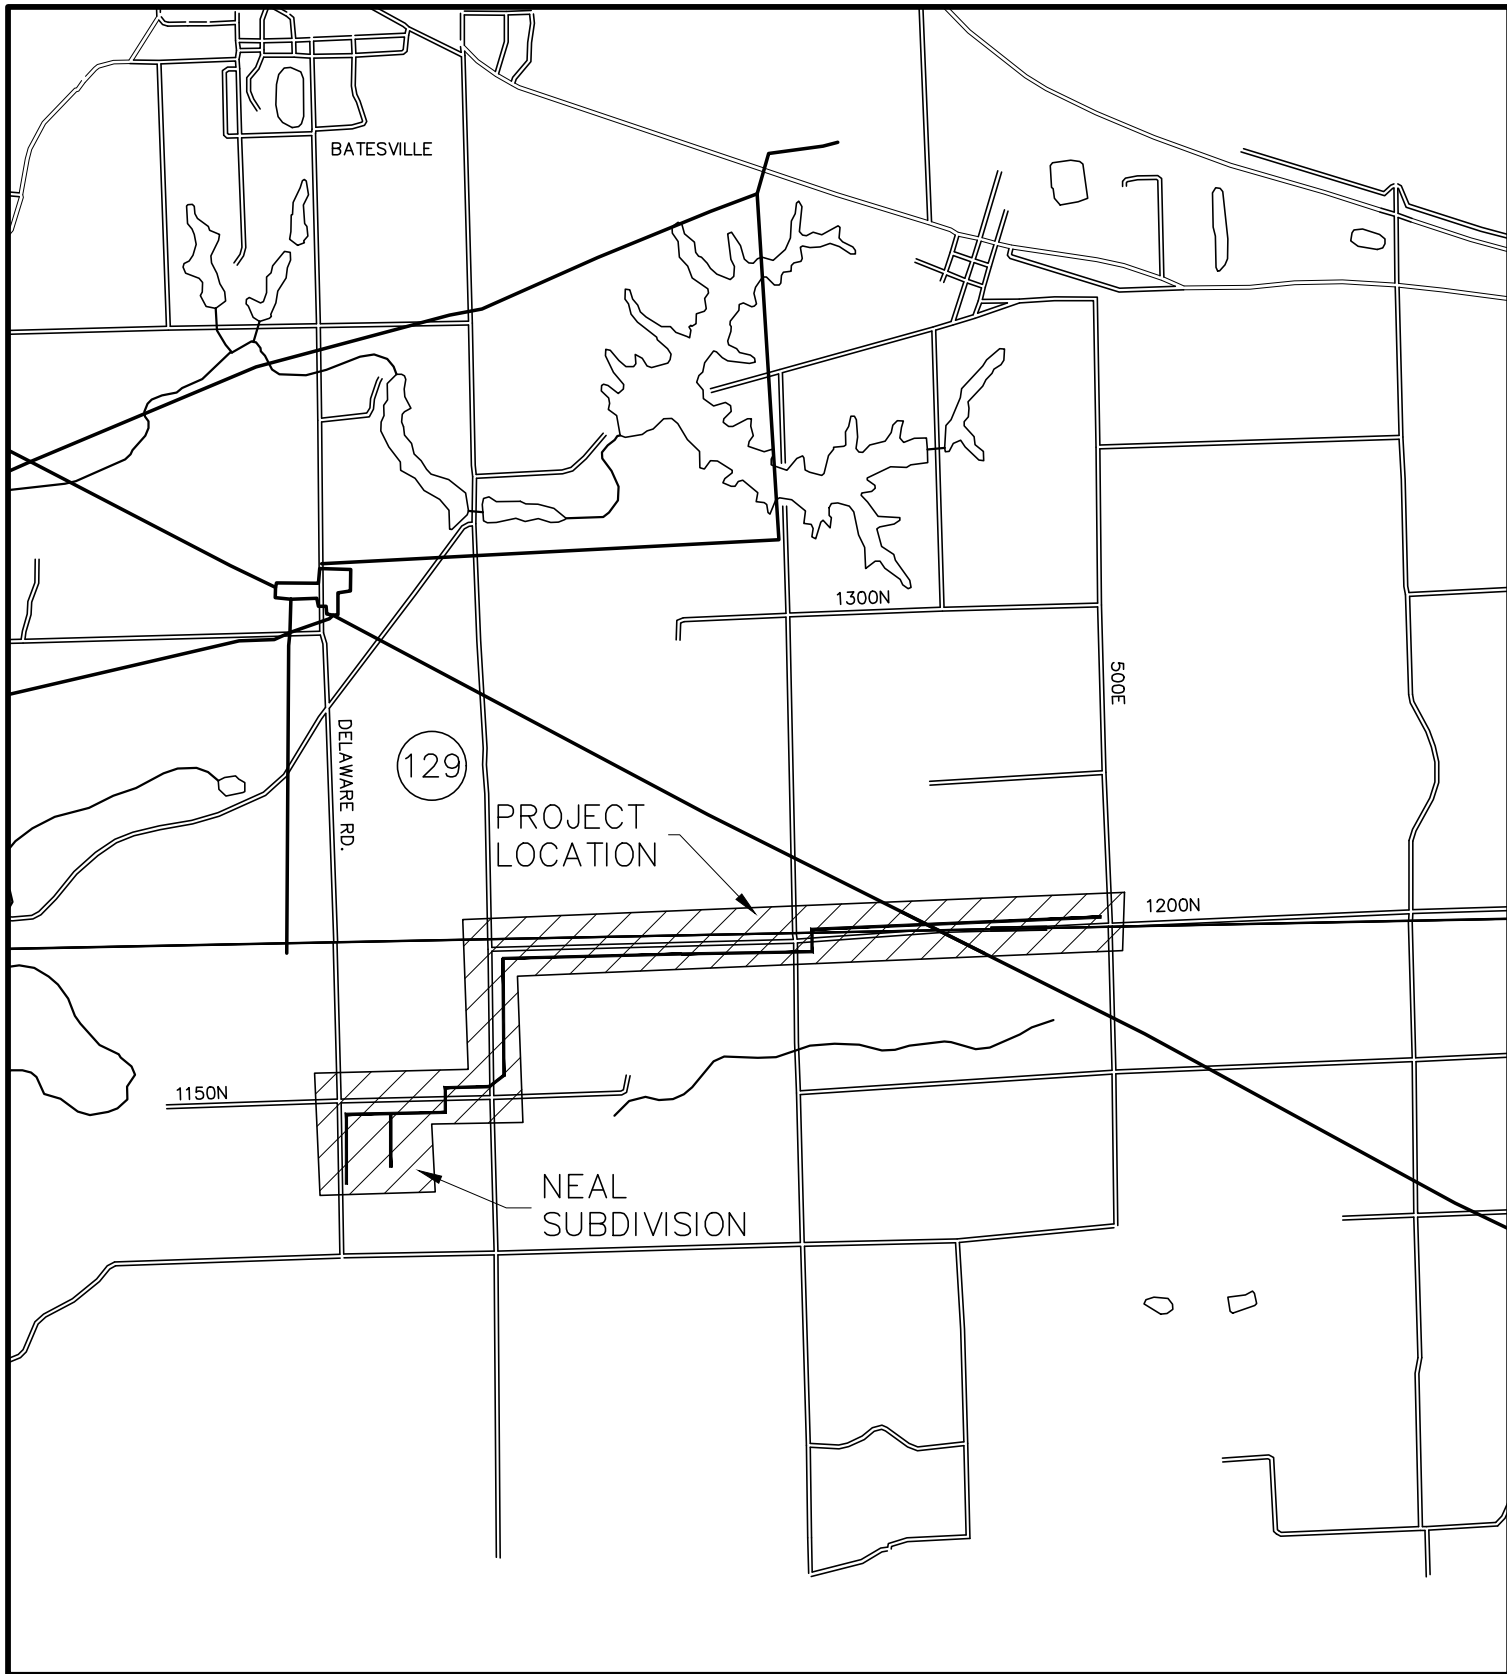

SITE LOCATION MAP

INDEX OF DRAWINGS	
SHEET NO.	DESCRIPTION
—	COVER SHEET
1 - 6	PLAN SHEETS

RECORD DRAWING

This drawing has been revised from the original contract drawings to show minor / major changes made during construction. This drawing is not warranted to be complete and accurate in all respects.

GRW Engineers, Inc.

Date: _____ By: _____

APRIL 1999

CERTIFIED _____ DATE _____
GREGORY A. WRIGHT, P.E.
INDIANA REG. NO. 19300607

