


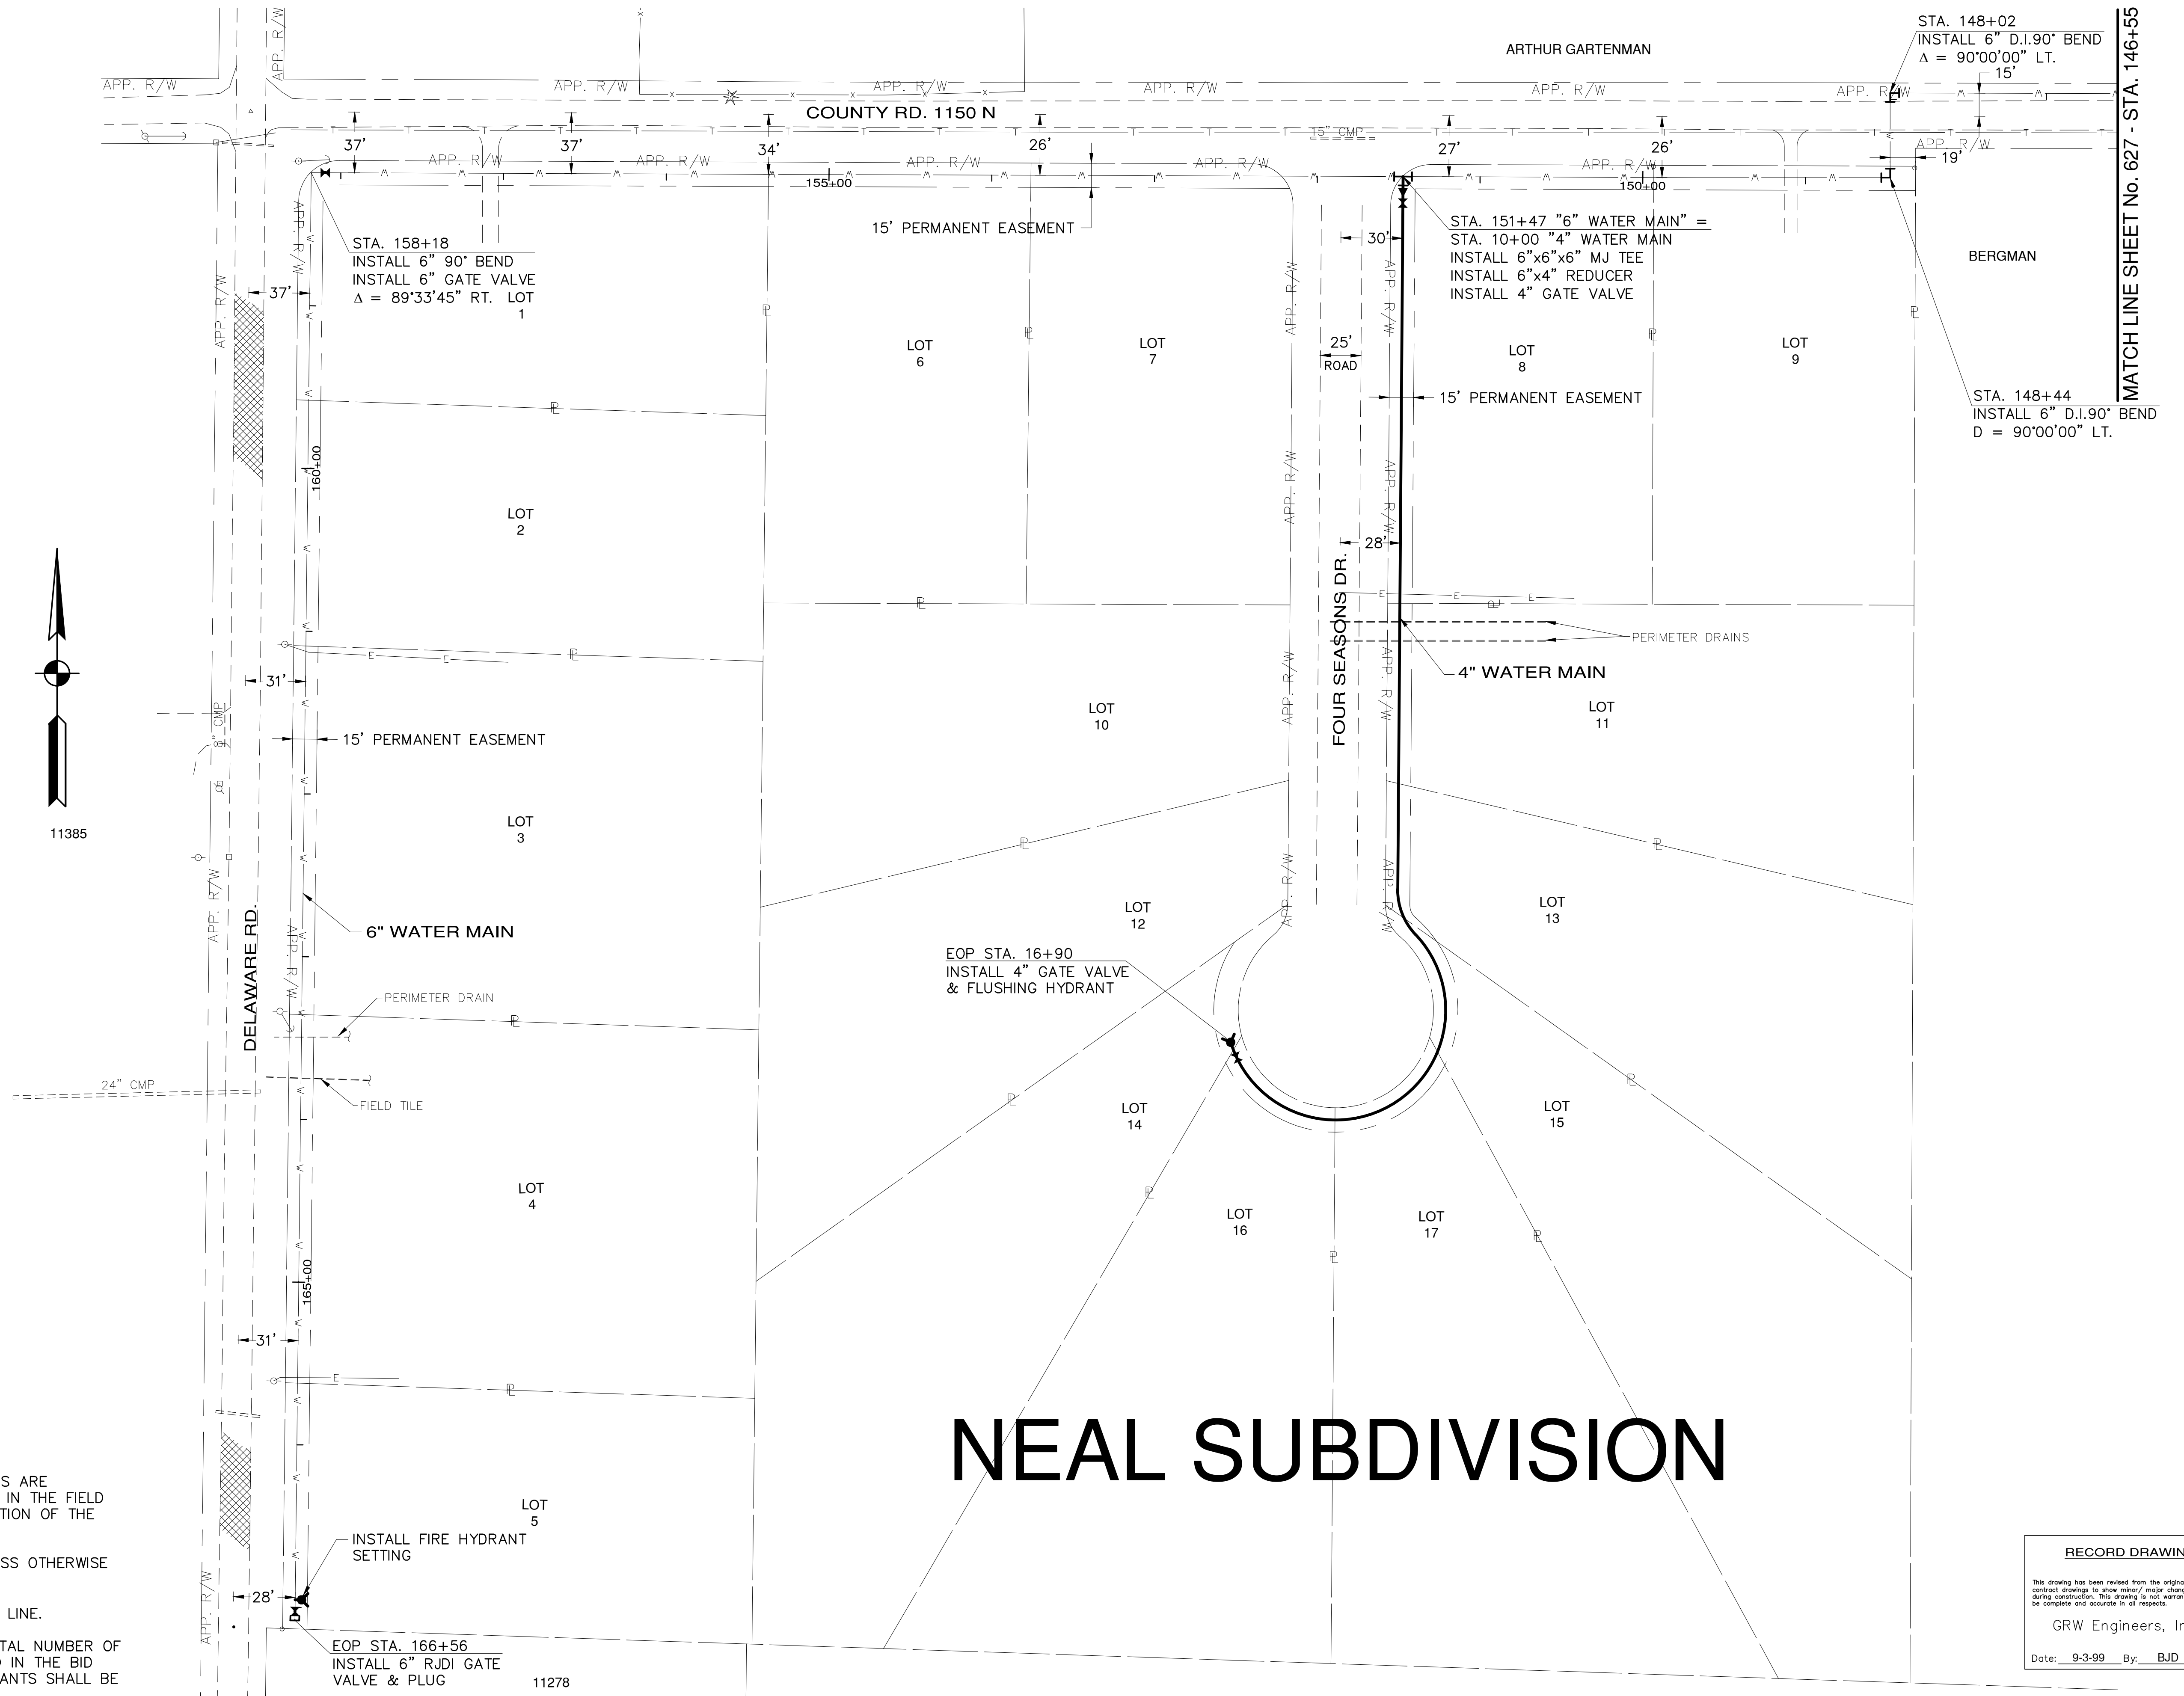


- GENERAL NOTES:
1. THE UTILITIES AND THEIR LOCATION SHOWN ON PLANS ARE APPROXIMATE. CONTRACTOR SHALL VERIFY ALL UTILITIES IN THE FIELD AND NOTIFY ALL UTILITY COMPANIES PRIOR TO INSTALLATION OF THE WATER LINE.
 2. ALL PIPING SHALL BE CLASS 160 SDR 26 PVC UNLESS OTHERWISE NOTED.
 3. 48" MINIMUM COVER REQUIRED OVER TOP OF WATER LINE.
 4. PLANS DO NOT REFLECT THE LOCATIONS OF THE TOTAL NUMBER OF FIRE HYDRANT SETTINGS TO BE INSTALLED AS NOTED IN THE BID TABULATION. THE ACTUAL FIELD LOCATION OF ALL HYDRANTS SHALL BE AS DIRECTED BY THE ENGINEER.

NO.	DESCRIPTION	DATE	BY
2	RENUMBERED	6-03	GCR
1	AS-BUILT	9-99	BD
REVISIONS			

HOOSIER HILLS REGIONAL
WATER DISTRICT

NEAL SUBDIVISION WATER MAIN EXTENTION

GRW PROJECT NO. 2543-13

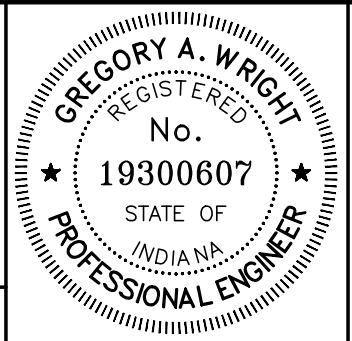

GRW Engineers, Inc.
Engineers, Architects, Planners

INDIANAPOLIS, INDIANA
LOUISVILLE & LEXINGTON, KENTUCKY
CINCINNATI, OHIO
NASHVILLE, TENNESSEE
ARLINGTON, TEXAS

DRAWN: BJD	DATE: APRIL 1999
FILE NAME: SHT626.DWG	SCALE: 1"=50'
CHECKED: -	SHEET NO. 626
APPROVED: -	