



MATCH LINE SHEET No. 630 - STA. 31+37

MATCH LINE THIS SHEET - STA. 15+15

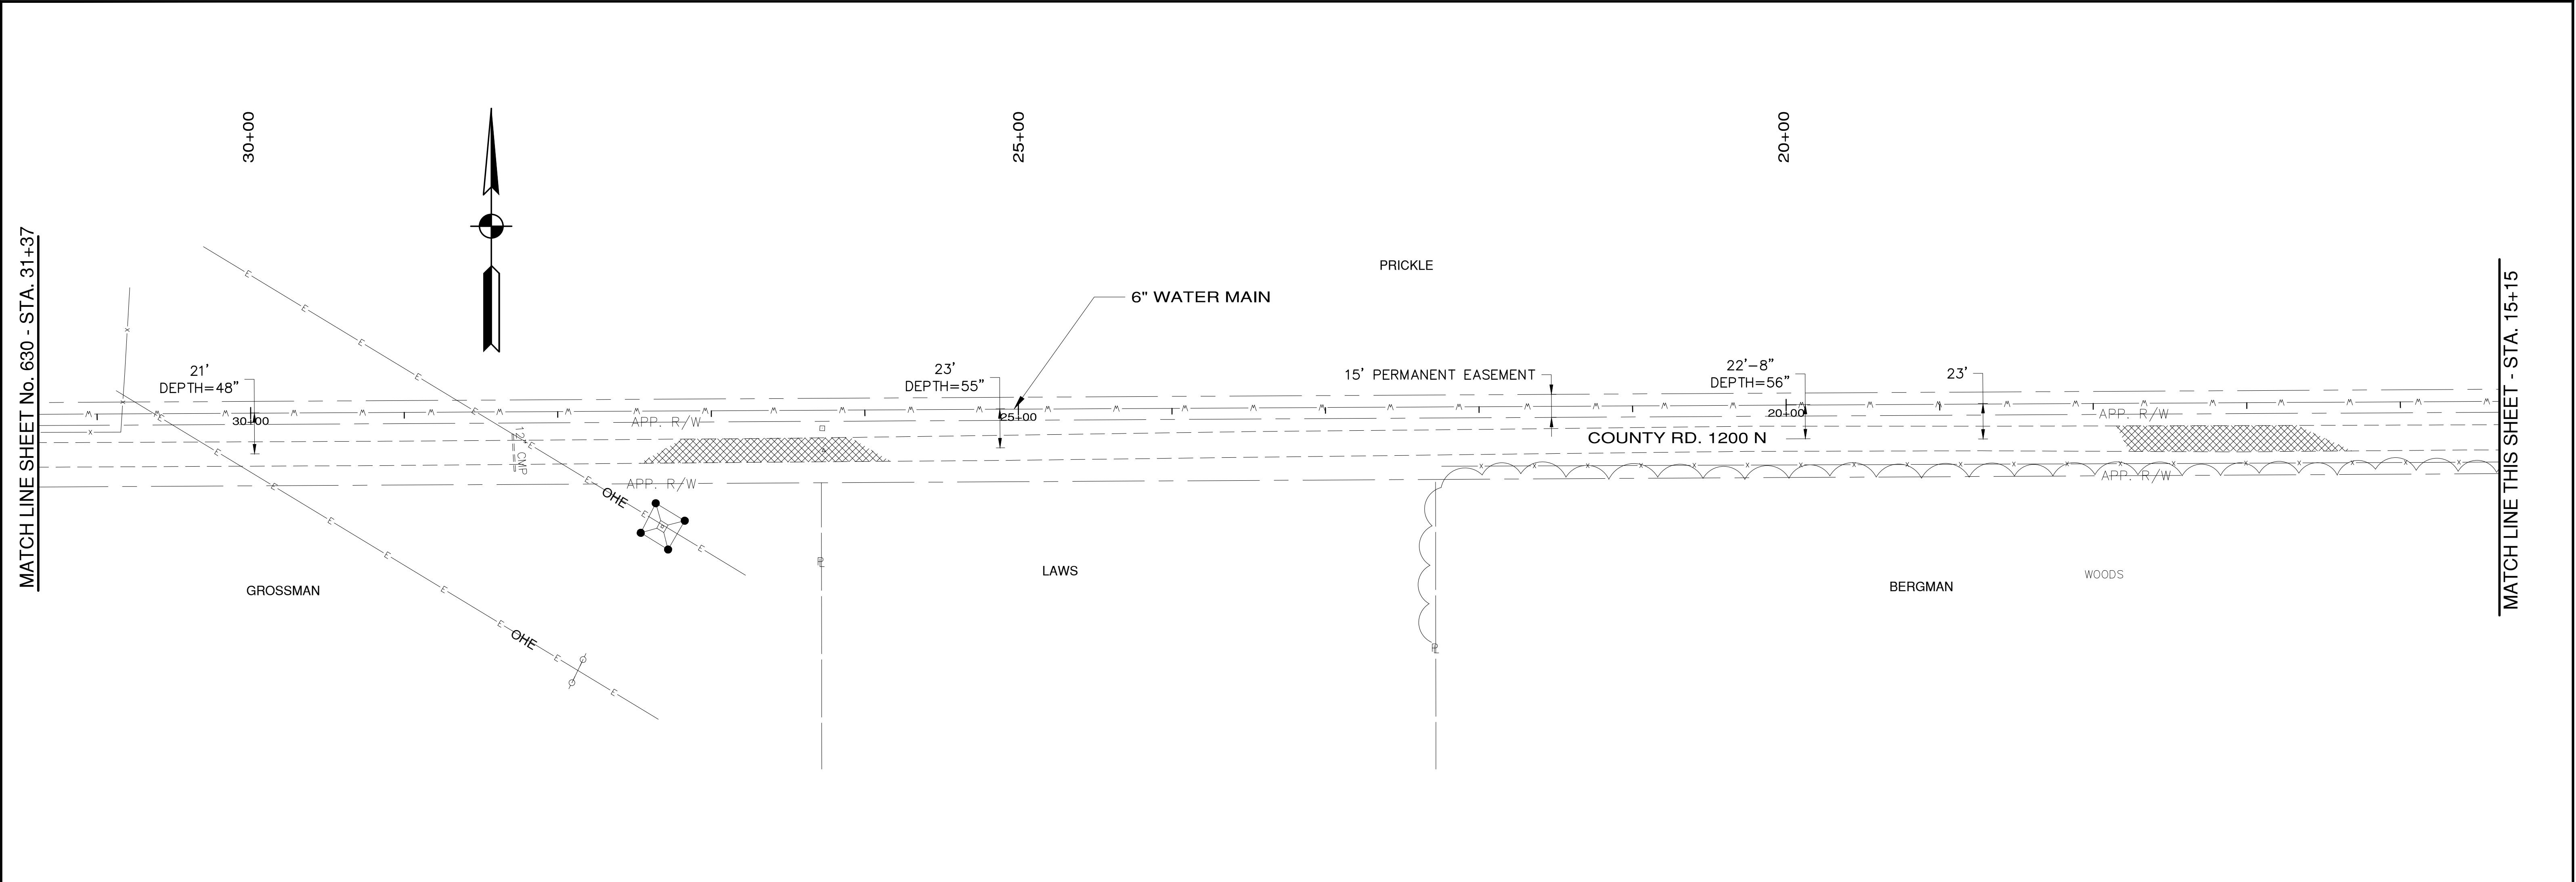

MATCH LINE THIS SHEET - STA. 15+15

MATCH LINE THIS SHEET - STA. 00+00

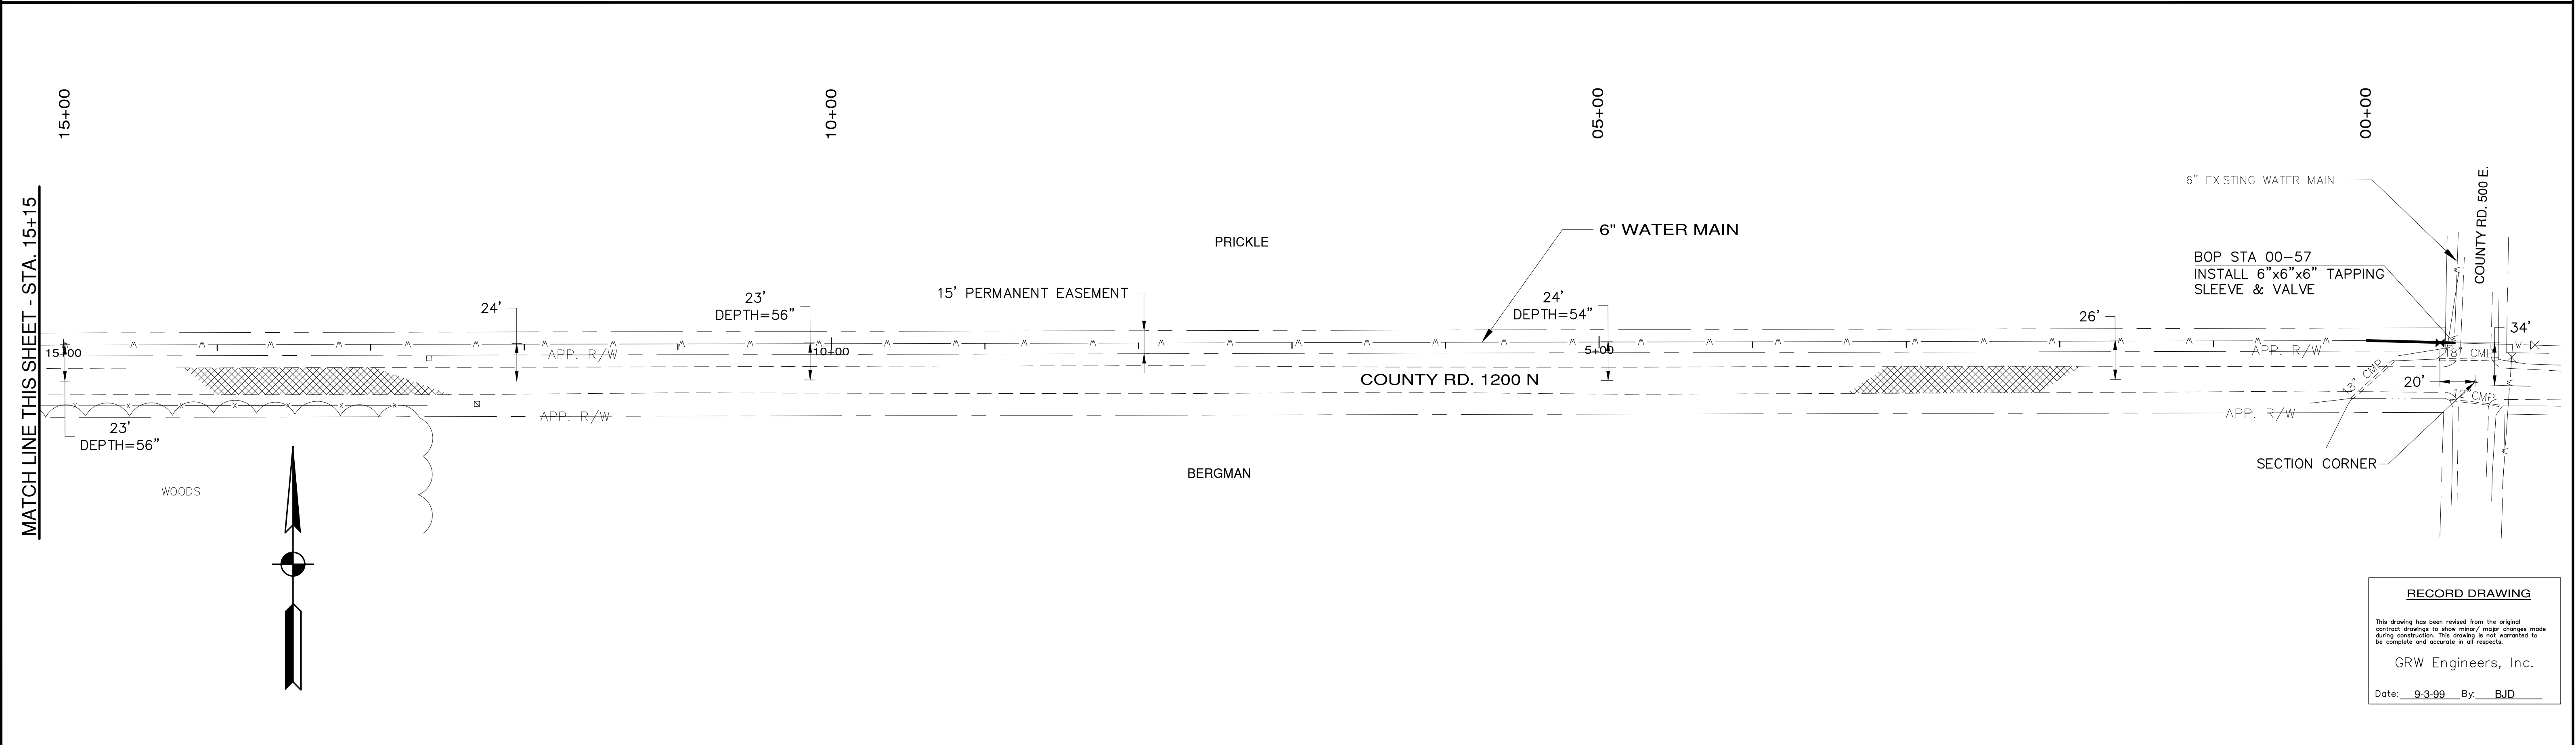

RECORD DRAWING

This drawing has been revised from the original contract drawings to show minor/major changes made during construction. This drawing is not guaranteed to be complete and accurate in all respects.

GRW Engineers, Inc.

Date: 9-3-99 By: BJD

NOTES:

NO.	DESCRIPTION	DATE	BY
2	RENUMBERED	6-03	GCR
1	AS-BUILT	9-99	BD
REVISIONS			

HOOSIER HILLS REGIONAL
WATER DISTRICT

NEAL SUBDIVISION WATER MAIN EXTENTION

GRW PROJECT NO. 2543-13



DRAWN: BJD	DATE: APRIL 1998
FILE NAME: SHT631.DWG	SCALE: 1"=50'
CHECKED: -	SHEET NO. 631
APPROVED: -	