


HOOSIER HILLS REGIONAL WATER DISTRICT PINE ROAD AT MORRIS ROAD WATER MAIN EXTENSION

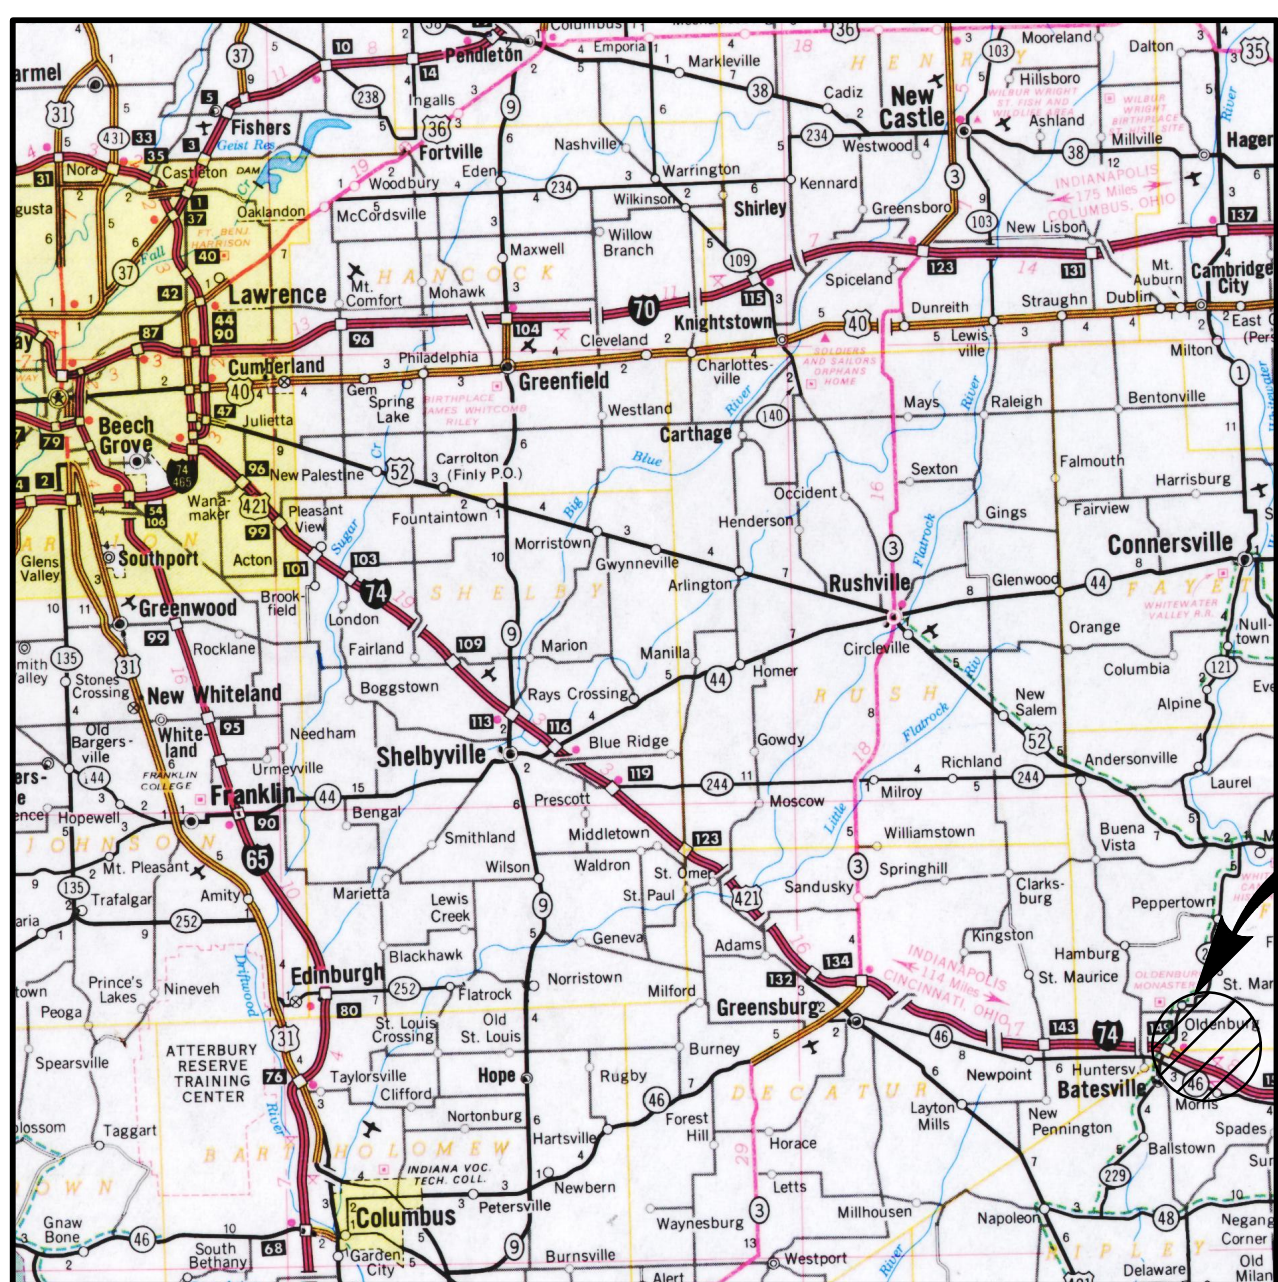


VICINITY MAP



GRW Engineers, Inc.
7112 WALDEMAR DR.
INDIANAPOLIS, IN. 46268
(317) 347-3650

INDIANAPOLIS, INDIANA
LEXINGTON & LOUISVILLE, KENTUCKY
NASHVILLE, TENNESSEE
ARLINGTON, TEXAS
CINCINNATI, OHIO

PROJECT LOCATION

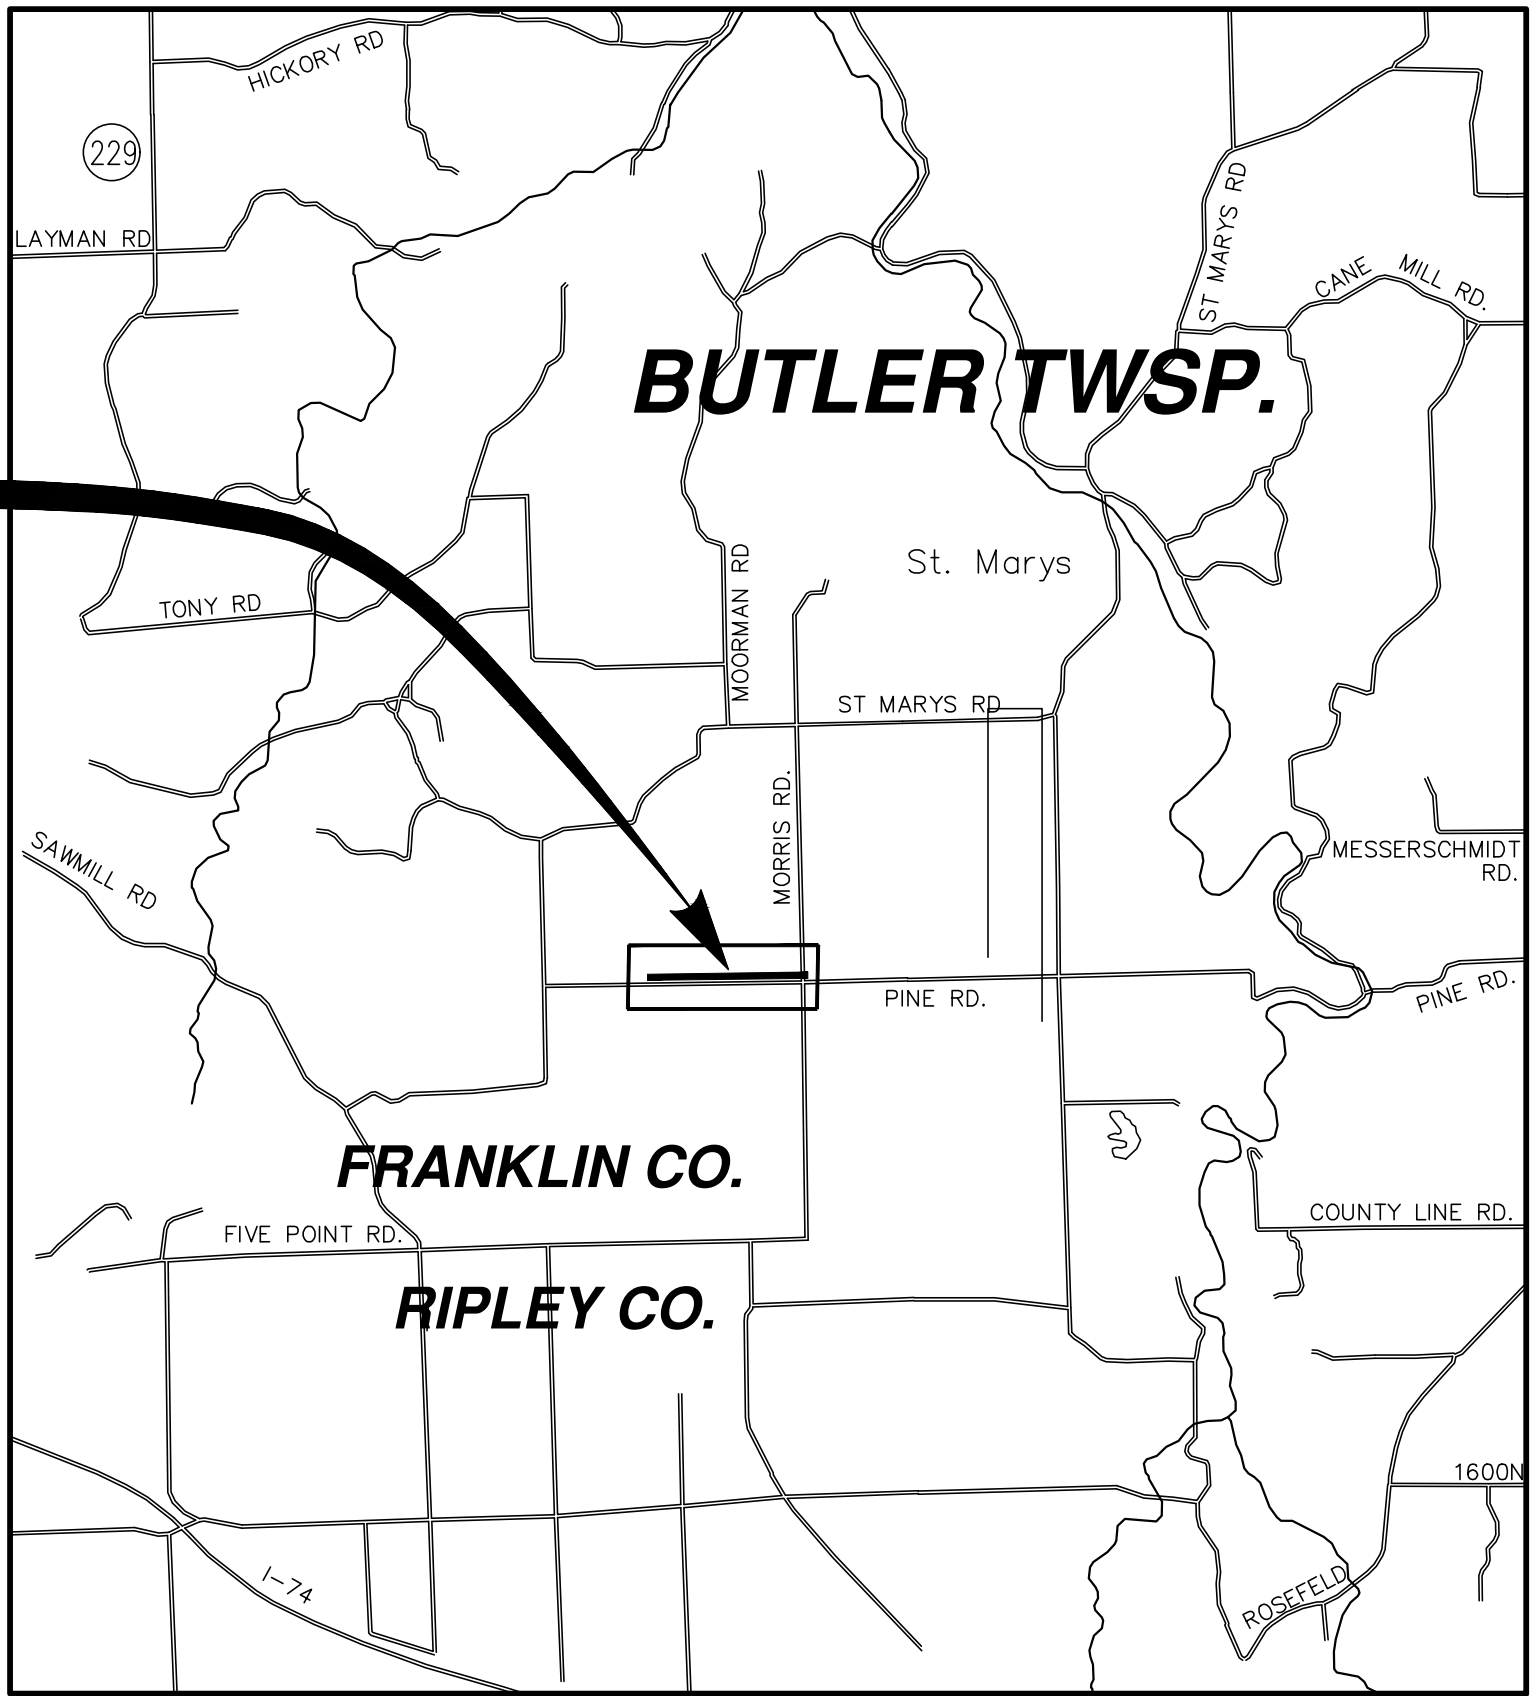

SITE LOCATION MAP

INDEX OF DRAWINGS	
SHEET NO.	DESCRIPTION
—	COVER SHEET
641	PLAN SHEET

RECORD DRAWING
This drawing has been revised from the original contract drawings to show minor map changes made during construction. This drawing is not warranted to be complete and accurate in all respects.
GRW Engineers, Inc.
Date: 8-8-01 By: M.A.T.

CERTIFIED _____ DATE _____
GREGORY A. WRIGHT, P.E.
INDIANA REG. NO. 19300607

