
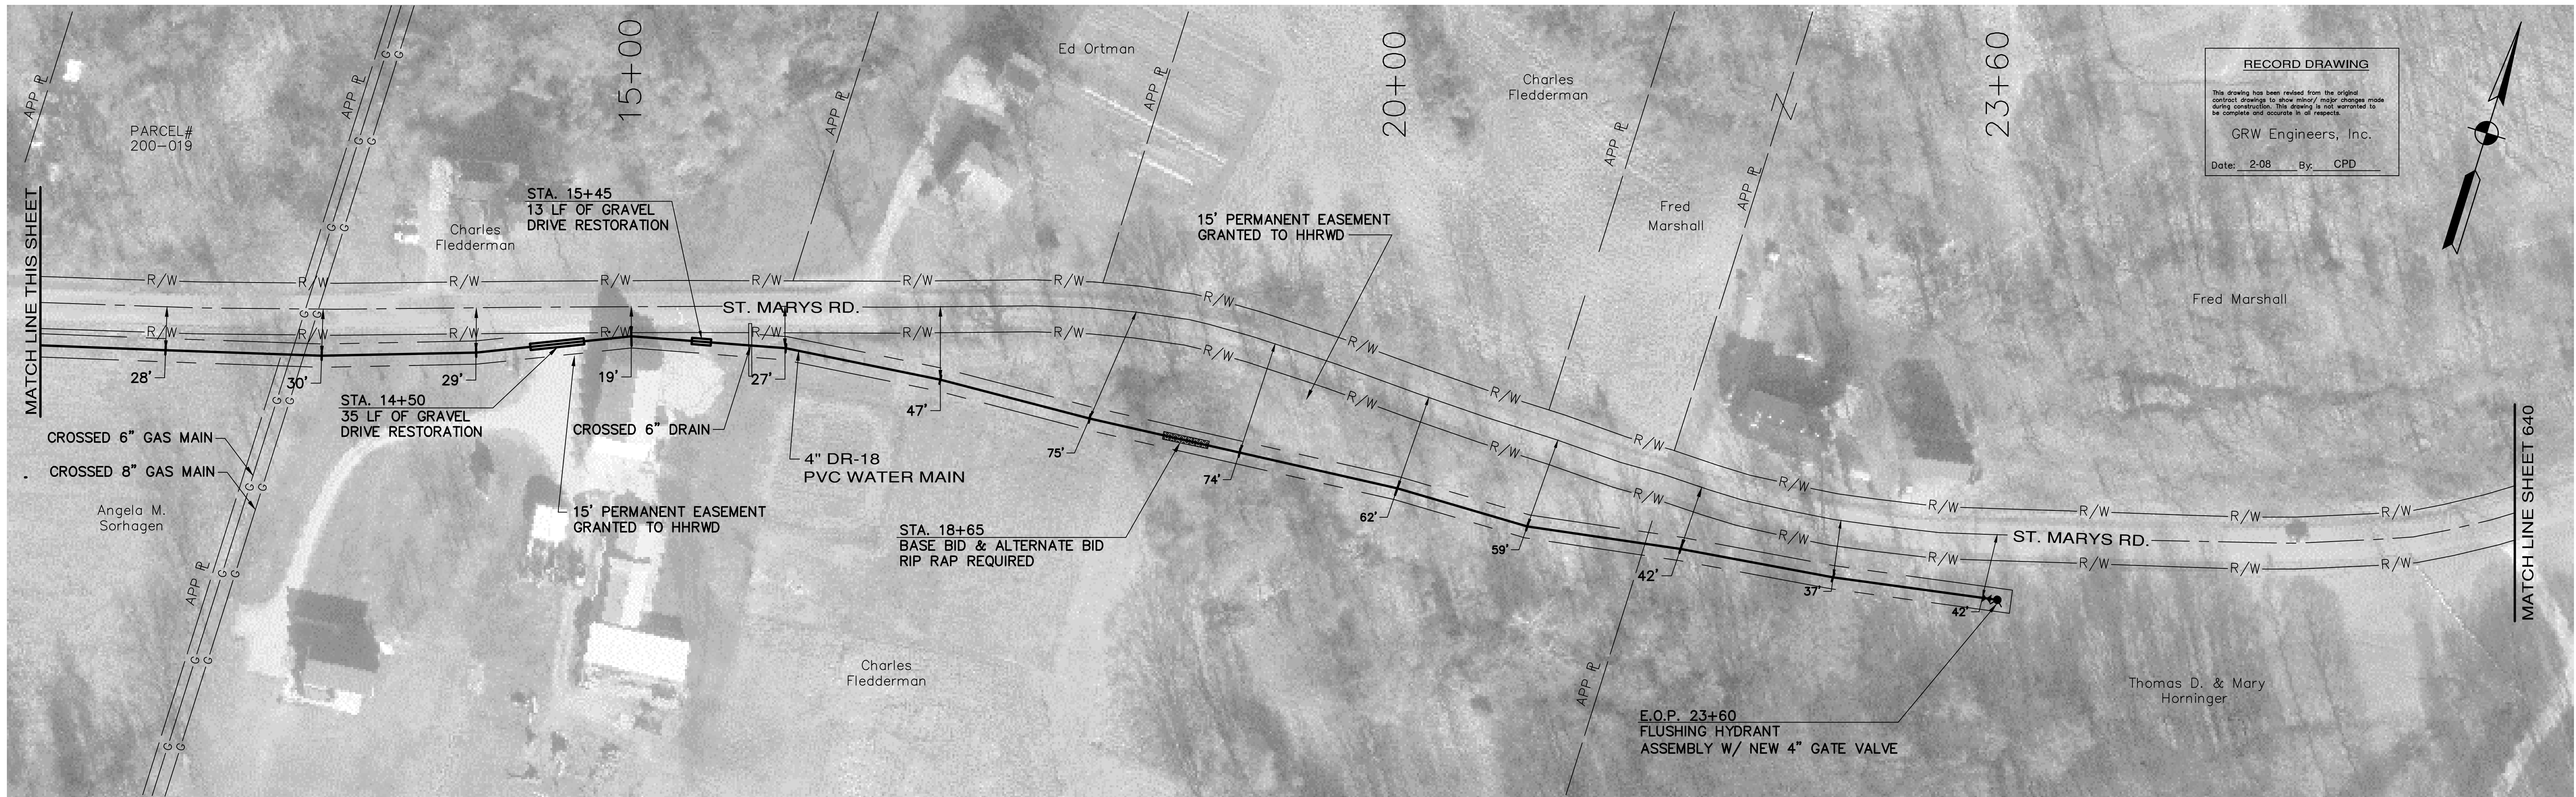


PRINTED: 3/10/2016 @ 10:22AM

FILE NAME: G:\3421-HHRWD Ann Retain\Sub-06 St. Mary's Rd\dwg\AS-BUILT\SHTE39-ASBUILT.dwg

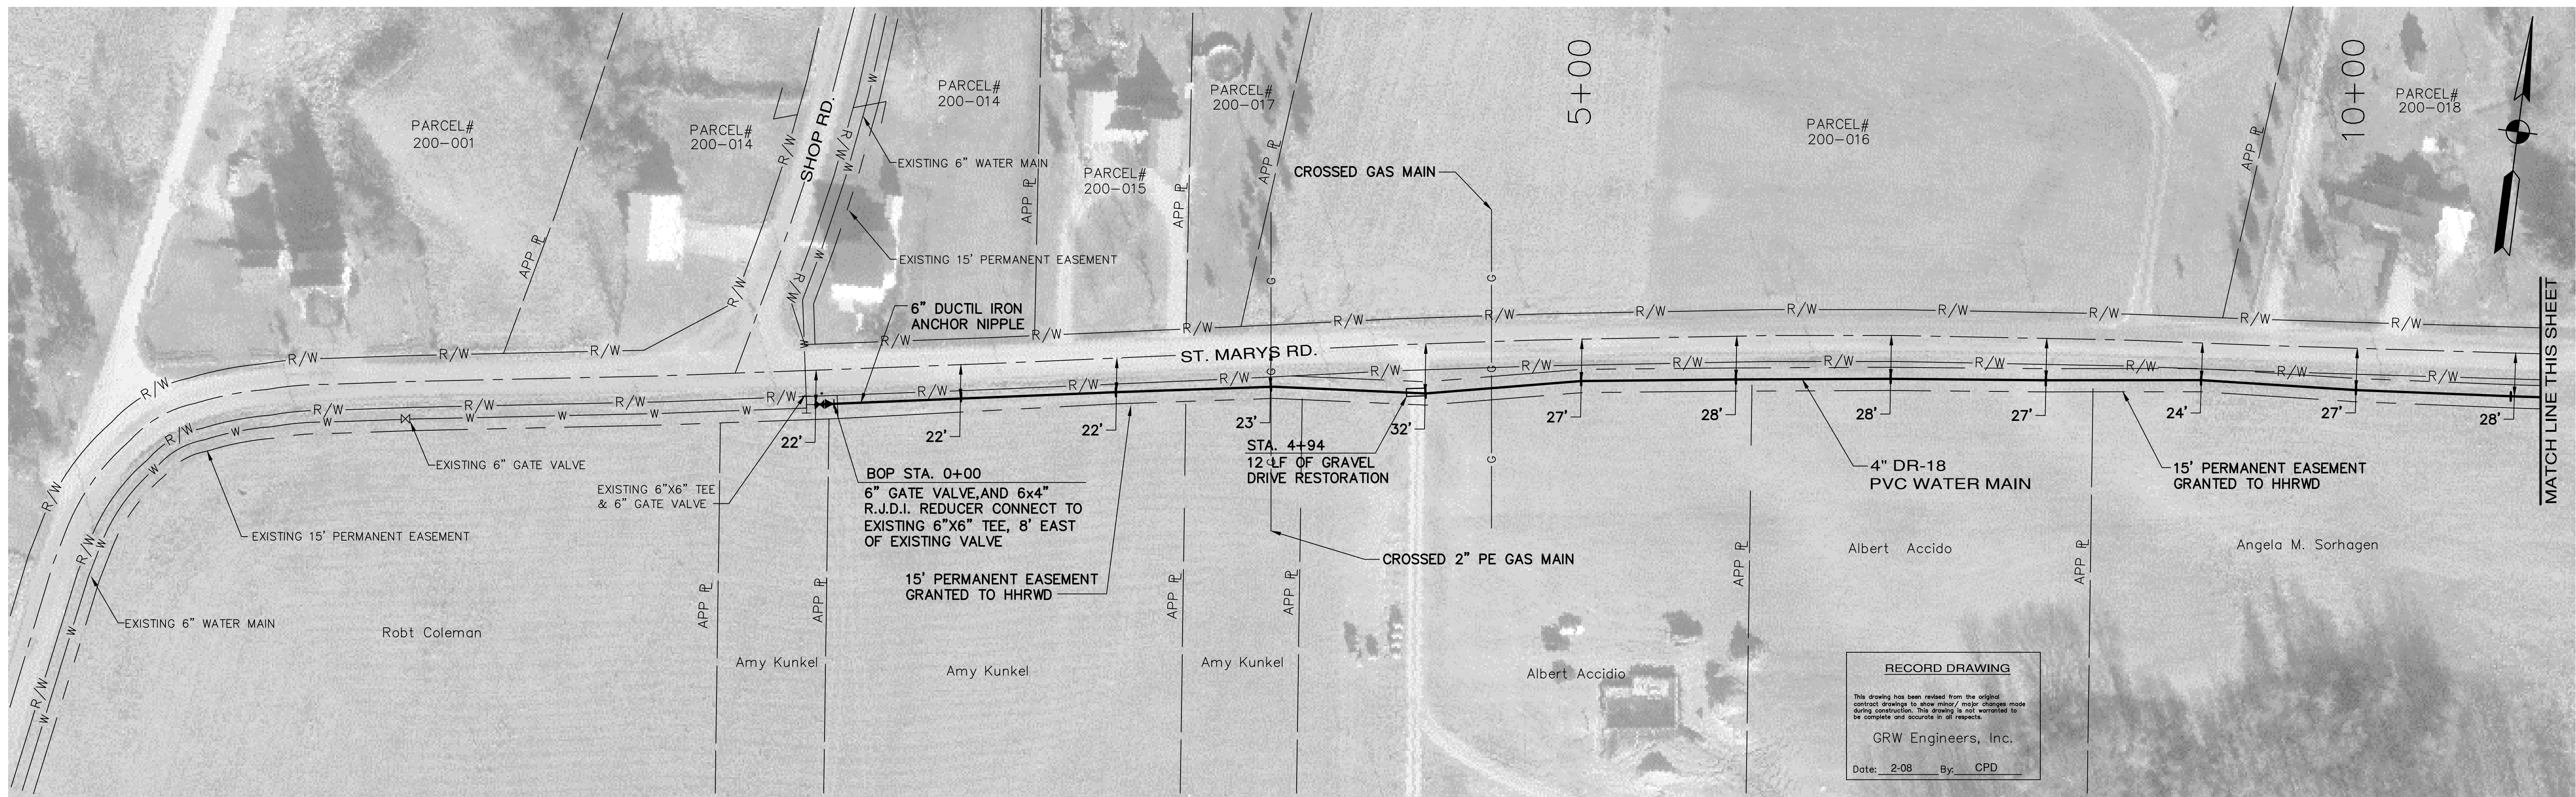

NOTES: 1). THE UTILITIES AND THEIR LOCATION SHOWN ON PLANS ARE APPROXIMATE. CONTRACTOR SHALL VERIFY ALL UTILITIES IN THE FIELD AND NOTIFY ALL UTILITY COMPANIES PRIOR TO INSTALLATION OF THE WATER LINE.
2). ALL PIPING SHALL BE CLASS 900 PVC UNLESS OTHERWISE NOTED.
3). 48" MINIMUM COVER REQUIRED OVER TOP OF WATER LINE.

NO.	DESCRIPTION	DATE	BY
2	AS-BUILT REVISIONS	2-08	CPD
1	RENUMBERED	6-03	GCR
REVISIONS			

HOOSIER HILLS REGIONAL
WATER DISTRICT

ST. MARY'S ROAD WATER MAIN EXTENSION

GRW PROJECT NO. 3421-06

GRW
GRW Engineers, Inc.
Engineers, Architects, Planners
INDIANAPOLIS, INDIANA
LOUISVILLE & LEXINGTON, KENTUCKY
CINCINNATI, OHIO
E. & NASHVILLE, TENNESSEE
ARLINGTON, TEXAS

DRAWN: GCR	DATE: MAY 2006
FILE NAME: SHT639.DWG	SCALE: 1"=50'
CHECKED: DRC	SHEET NO.
APPROVED:	639