


HOOSIER HILLS REGIONAL WATER DISTRICT


STATE ROAD 129 SUBDIVISION

WATER MAIN EXTENSION

SITE VICINITY MAP

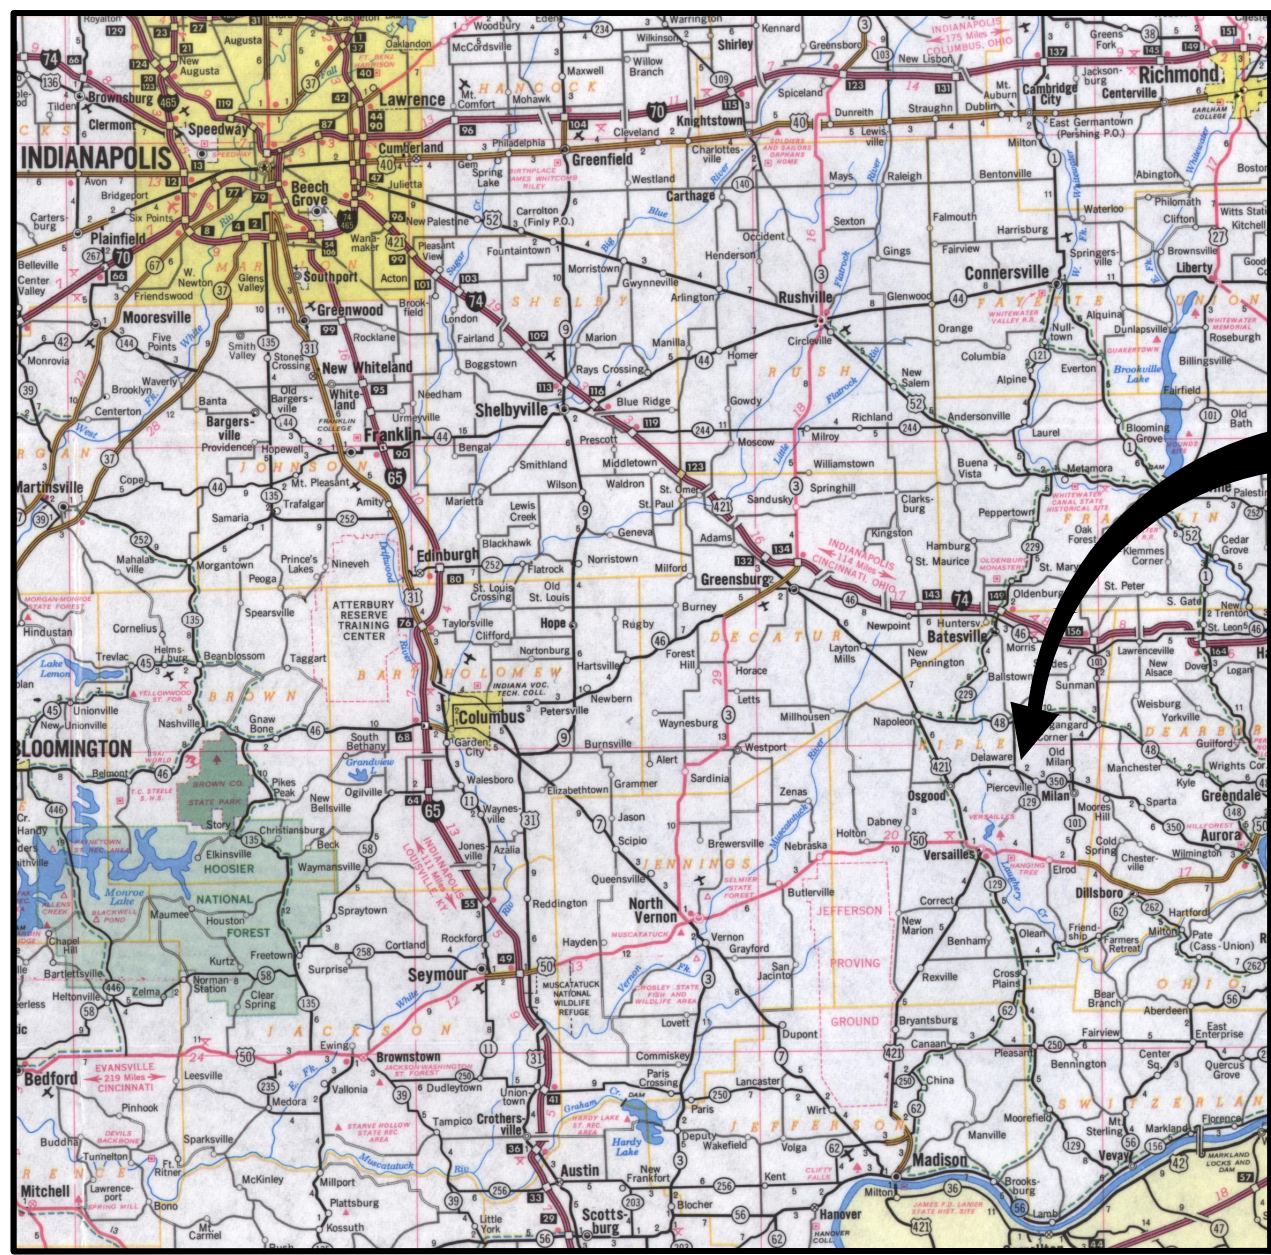


PROJECT LOCATION

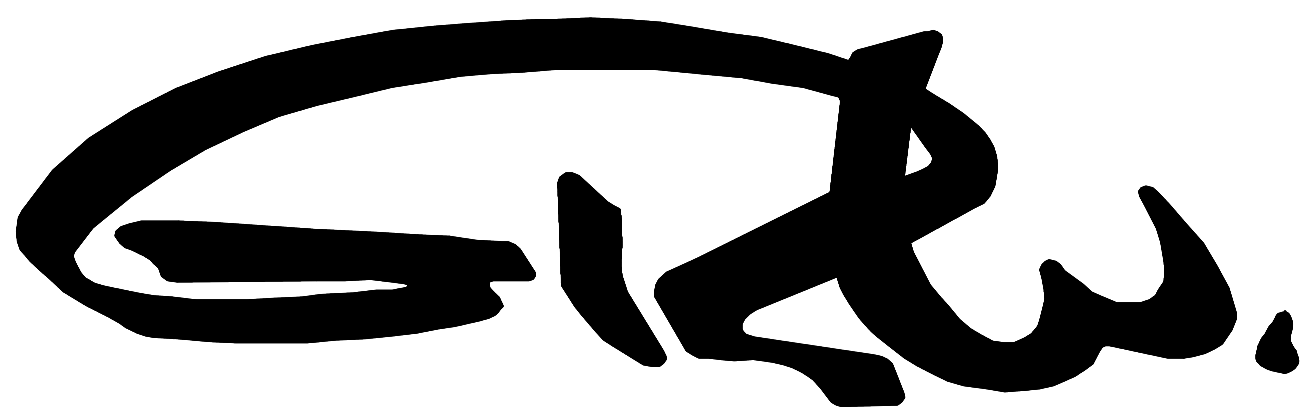

GRW Engineers, Inc.
7112 WALDEMAR DRIVE
INDIANAPOLIS, IN. 46268
(317) 347-3650

INDIANAPOLIS, INDIANA
LEXINGTON & LOUISVILLE, KENTUCKY
NASHVILLE, TENNESSEE
ARLINGTON, TEXAS
CINCINNATI, OHIO

SITE LOCATION MAP

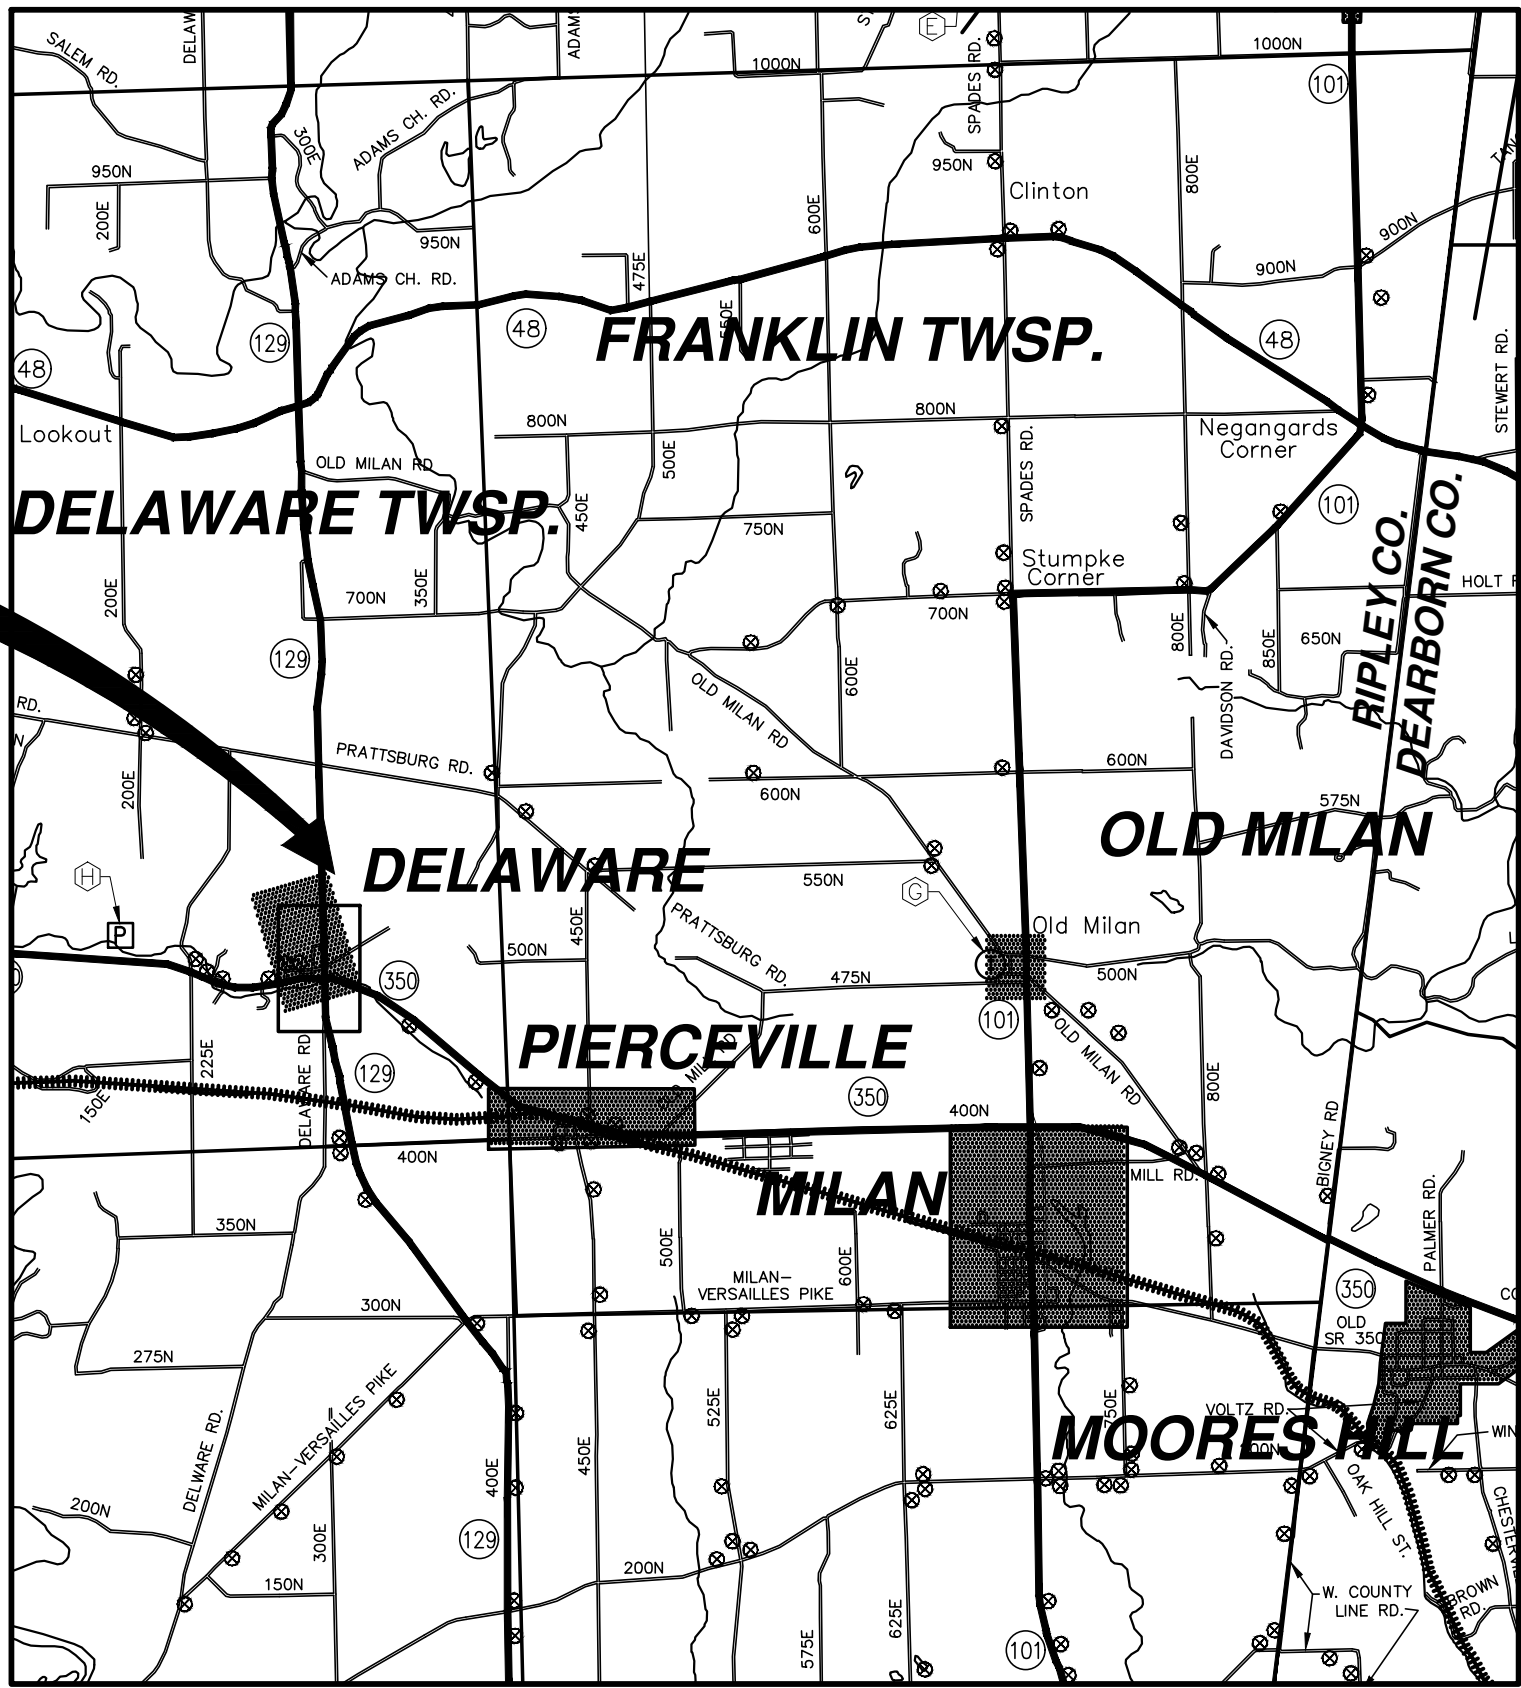

INDEX OF DRAWINGS

SHEET NO.	DESCRIPTION
---	COVER SHEET
655	STATE ROAD 129 WATER MAIN EXTENSION

RECORD DRAWING

This drawing has been revised from the original contract drawings to show minor / major changes made during construction. This drawing is not warranted to be complete and accurate in all respects.


GRW Engineers, Inc.

Date: 09/07/04 By: CC

FEBRUARY 2003

GREGORY A. WRIGHT, P.E.
INDIANA REG. NO. 19300607

DATE 07 FEBRUARY 2003

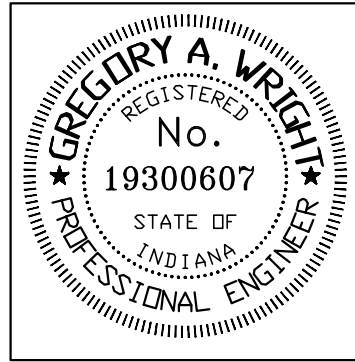

GRW PROJECT NO. 2543-37