 



HOOSIER HILLS REGIONAL WATER DISTRICT WERNER WATER MAIN EXTENSION




VICINITY MAP

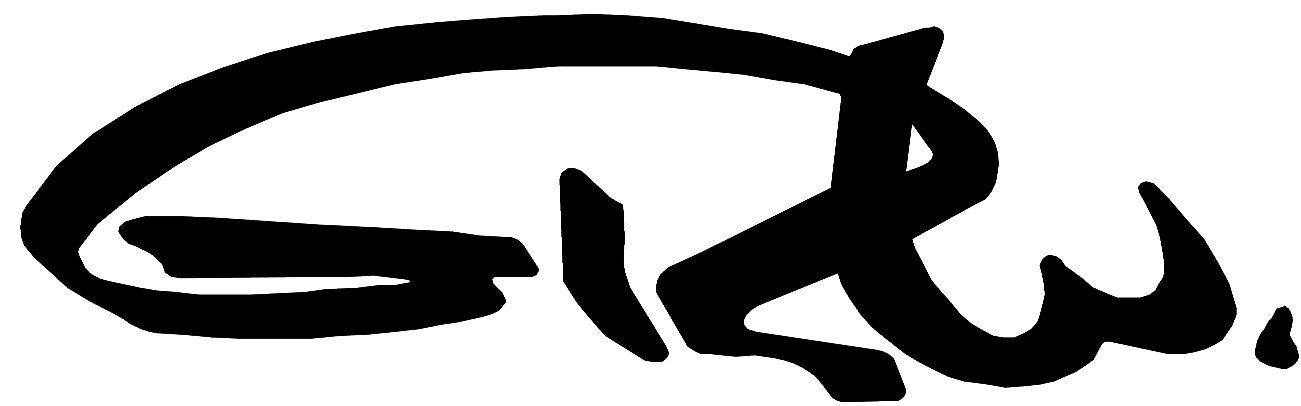

GRW Engineers, Inc.
7112 WALDEMAR DR.
INDIANAPOLIS, IN. 46268
(317) 347-3650

INDIANAPOLIS, INDIANA
LEXINGTON & LOUISVILLE, KENTUCKY
NASHVILLE, TENNESSEE
ARLINGTON, TEXAS
CINCINNATI, OHIO

PROJECT LOCATION

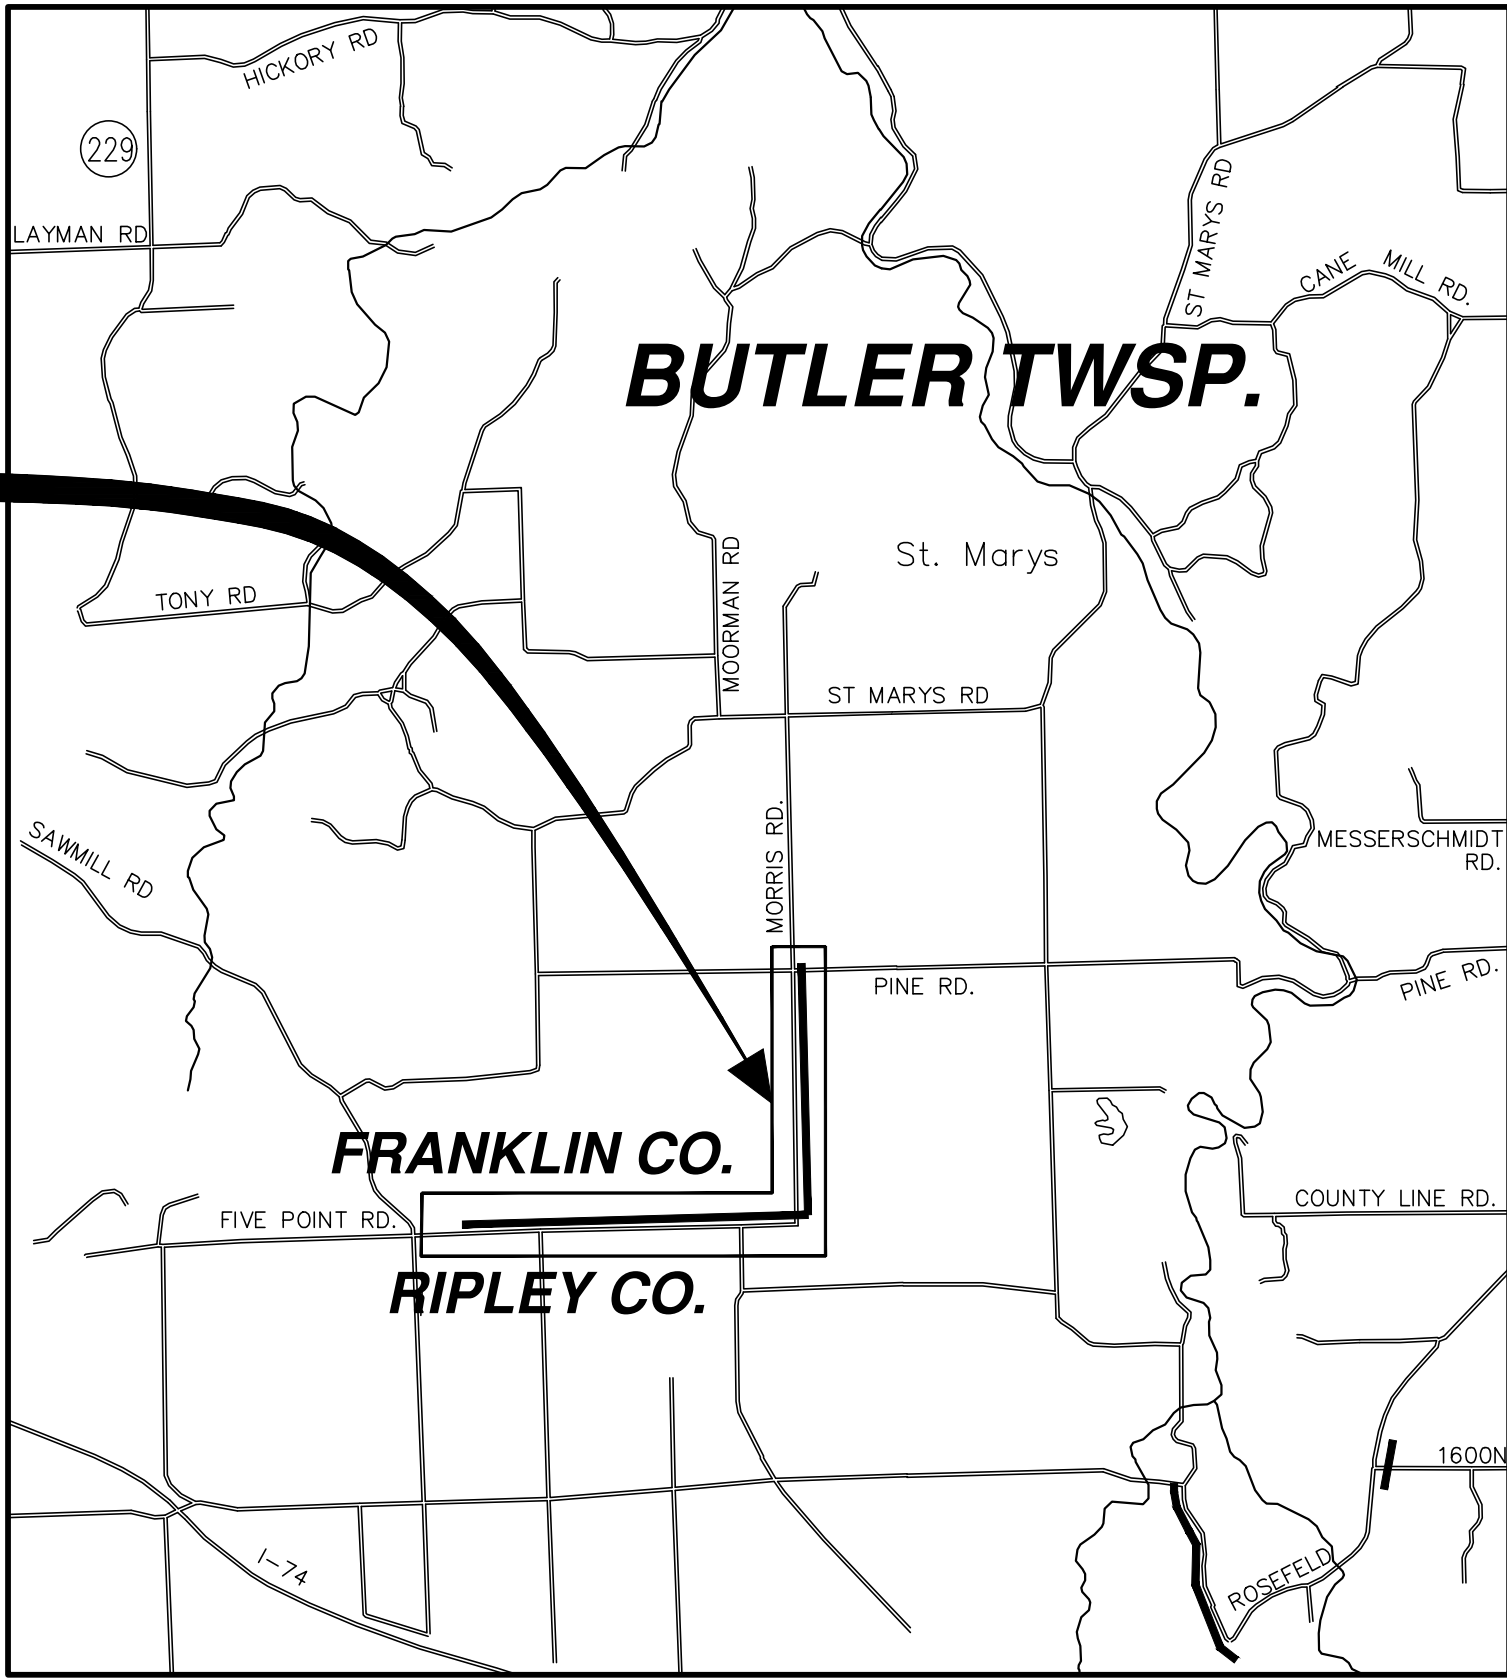

SITE LOCATION MAP

INDEX OF DRAWINGS	
SHEET NO.	DESCRIPTION
—	COVER SHEET
632-633	PLAN SHEETS

APRIL 1999

RECORD DRAWING
This drawing has been revised from the original contract drawings to show minor / major changes made during construction. This drawing is not warranted to be complete and accurate in all respects.
GRW Engineers, Inc.
Date: 2-8-2000 By: S. Sheehan

CERTIFIED GREGORY A. WRIGHT, P.E. DATE _____
INDIANA REG. NO. 19300607

