


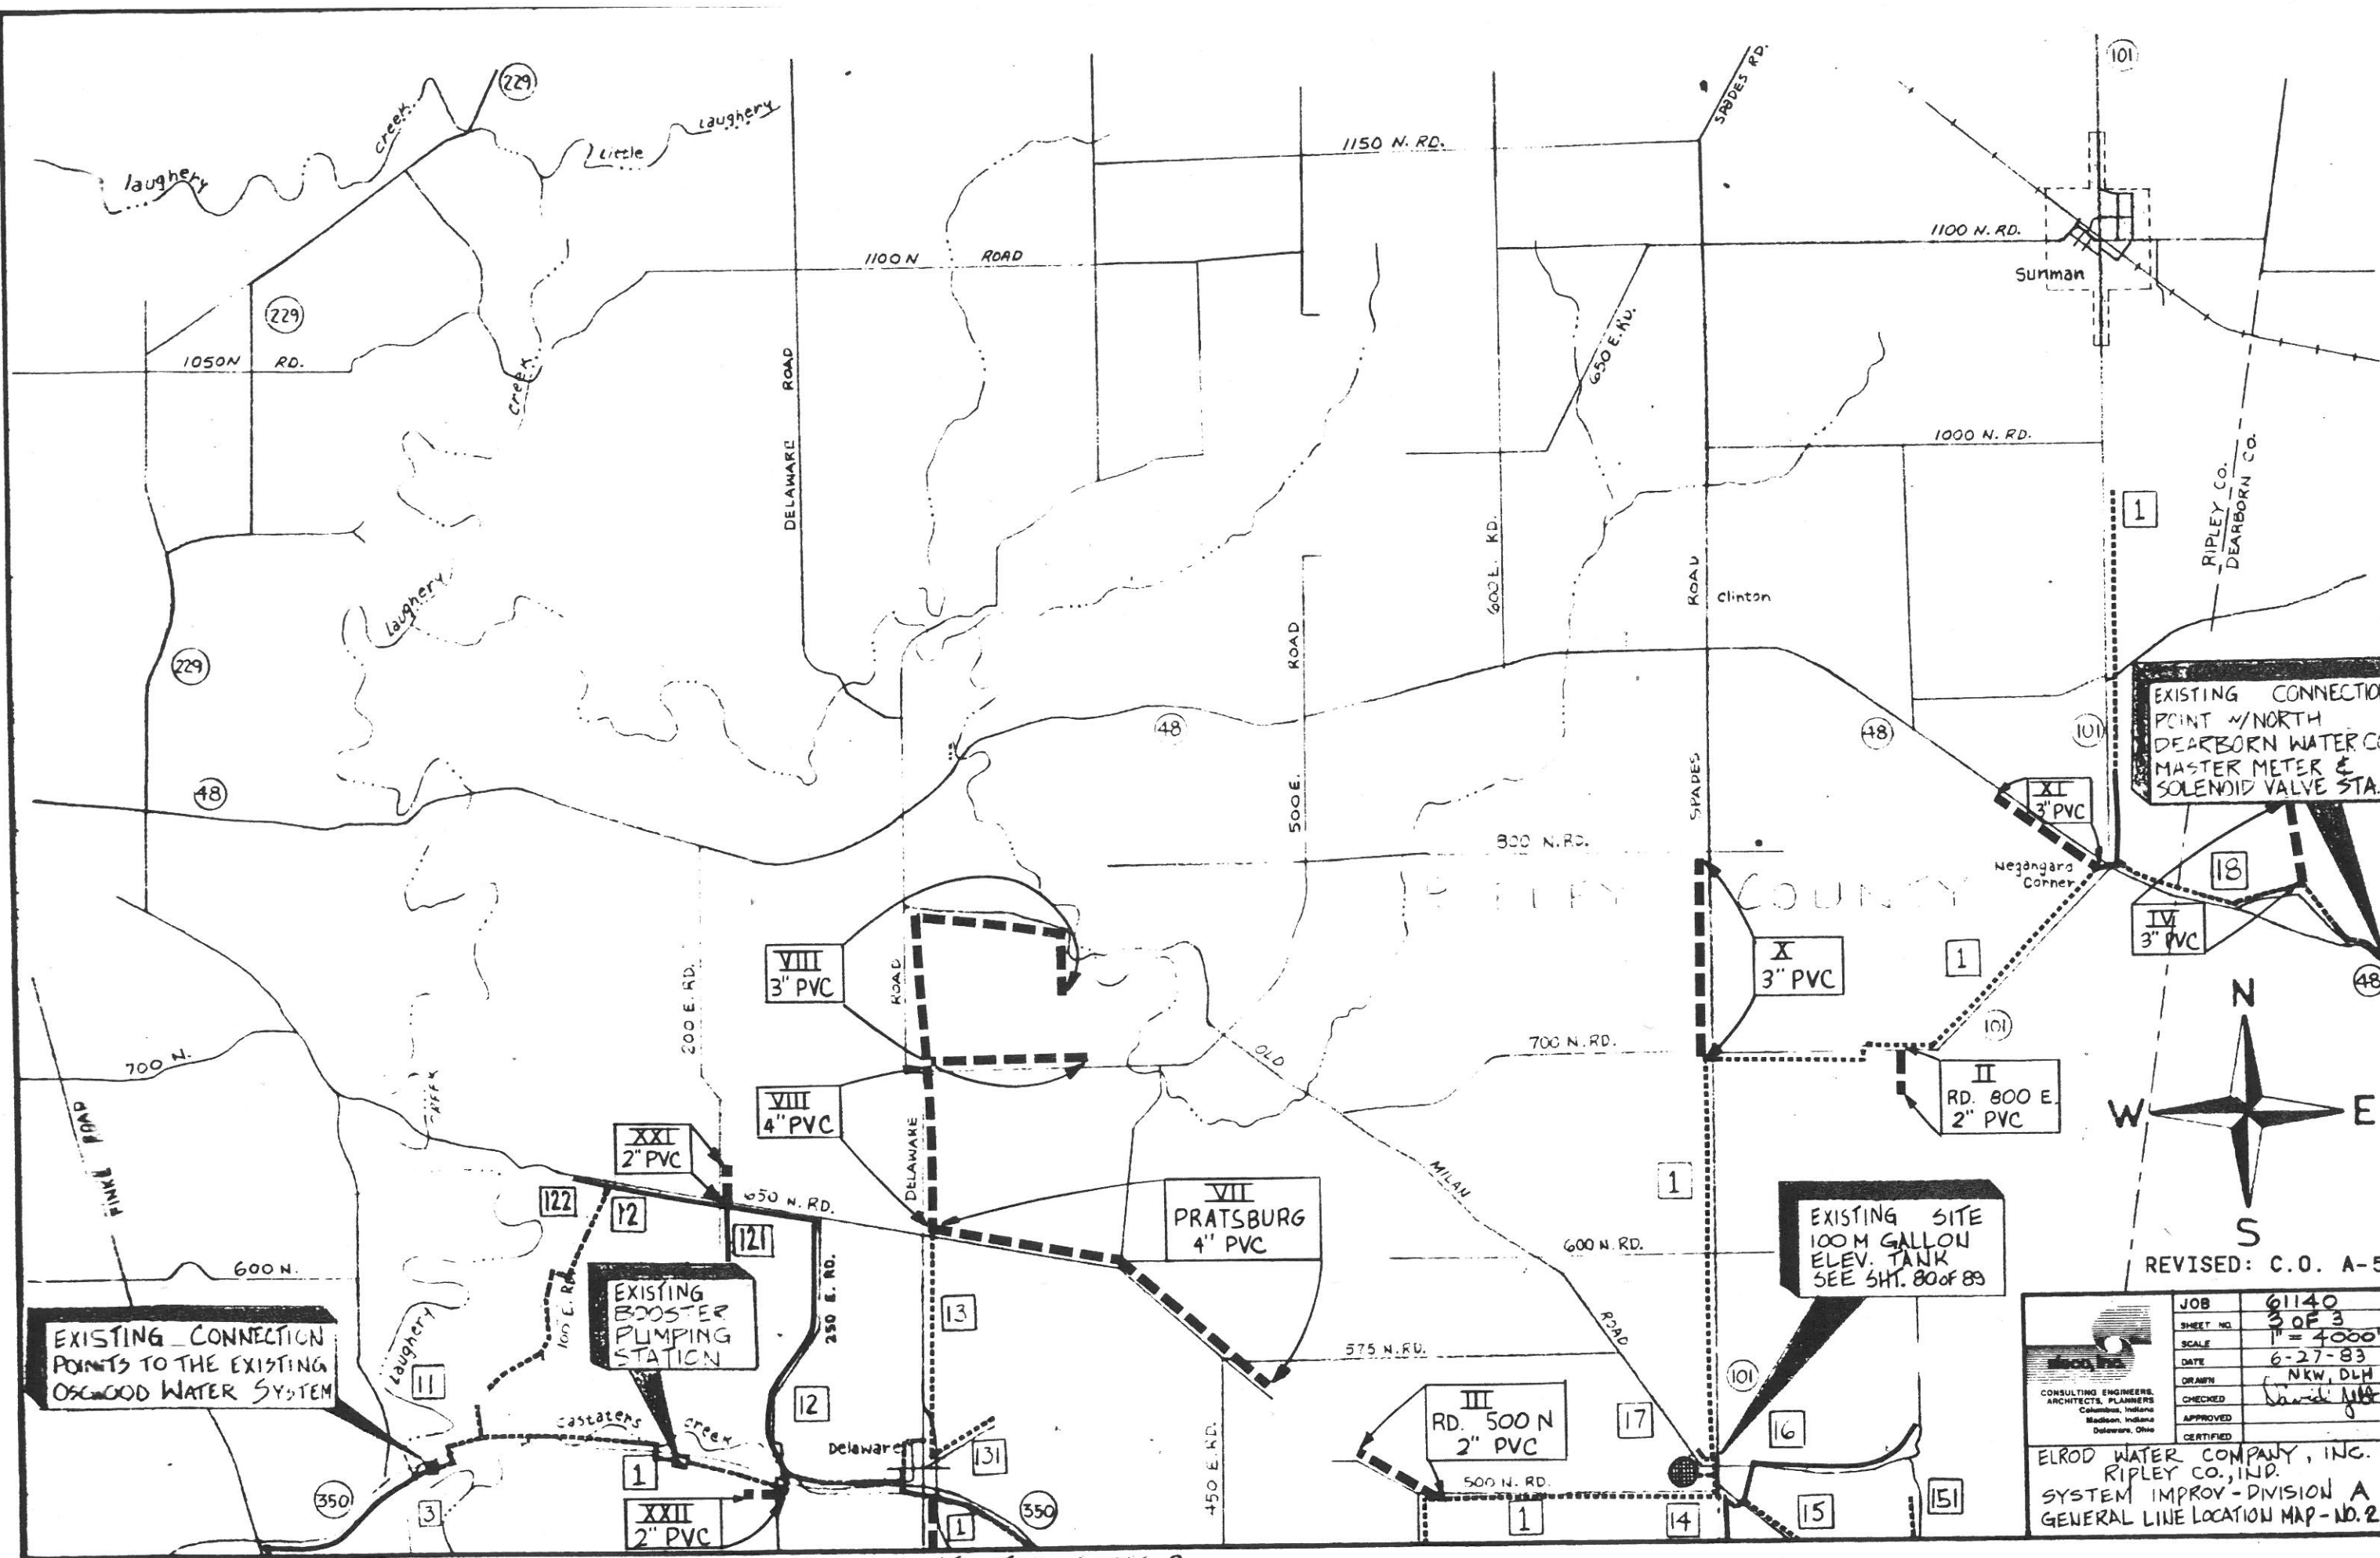


EXISTING CONNECTION
POINT W/NORTH
DEARBORN WATER CO
MASTER METER &
SOLENOID VALVE STA.

EXISTING CONNECTION
POINTS TO THE EXISTING
OSGOOD WATER SYSTEM

EXISTING BOOSTER
PUMPING
STATION

EXISTING SITE
100 M GALLON
ELEV. TANK
SEE SH. 80 OF 89

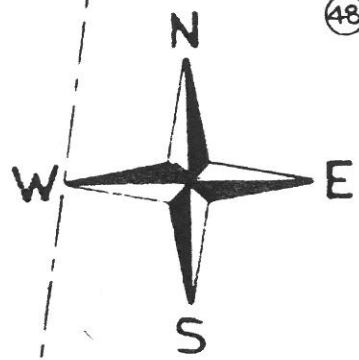

REVISED: C.O. A-5

JOB	61140
SHEET NO.	3 OF 3
SCALE	1" = 4000'
DATE	6-27-83
DRAWN	NKW, DLH
CHECKED	David J. [Signature]
APPROVED	
CERTIFIED	
ELROD WATER COMPANY, INC. RIPLEY CO., IND. SYSTEM IMPROV - DIVISION A GENERAL LINE LOCATION MAP - NO. 2	

MATCH LINE TOP SHEET 2