


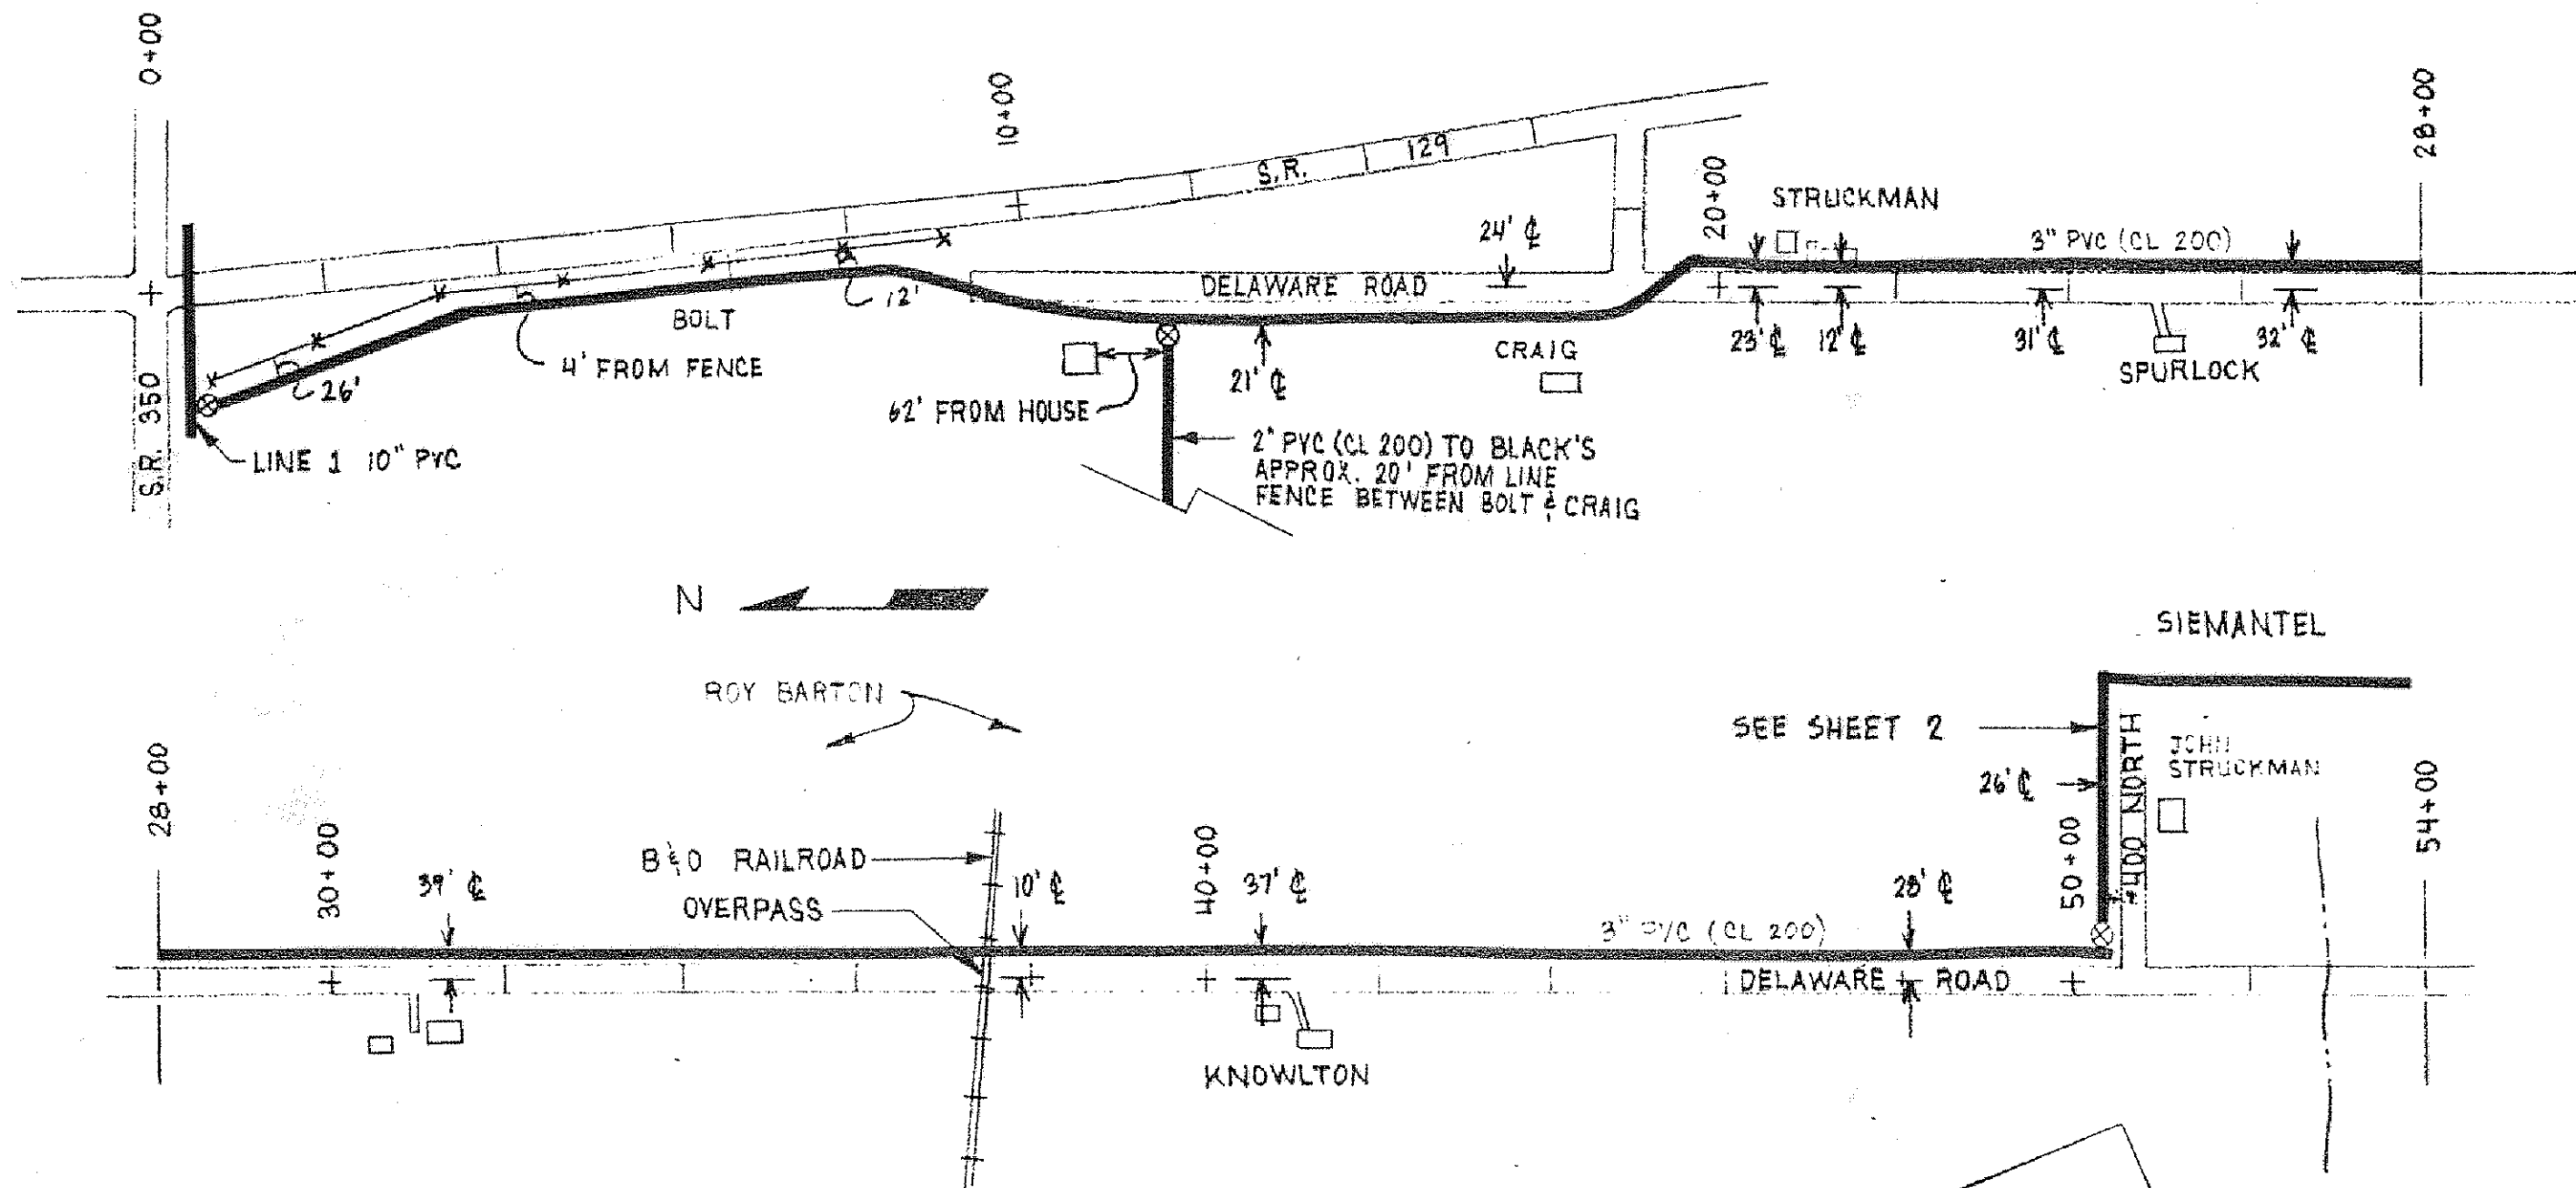

AS BUILT
 Date 1-16-84 By MAS

	JOB	61140
	SHEET NO.	1 OF 26
	SCALE	1" = 200'
	DATE	7-14-83
	DRAWN	M. SEEVERS
	CHECKED	
ELROD WATER CO., INC.		
RIPLEY CO., IND.		
LINE I		