


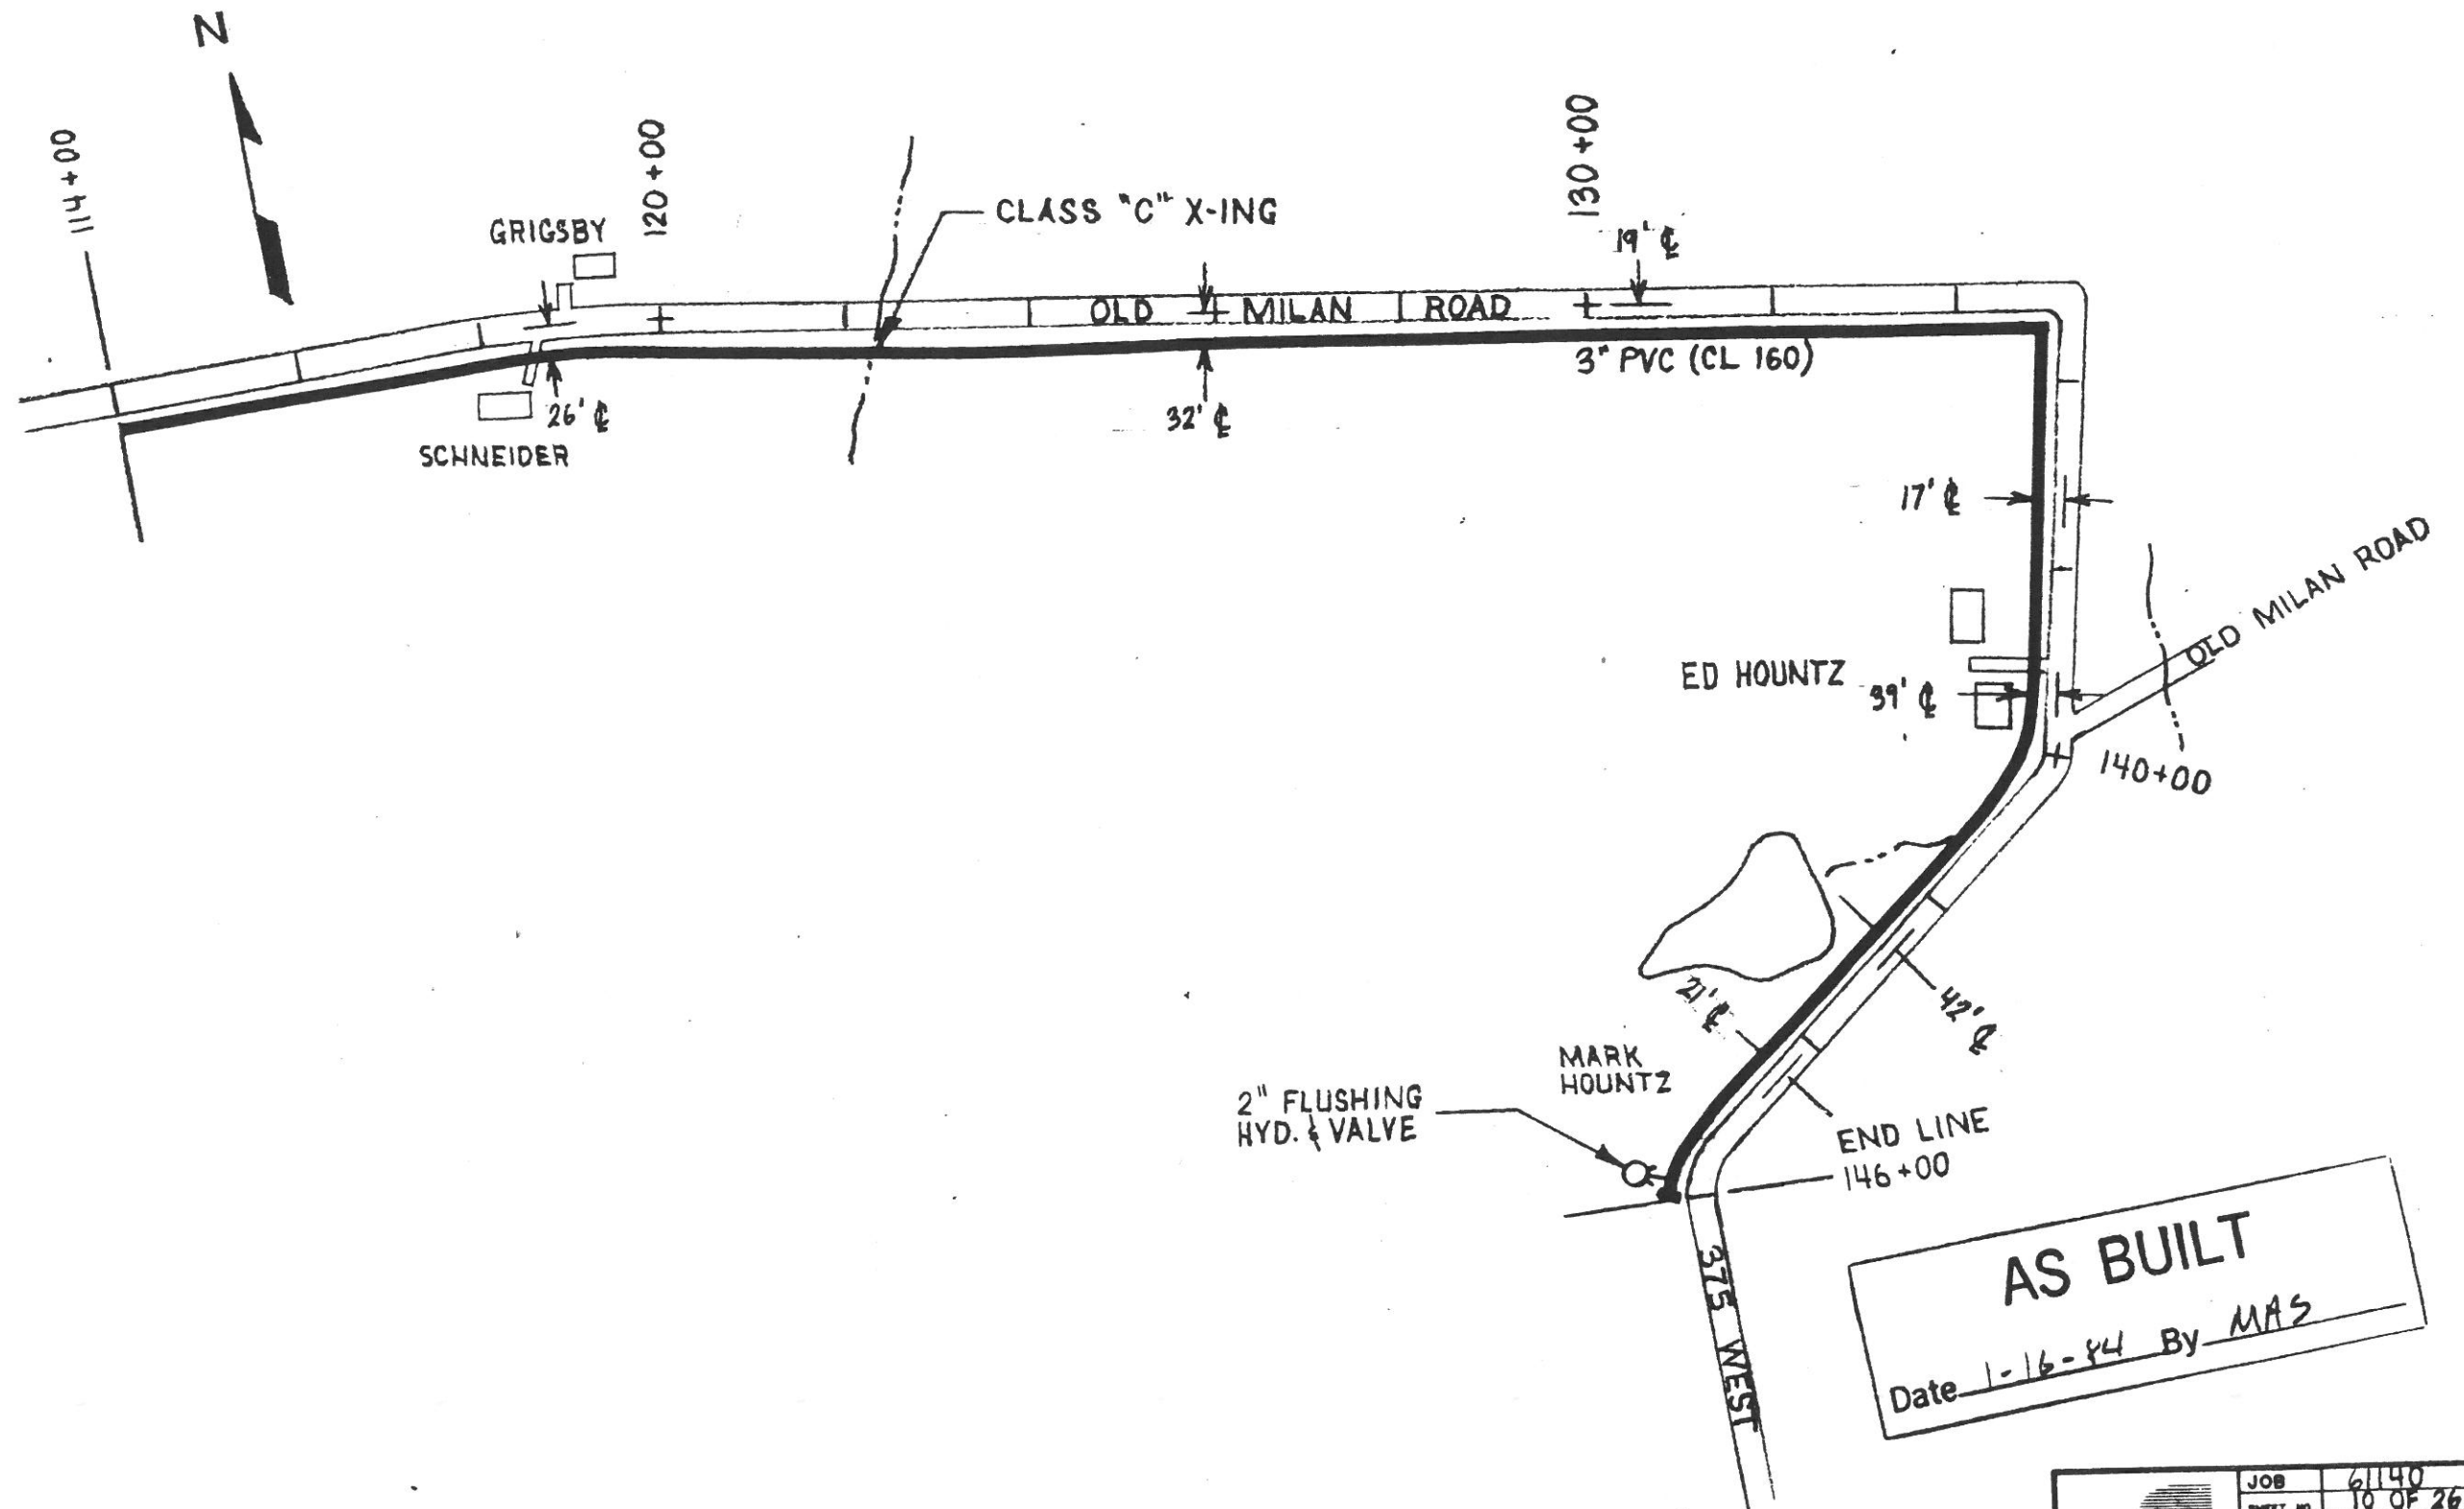

AS BUILT
 Date 1-16-84 By MAS

	JOB	61140
	SHEET NO.	10 OF 26
	SCALE	1" = 200'
	DATE	7-12-83
	DRAWN	M. SEEVERS
	CHECKED	
CONSULTING ENGINEERS, ARCHITECTS, PLANNERS		
APPROVED		
CERTIFIED		
ELROD WATER CO., INC. RIPLEY CO., IND. LINE VIII		