


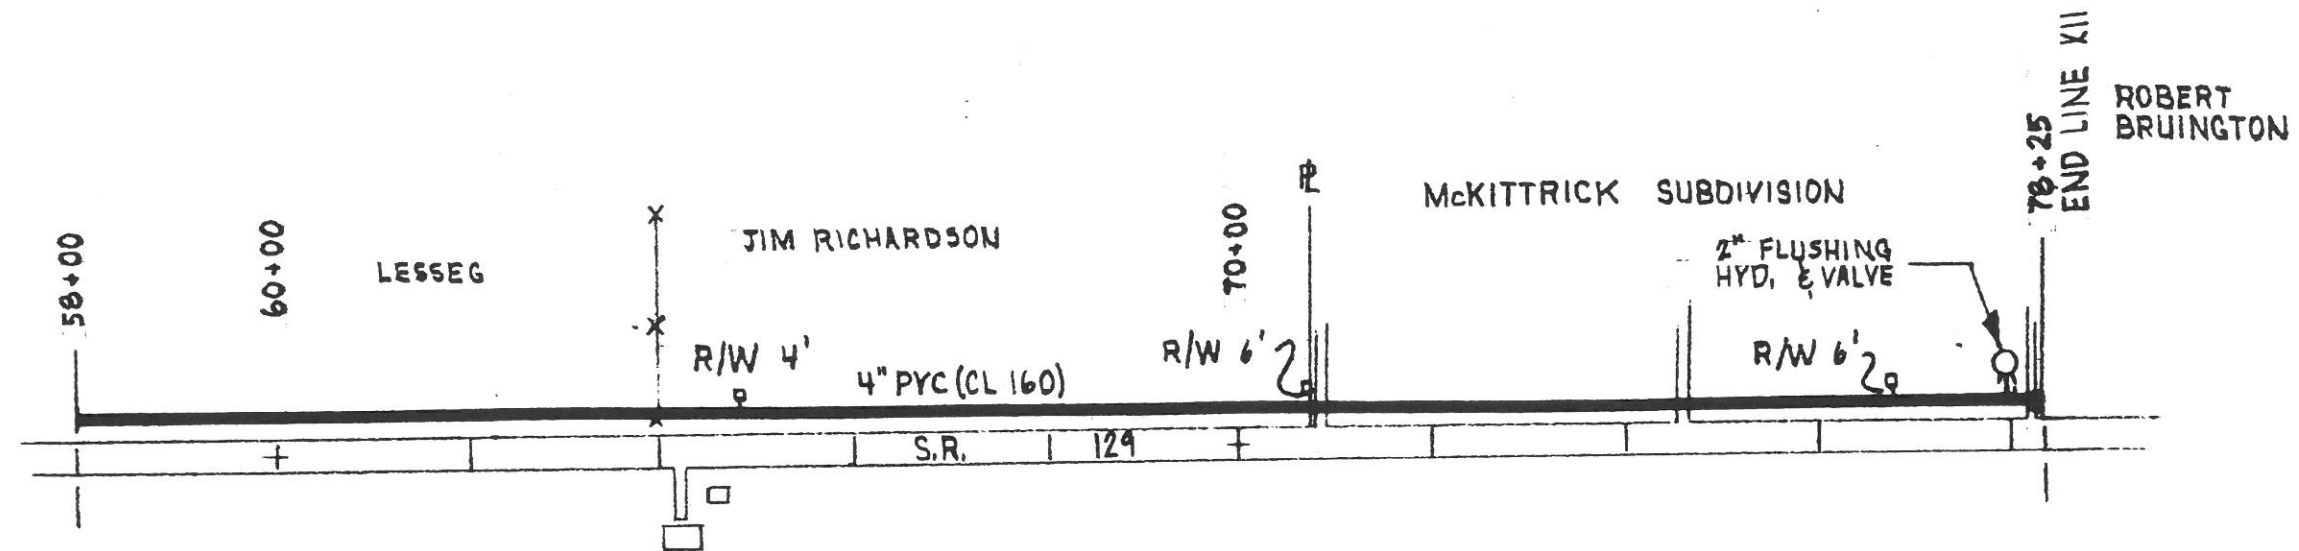

N

AS BUILT
 Date 1-16-64 By MAS

 CONSULTING ENGINEERS, ARCHITECTS, PLANNERS	JOB	61140
	SHEET NO.	15 OF 26
	SCALE	1" = 200'
	DATE	8-3-83
	DRAWN	M. SEEYERS
	CHECKED	
APPROVED		
CERTIFIED		

ELROD WATER CO., INC.
 RIPLEY CO., IND.
 LINES XII