
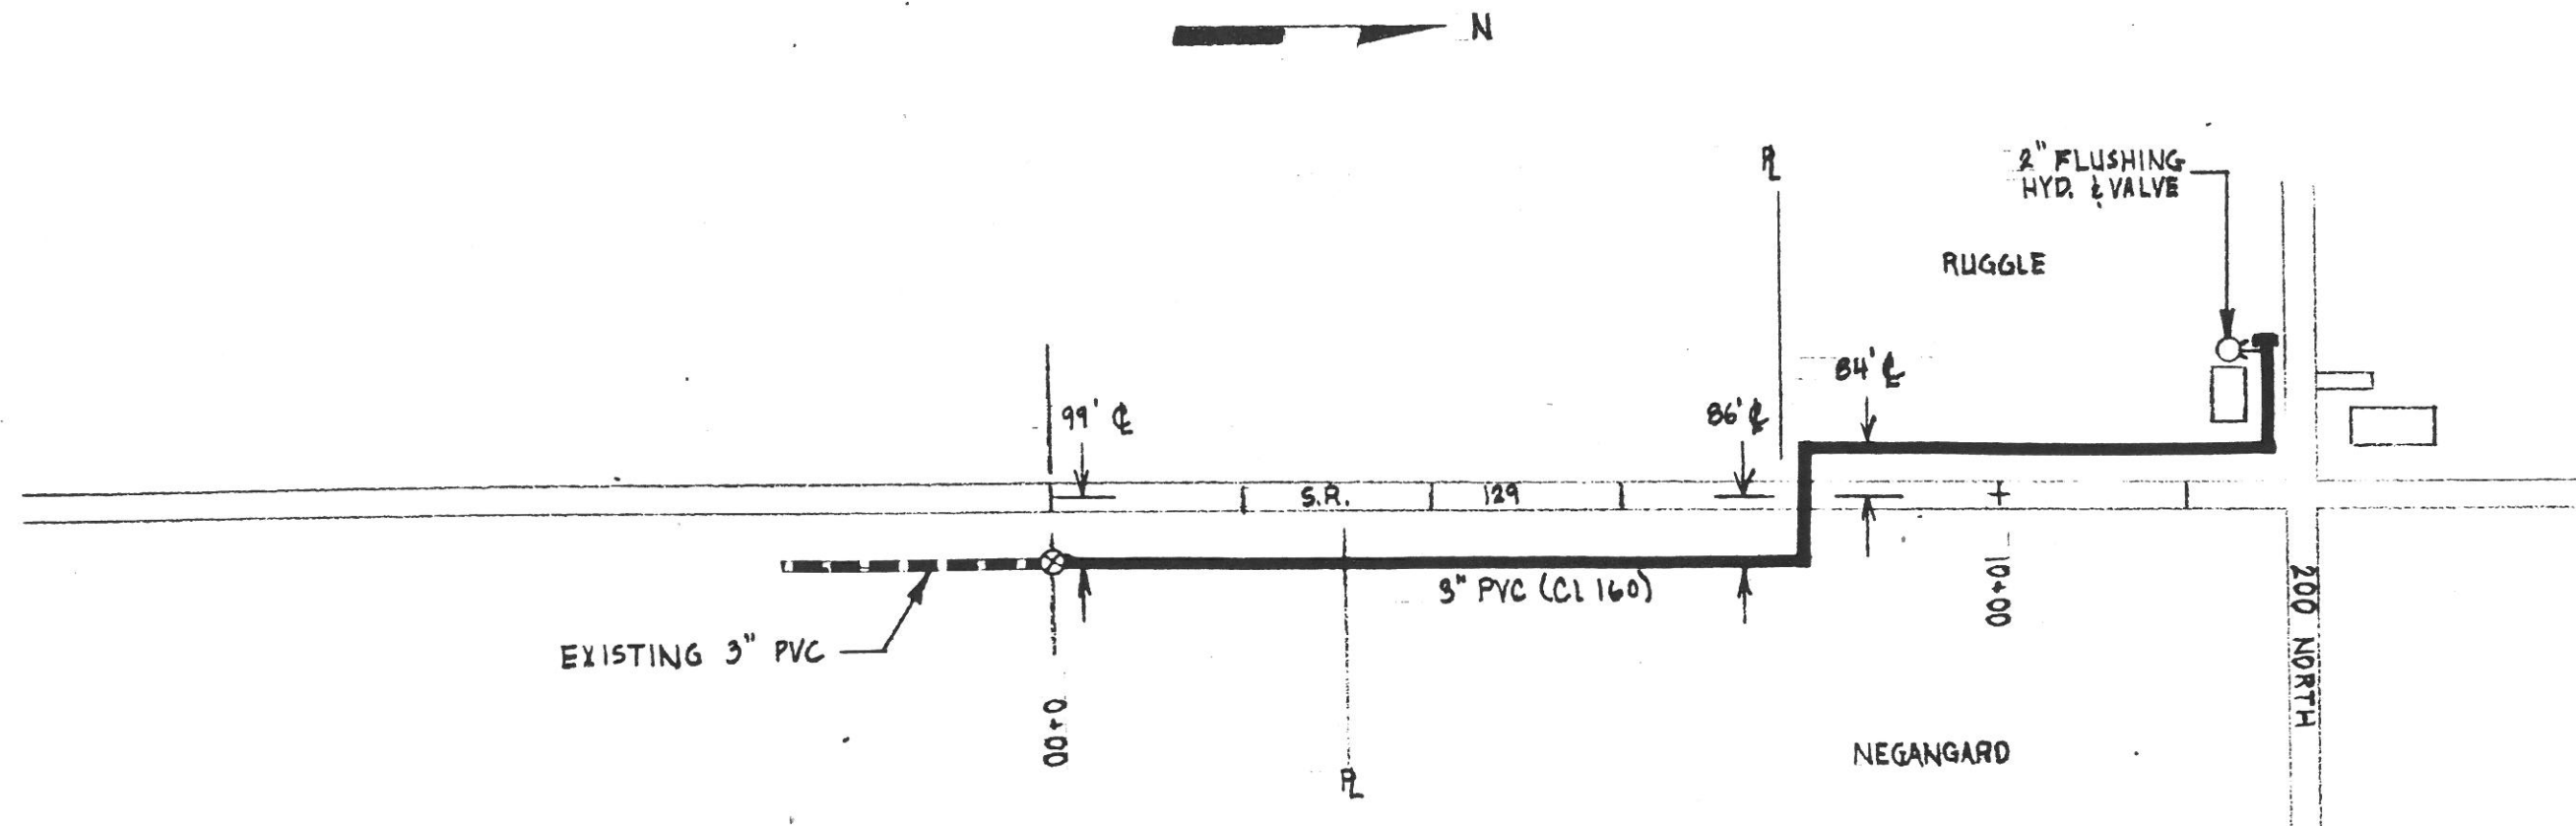


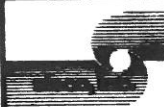

AS BUILT
 Date 1-16-84 By MAS

 CONSULTING ENGINEER ARCHITECTURAL PLANNERS	JOB	61140
	SHEET NO.	16 OF 26
	SCALE	1" = 20'
	DATE	12-23-83
	DRAWN	M. SEEVERS
	CHECKED	
	APPROVED	
	CERTIFIED	
ELROD WATER CO., INC. RIPLEY CO., IND. LINE XIII		