


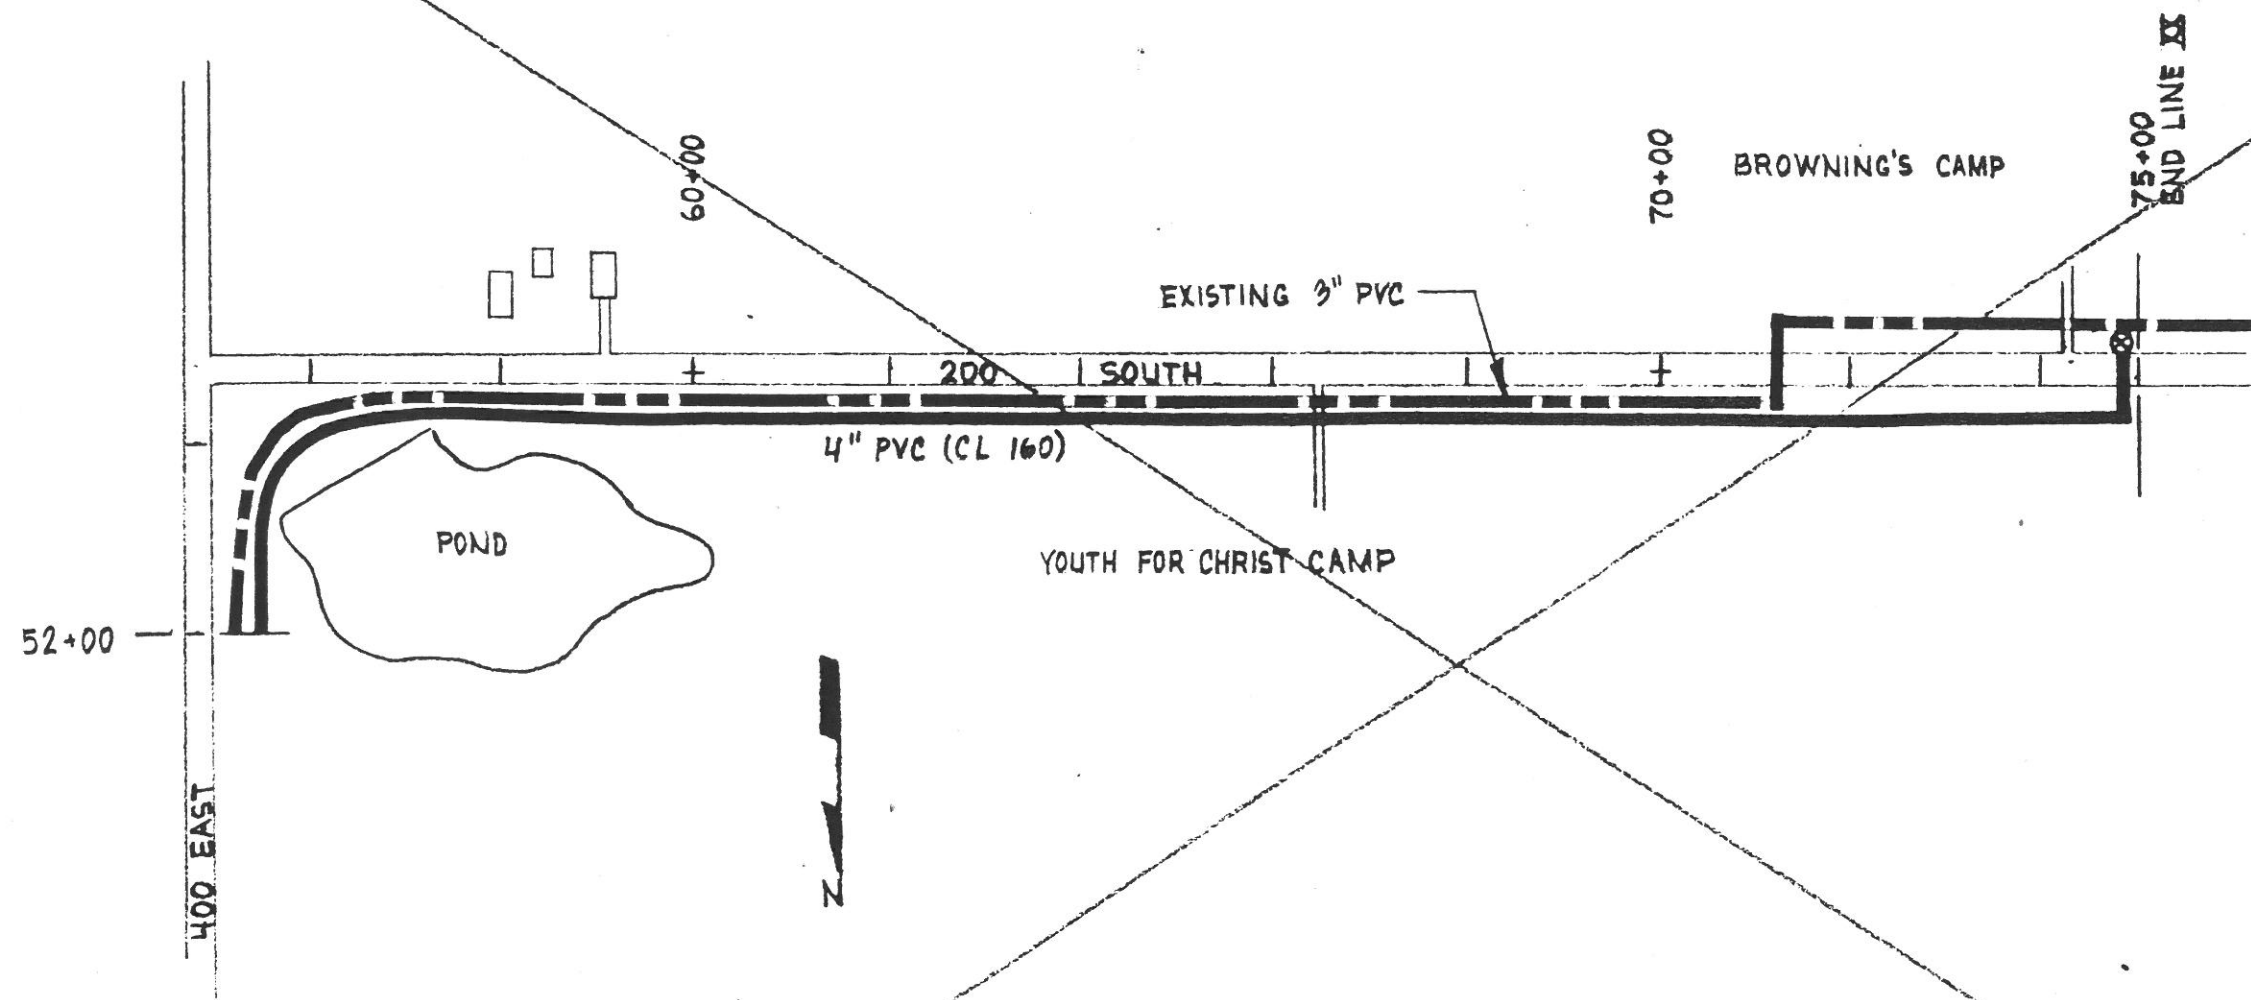

AS BUILT
 Date 1-16-84 By MAS

	JOB	61140
	SHEET NO.	19 OF 26
	SCALE	1" = 200'
	DATE	8-4-83
	DRAWN	M. SEEVERS
	CHECKED	
APPROVED		
CERTIFIED		

ELROD WATER CO., INC.
 RIPLEY CO., IND.
 LINE XX