
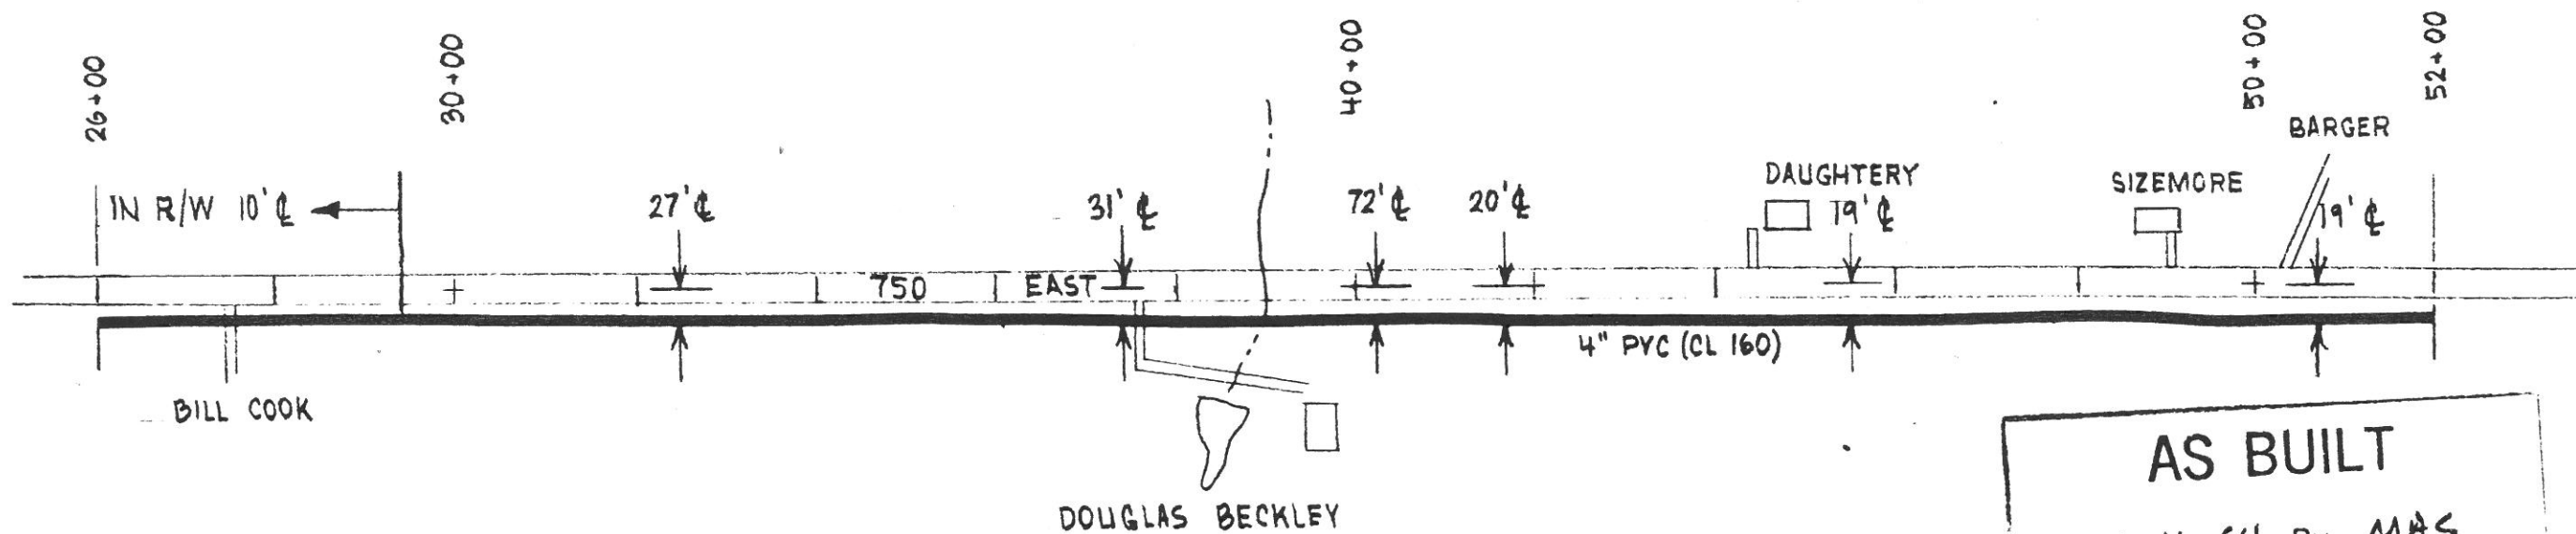


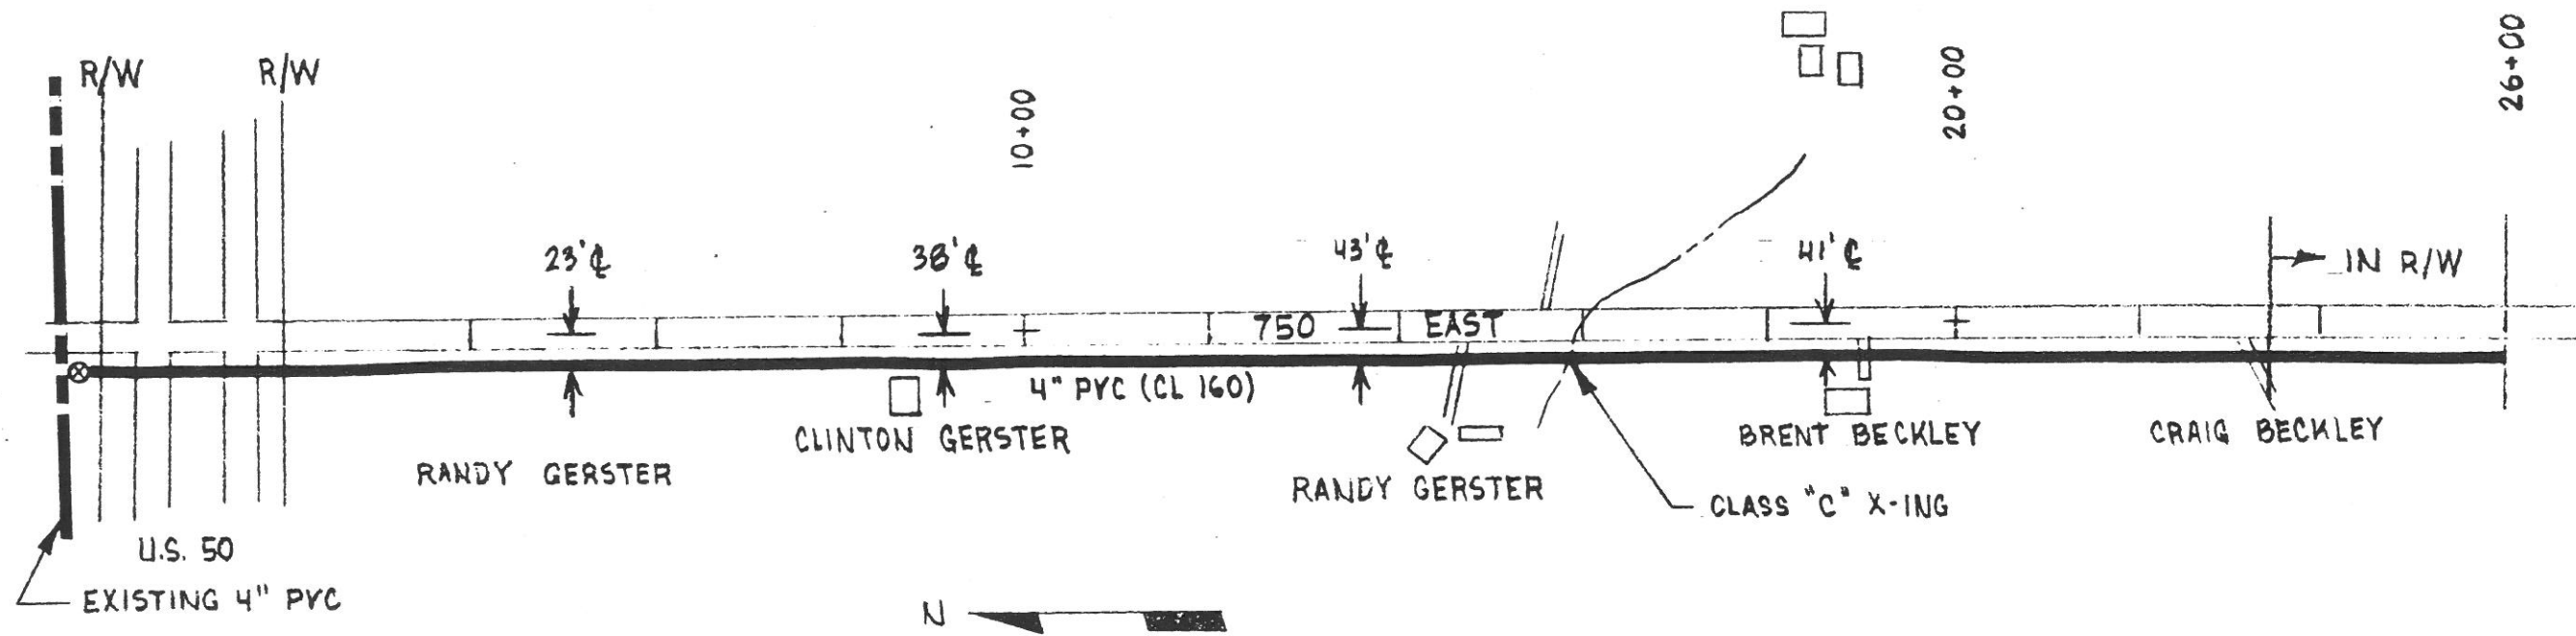

AS BUILT

Date 1-16-64 By MAS

	JOB	61140
	SHEET NO.	21 OF 26
	SCALE	1" = 200'
	DATE	8-4-63
	DRAWN	M. SEEYERS
	CHECKED	
CONSULTING ENGINEERS, ARCHITECTS, PLANNERS	APPROVED	
	CERTIFIED	
ELROD WATER CO., INC. RIPLEY CO., IND. LINE XXIV		