
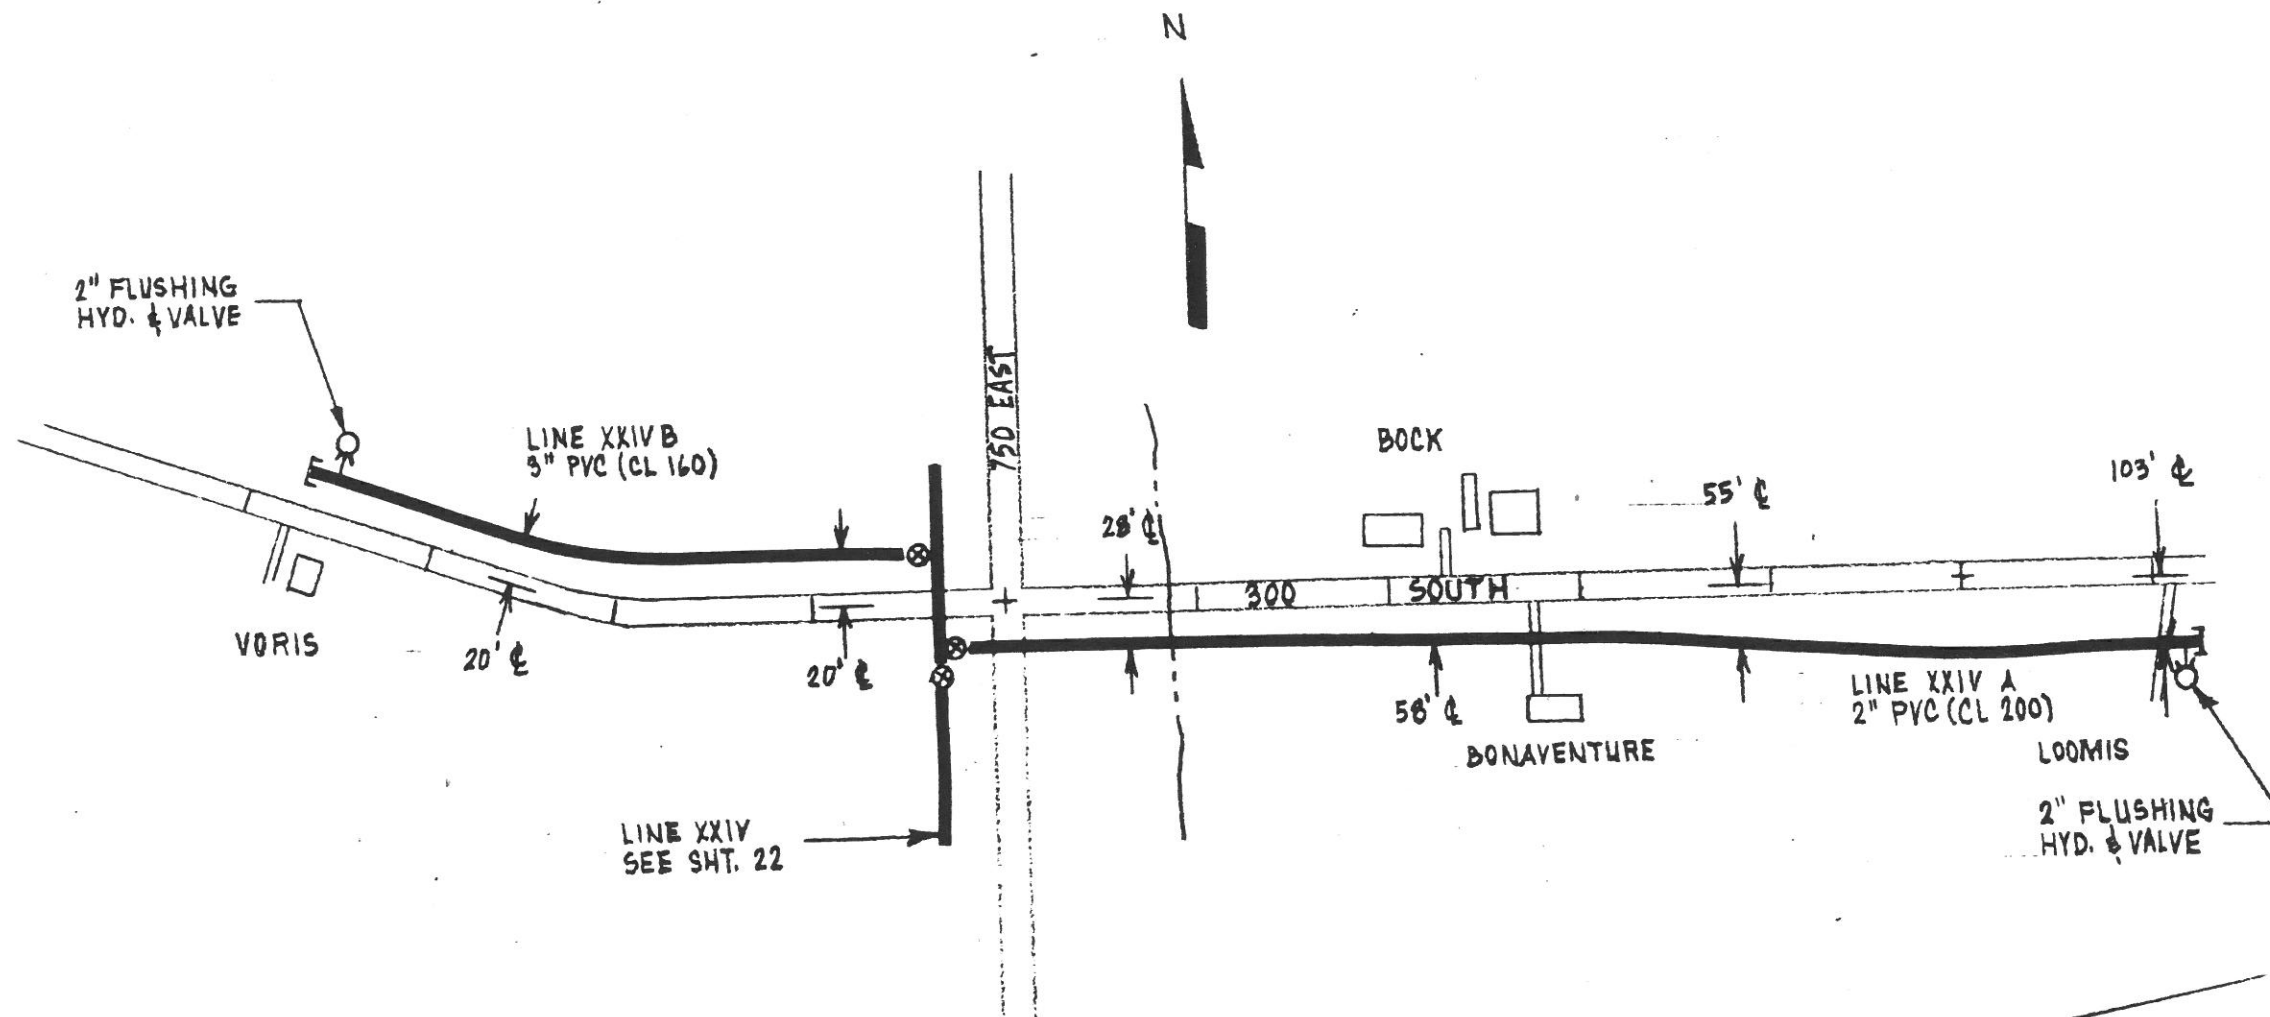


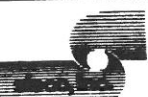

AS BUILT
 Date 1-16-84 By MAS

 CONSULTING ENGINEERS, ARCHITECTS, PLANNERS	JOB	61140
	SHEET NO.	25 OF 26
	SCALE	1" = 200'
	DATE	12-23-83
	DRAWN BY	M. SEYERS
	CHECKED	
	APPROVED	
	CERTIFIED	
ELROD WATER CO., INC. RIPLEY CO., IND. LINES XXIV A & XXIV B		