
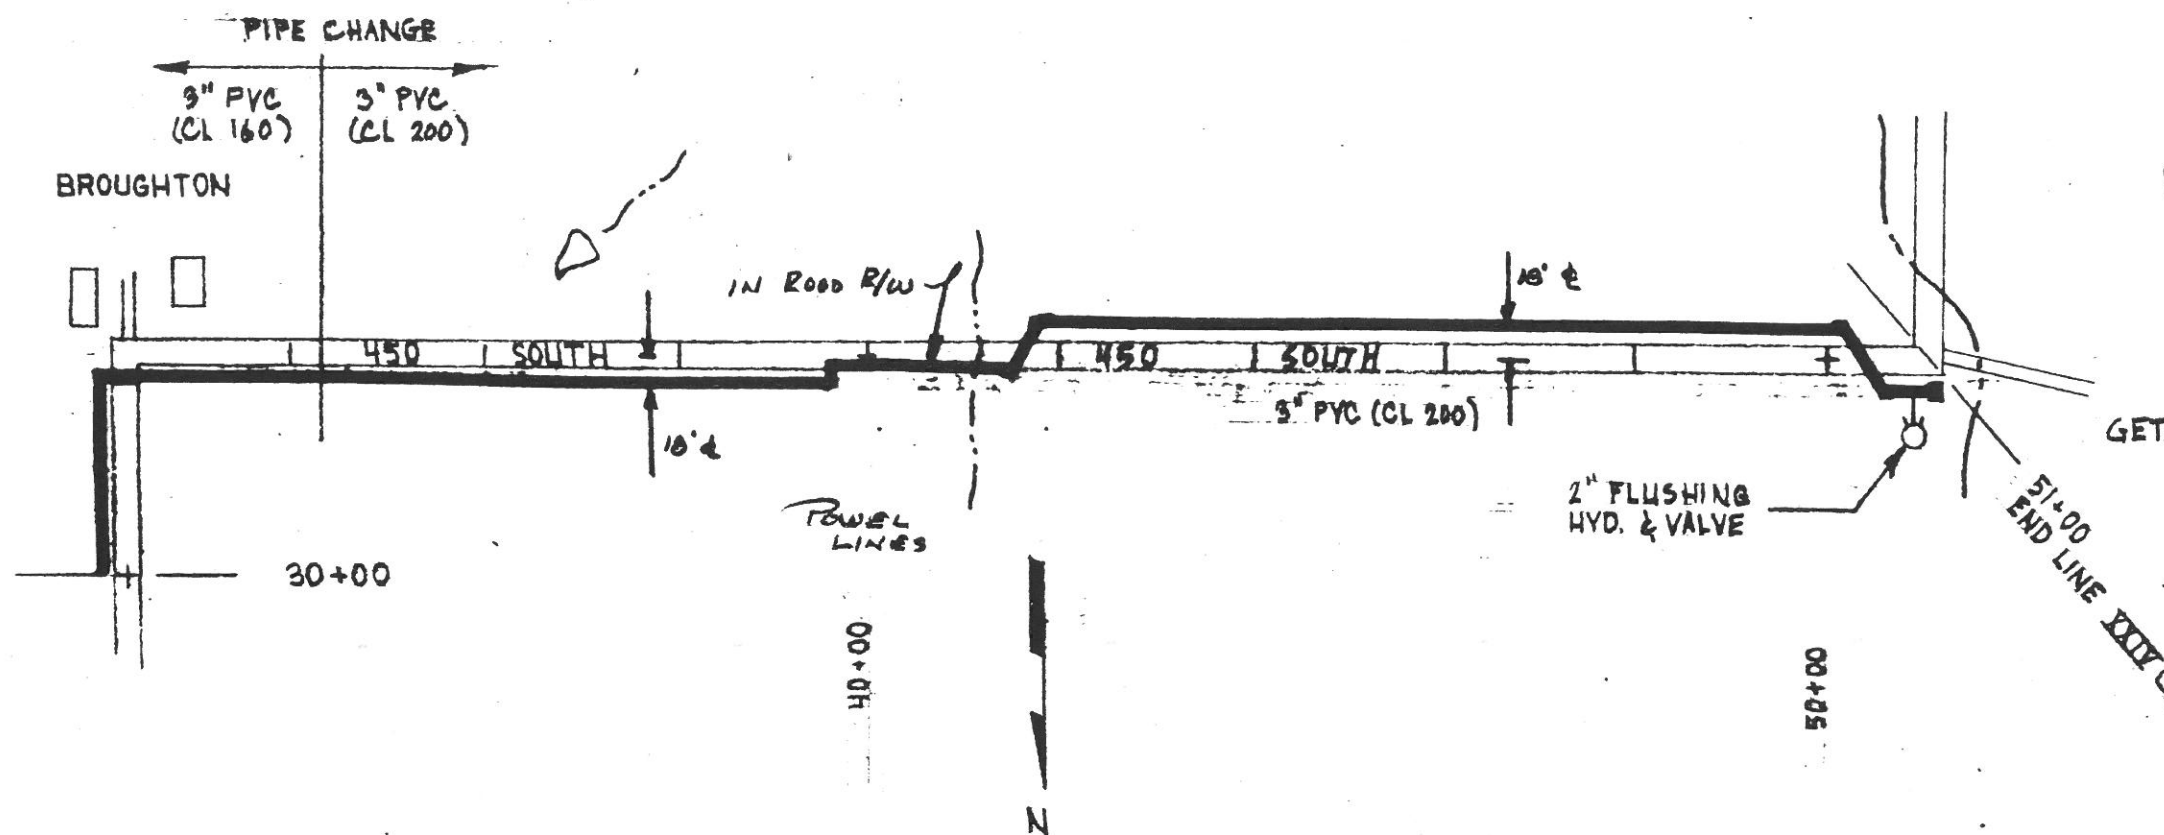


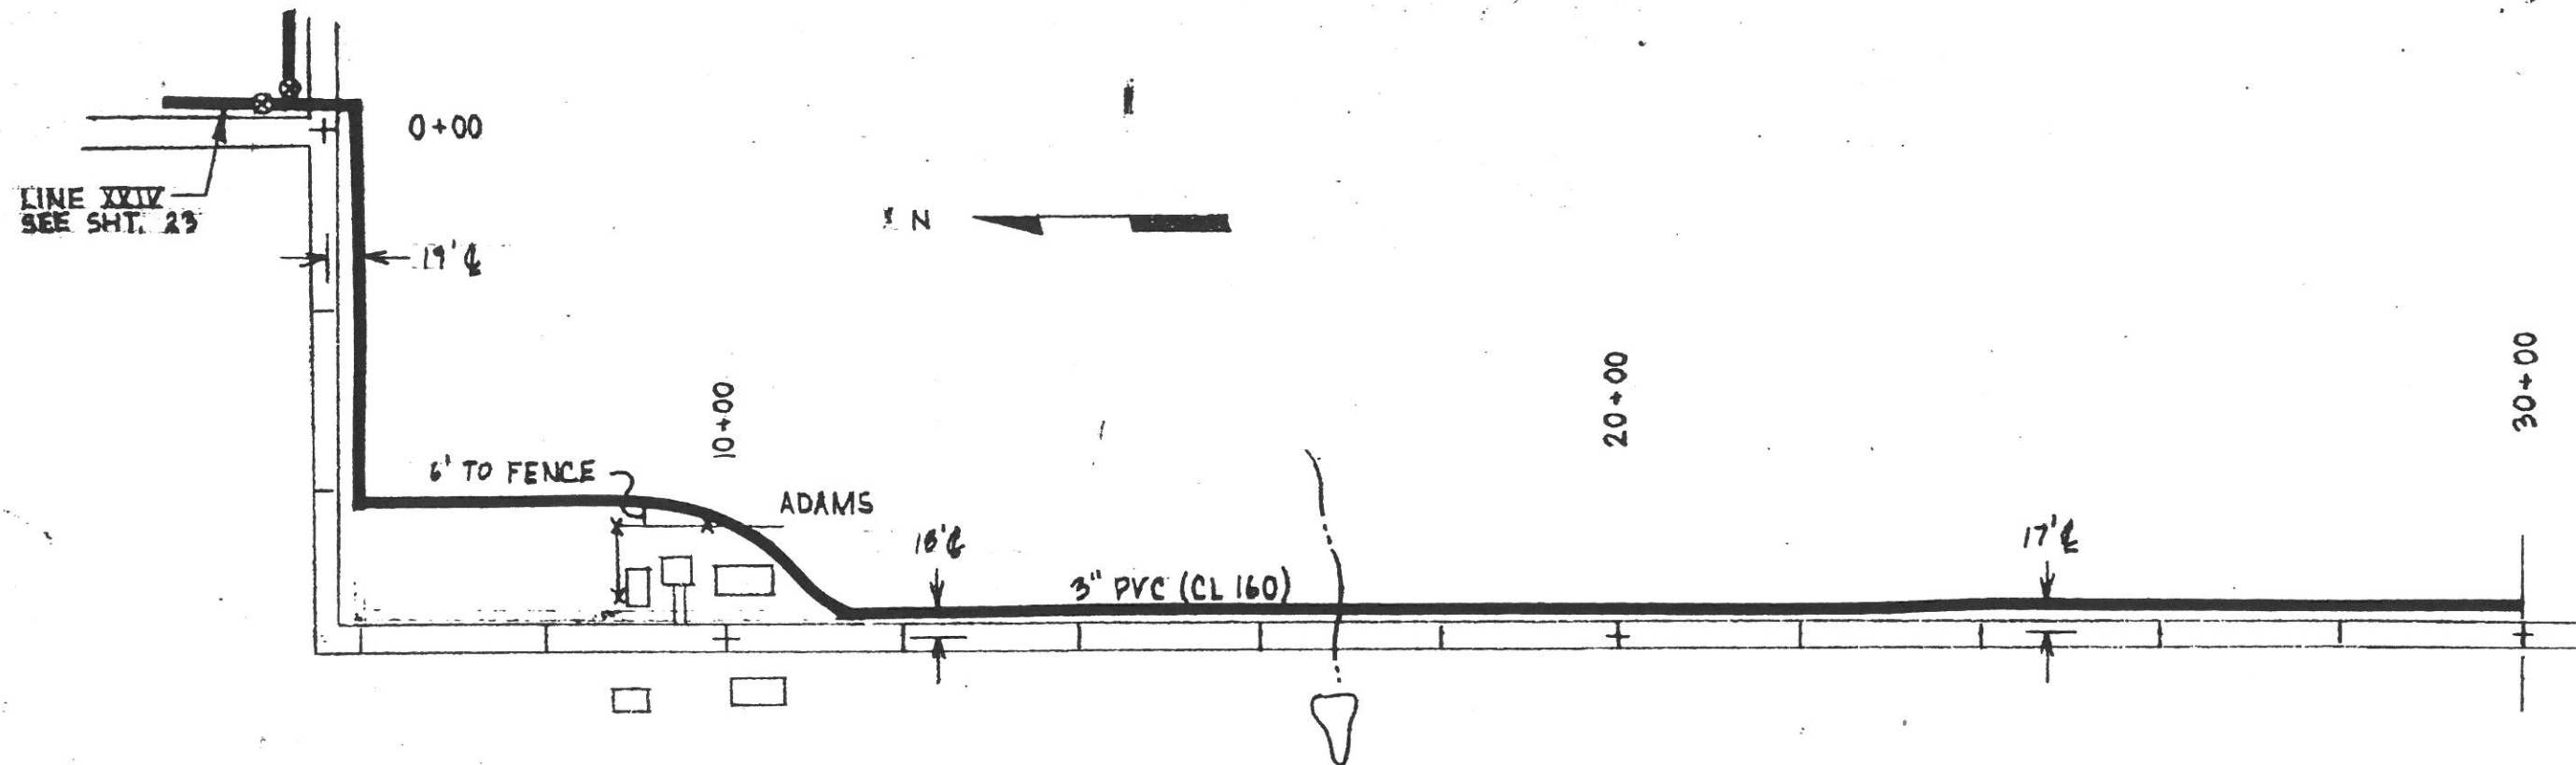

AS BUILT
Date 1-16-84 By MAS

	JOB	61140
	SHEET NO.	26 OF 26
	SCALE	1" = 200'
	DATE	2-4-83
	DRAWN	M. SEEYERS
	CHECKED	
	APPROVED	
	CERTIFIED	
ELROD WATER CO., INC. RIPLEY CO., IND. LINE XXIV C		