



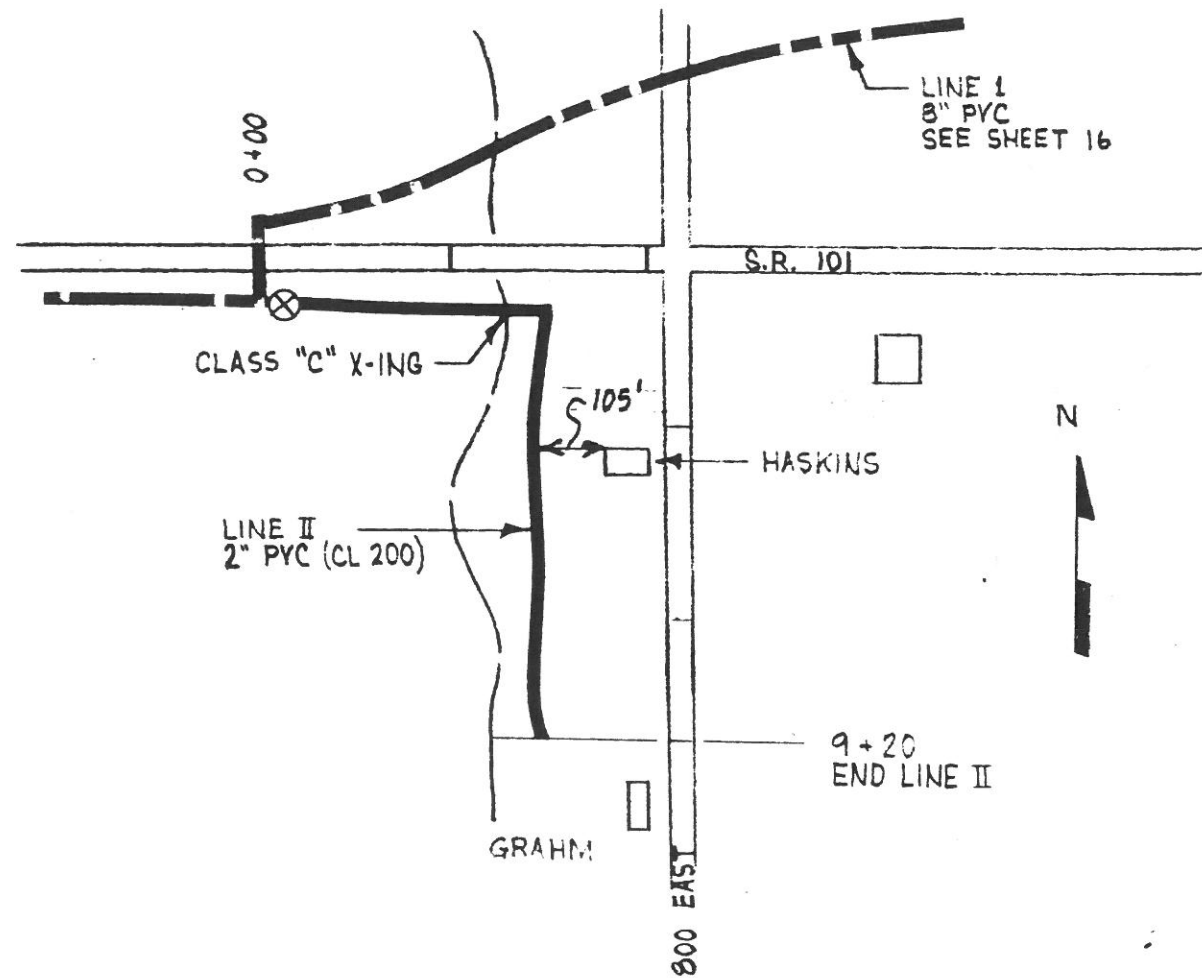

AS BUILT
Date 1-16-84 By MAS

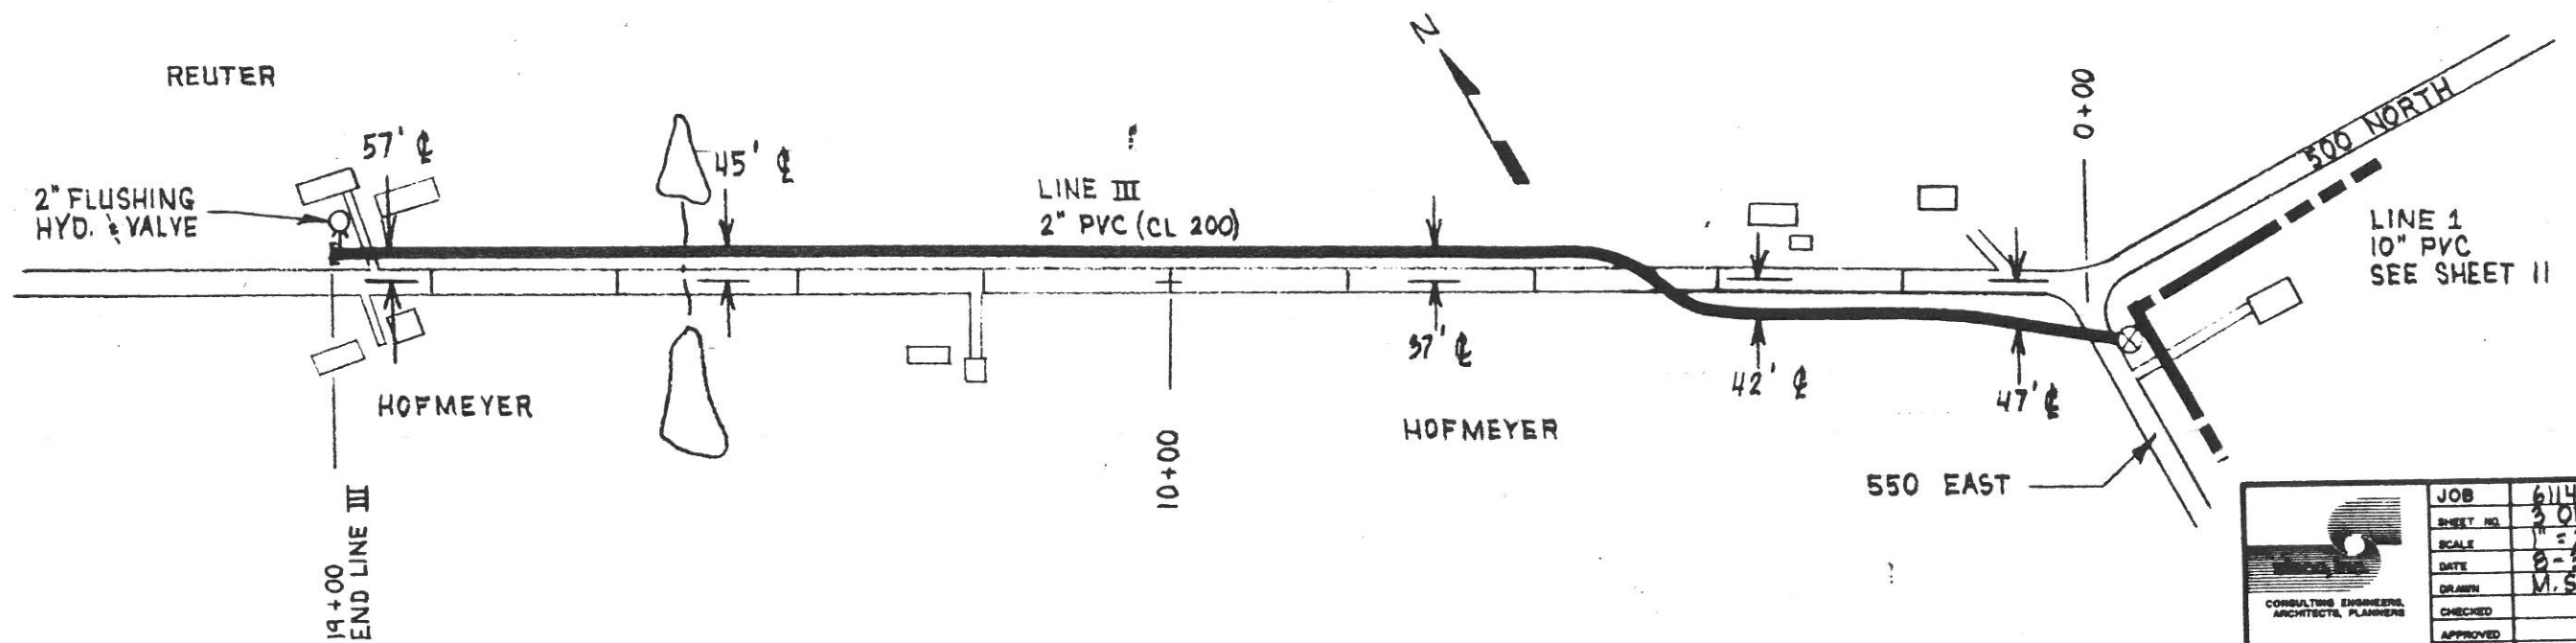

	JOB	61140
	SHEET NO.	3 OF 26
	SCALE	1" = 200'
	DATE	8-3-83
	DRAWN	M. SEEVERS
	CHECKED	
CONSULTING ENGINEERS, ARCHITECTS, PLANNERS	APPROVED	
	CERTIFIED	
ELROD WATER CO., INC. RIPLEY CO., IND. LINES II & III		