
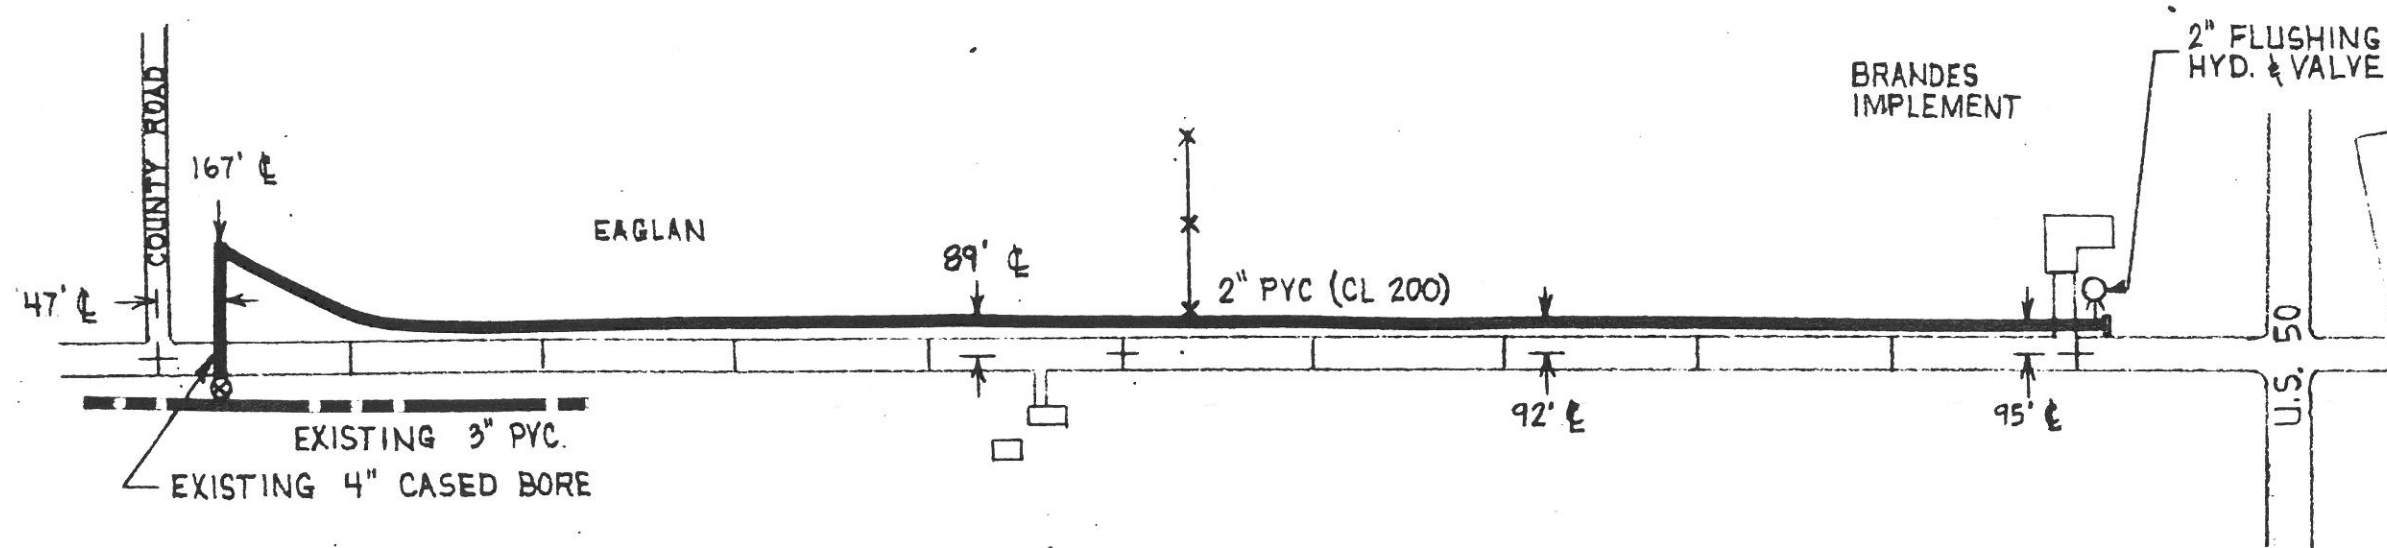
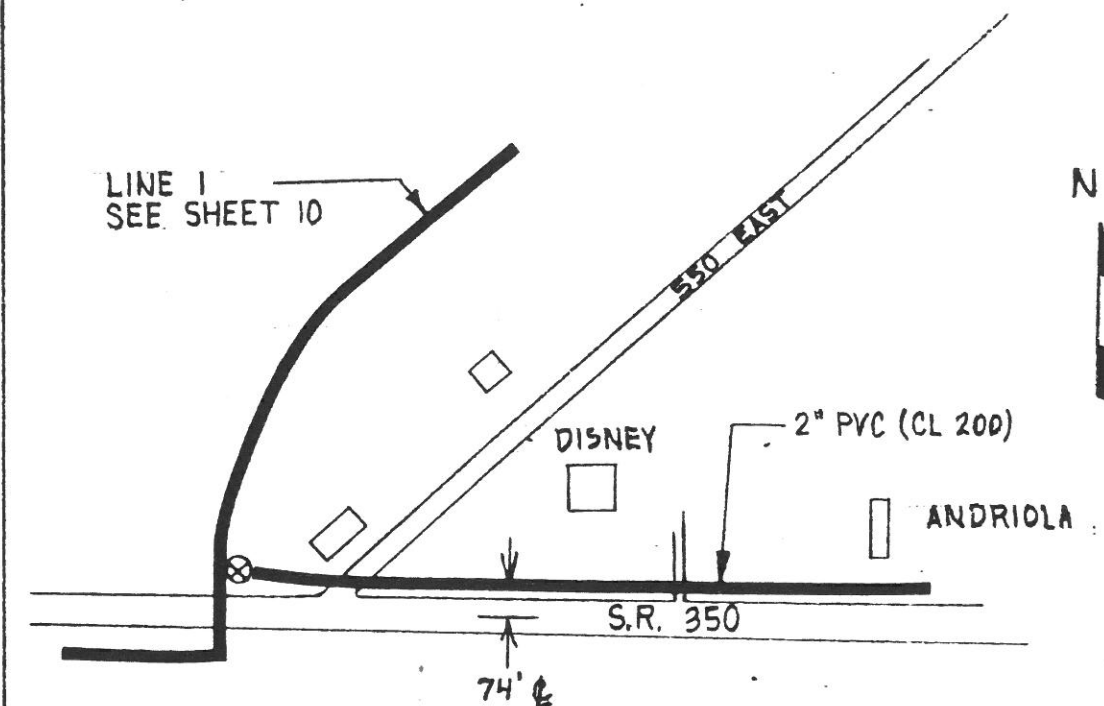


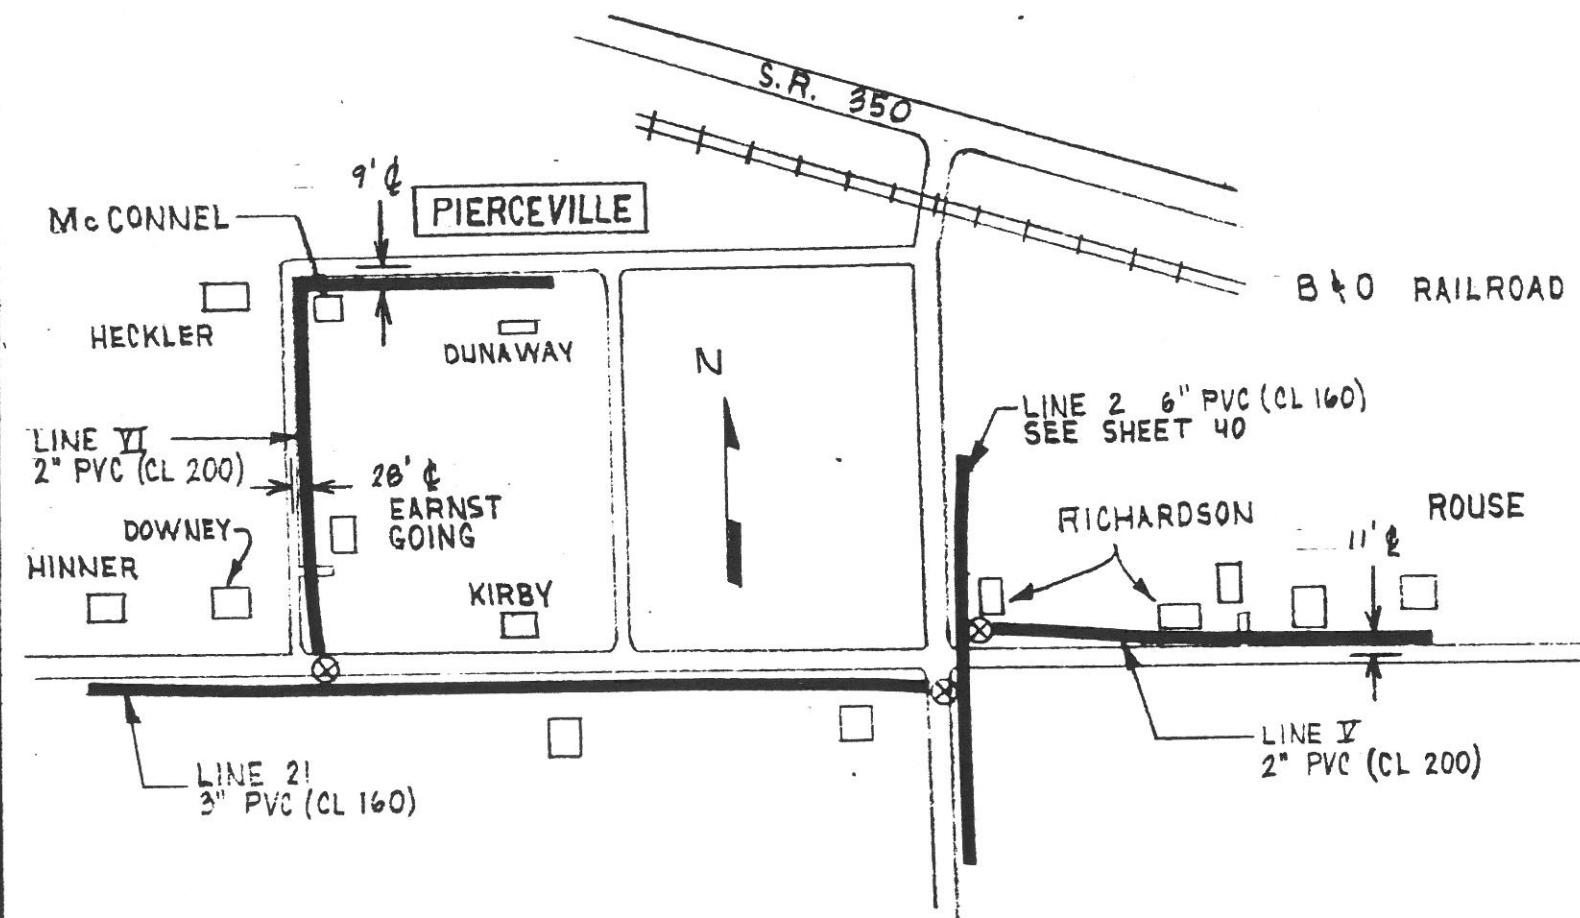

AS BUILT
Date 1-16-84 By MAS

JOB	61140
SHEET NO.	5 OF 26
SCALE	1" = 200'
DATE	7-25-83
DRAWN	M. SEEVERS
CHECKED	
APPROVED	
CERTIFIED	

ELROD WATER CO., INC.
RIPLEY CO., IND.
LINES V & VI