


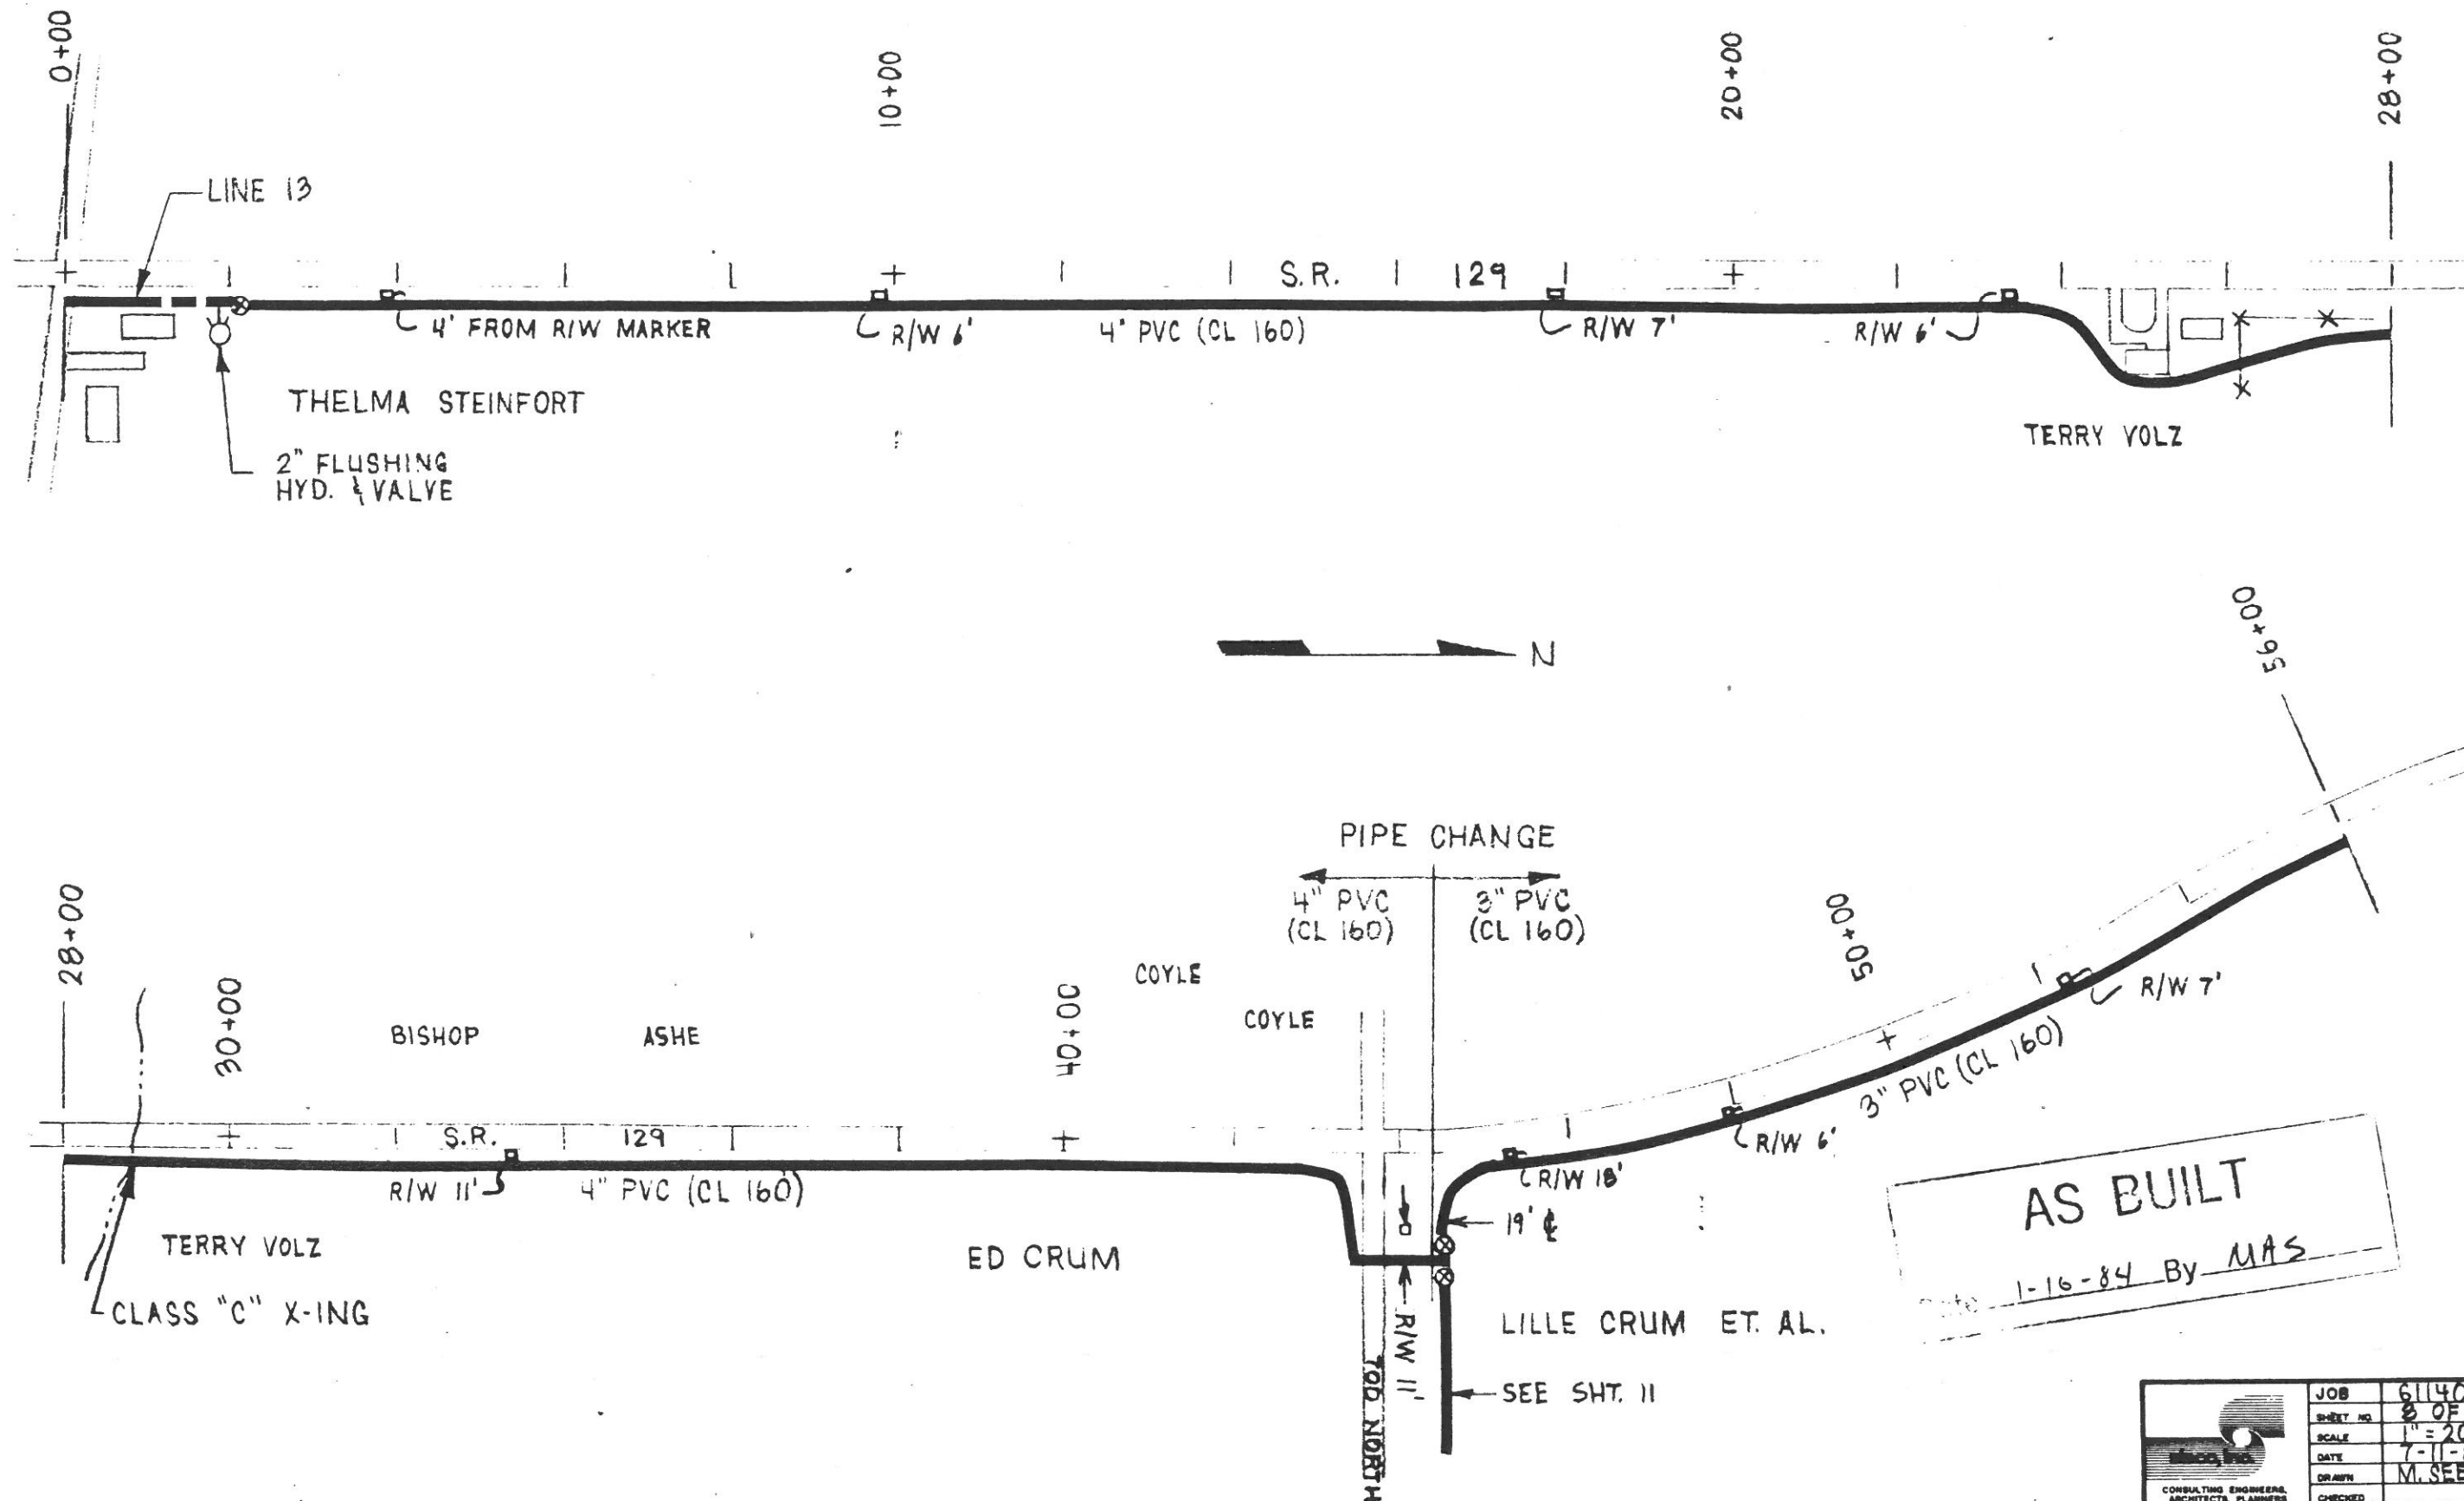

AS BUILT
 Date 1-16-84 By MAS

 CONSULTING ENGINEERS ARCHITECTS PLANNERS	JOB	61140
	SHEET NO.	8 OF 26
	SCALE	1" = 200'
	DATE	7-11-83
	DRAWN	M. SEEVERS
	CHECKED	
	APPROVED	
	CERTIFIED	
ELROD WATER CO., INC. RIPLEY CO., IND. LINE VIII		