
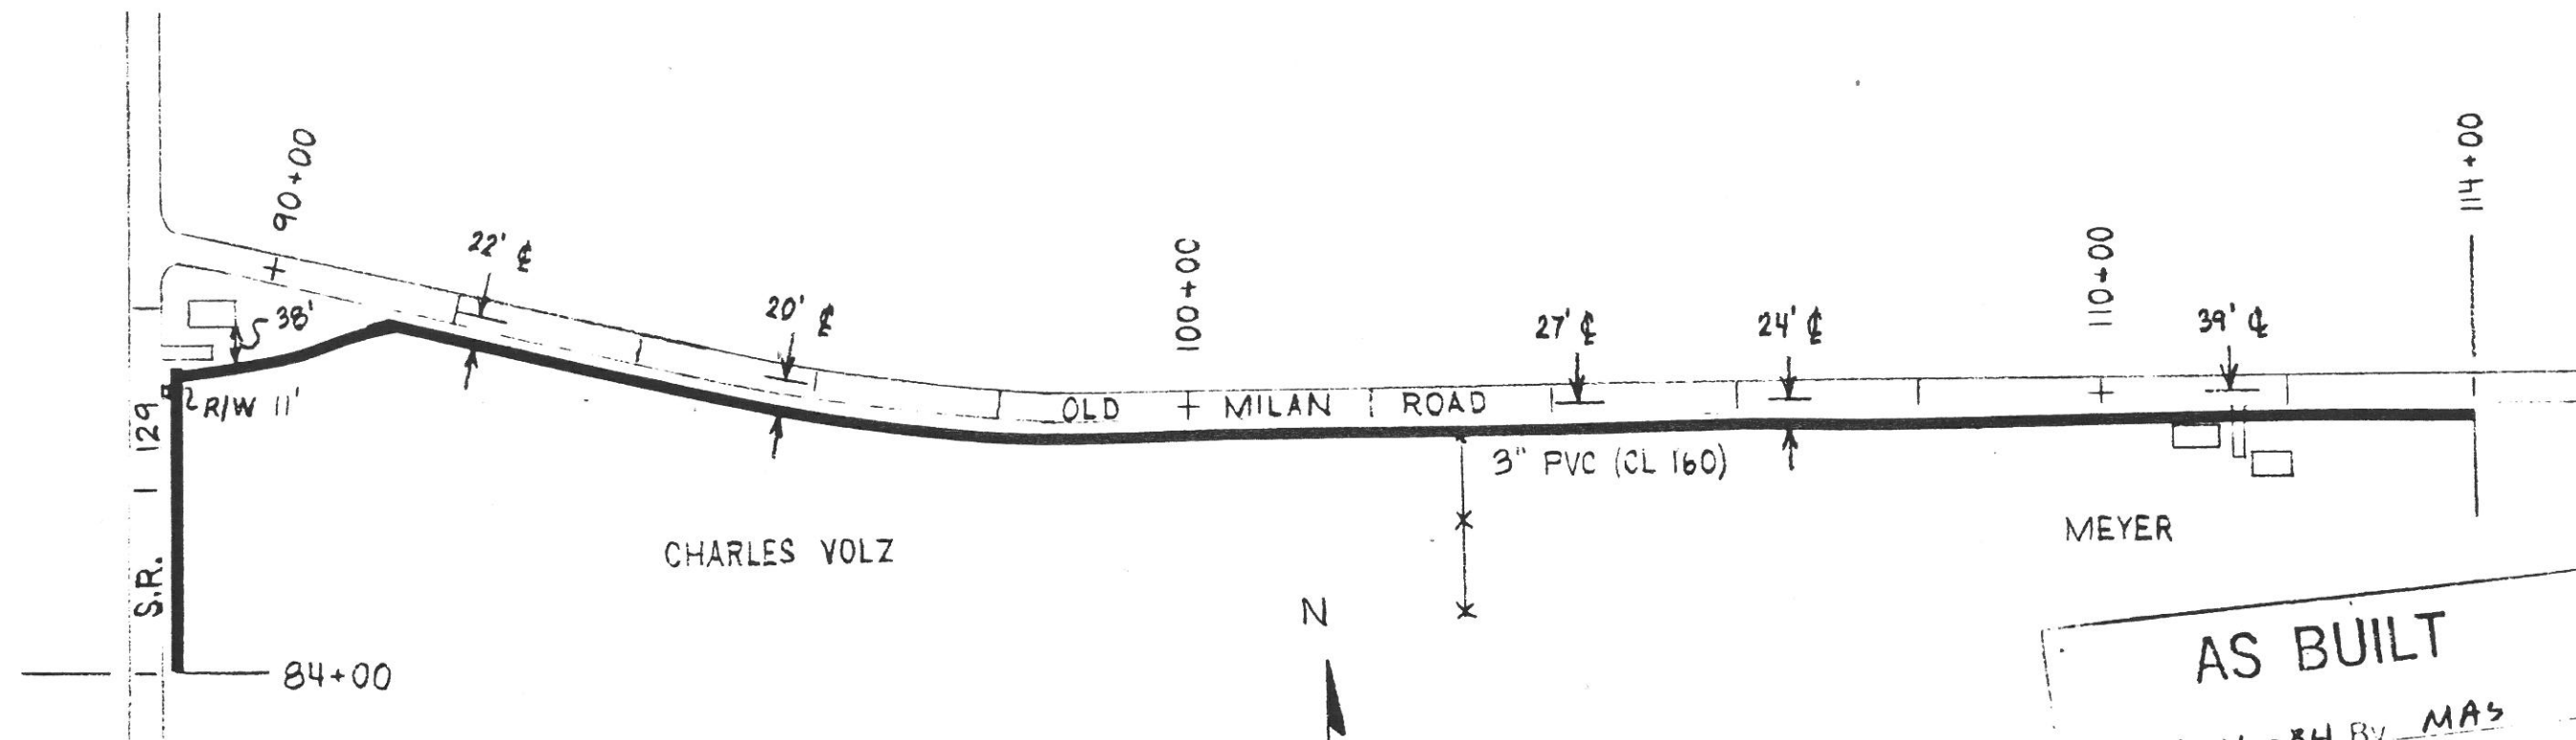
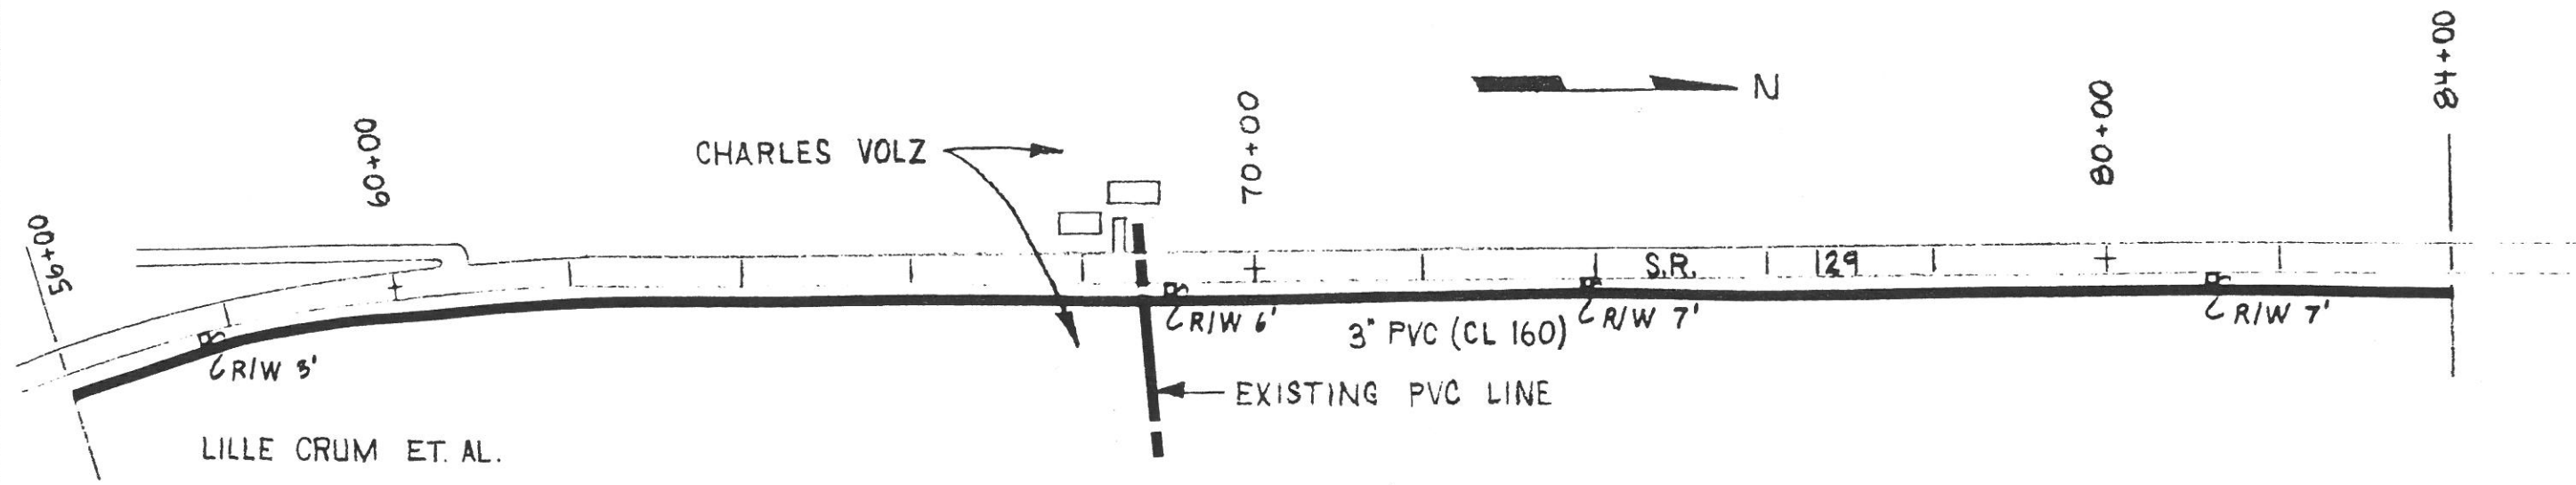


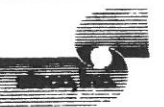

AS BUILT
 1-16-84 By **MAS**

 CONSULTING ENGINEERS, ARCHITECTS, PLANNERS	JOB	61140
	SHEET NO.	9 OF 26
	SCALE	1" = 200'
	DATE	7-12-83
	DRAWN	M. SEEVERS
	CHECKED	
	APPROVED	
	CERTIFIED	
ELROD WATER CO., INC. RIPLEY CO., IND. LINE VIII		