



NOTES: Notes

RECORD DRAWING

This drawing has been revised from the original contract drawings to show minor / major changes made during construction. This drawing is not warranted to be complete and accurate in all respects.

GRW Engineers, Inc.


Date: 2-8-2000 By: S. Sheehan

REVISIONS				
NO.	DESCRIPTION	DATE	BY	
2	RENUMBERED	6-03	GCR	
1	AS-BUILT	2-00	SS	

HOOSIER HILLS REGIONAL
WATER DISTRICT

WERNER WATER MAIN EXTENSION

GRW PROJECT NO. 2543-16

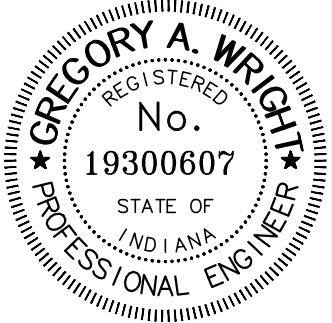

GRW Engineers, Inc.

Engineers, Architects, Planners

INDIANAPOLIS, INDIANA
LOUISVILLE & LEXINGTON, KENTUCKY
CINCINNATI, OHIO
NASHVILLE, TENNESSEE
ARLINGTON, TEXAS

DRAWN: BJD	DATE: APRIL 1999
FILE NAME: SHT632.dwg	SCALE: 1" = 100'
CHECKED:	SHEET NO.
APPROVED:	632