


HOOSIER HILLS REGIONAL WATER DISTRICT WEST COUNTY LINE ROAD WATER MAIN EXTENSION

HOOSIER HILLS REGIONAL WATER DISTRICT BOARD OF DIRECTORS

GREGORY DOLE – PRESIDENT
RANDY SCUDDER – VICE PRESIDENT
CHARLES HYNES – SECRETARY
HELEN GRIGSBY – TREASURER
ANDREW WEISENBACH – ASST. TREASURER
TED MEER – BOARD MEMBER
ROY B. MEYER – BOARD MEMBER
RUSSELL MORTARA – BOARD MEMBER
ANTHONY CLARK – BOARD MEMBER
SCOTT STIRN – GENERAL MANAGER

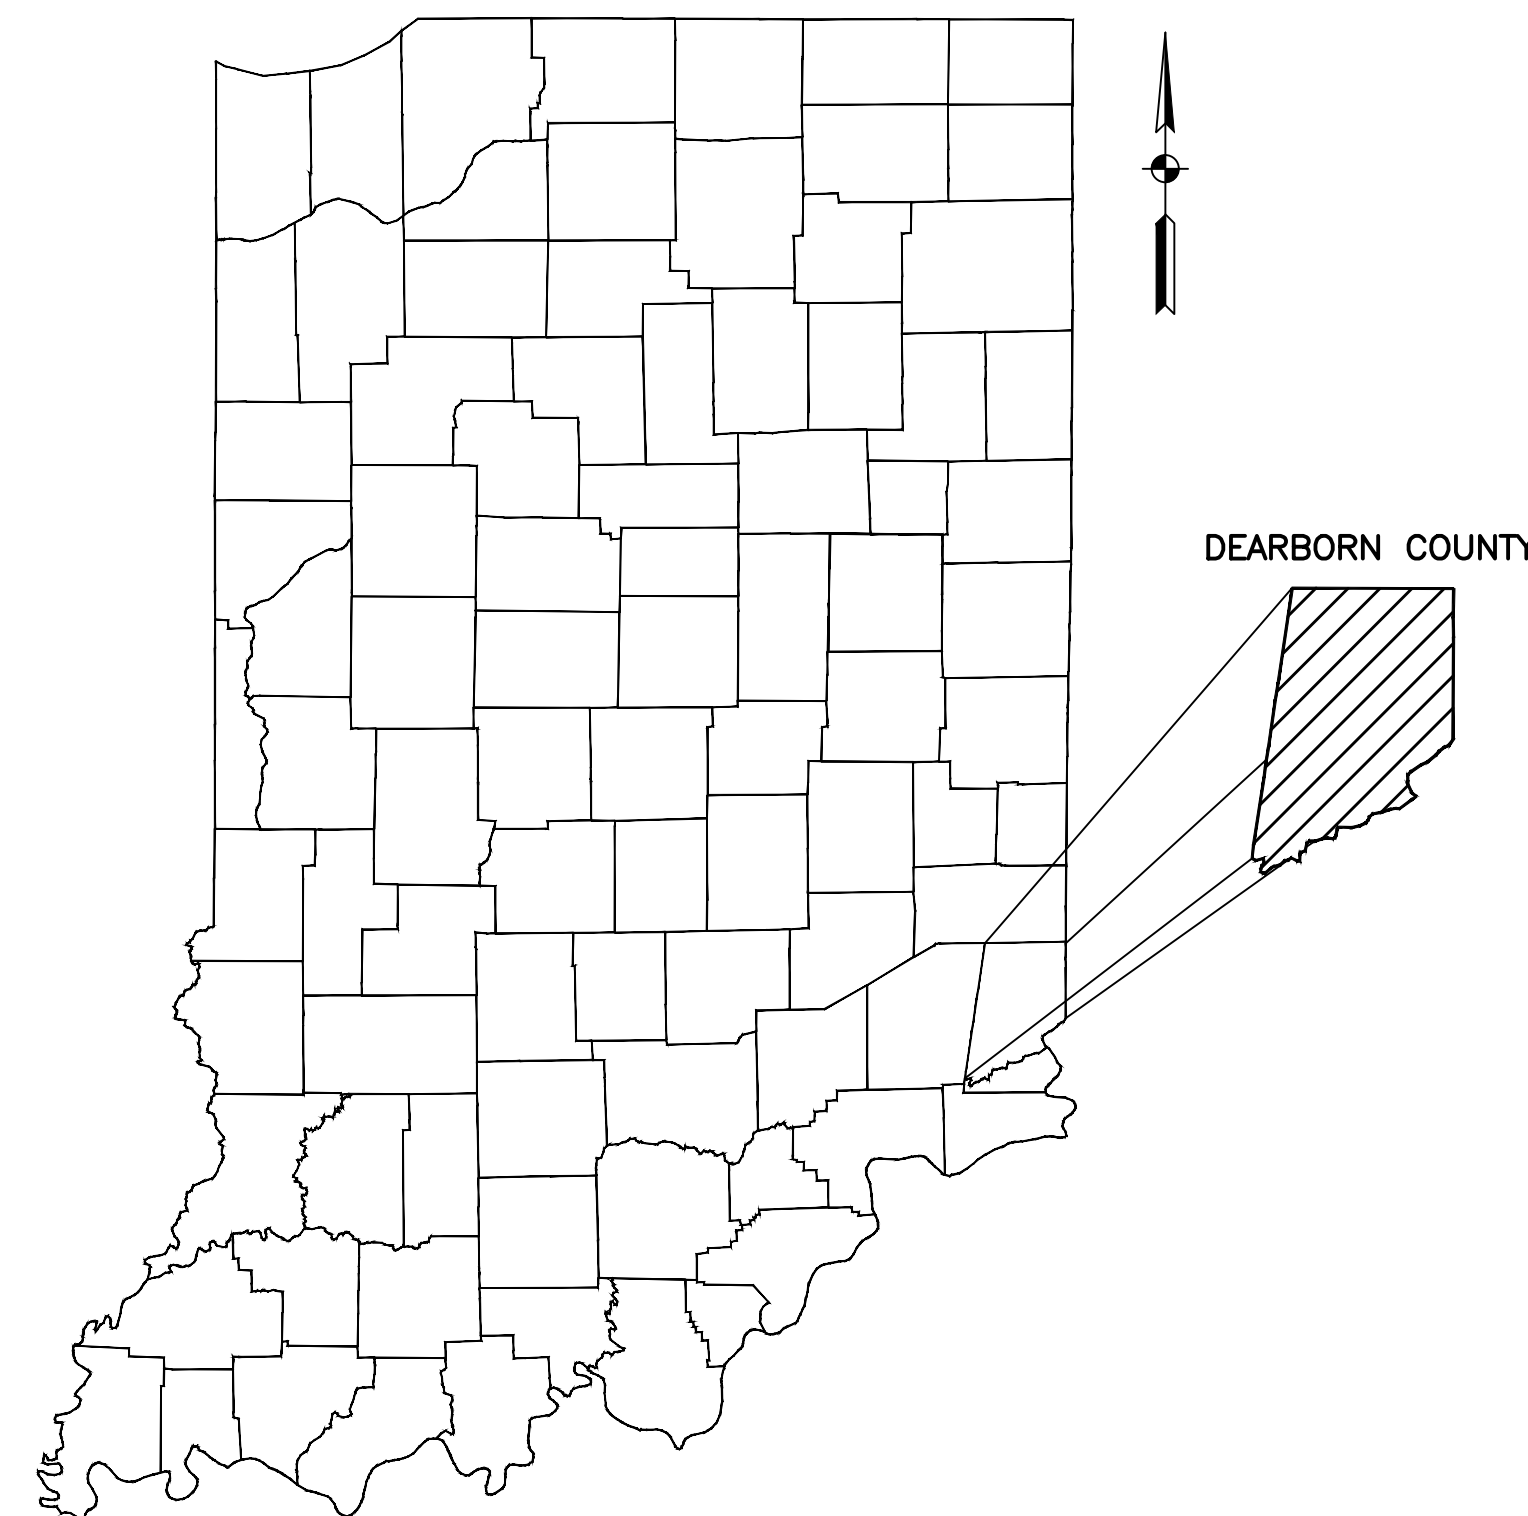


RECORD DRAWING

This drawing has been revised from the original contract drawings to show minor/ major changes made during construction. This drawing is not warranted to be complete and accurate in all respects.


GRW Engineers, Inc.

Date: 04-05-10 By: NRE

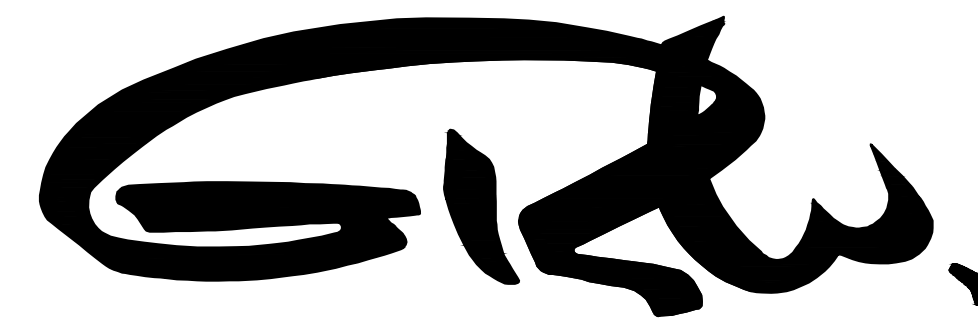


GRW Engineers, Inc.
Engineers, Architects, Planners

7112 WALDEMAR DRIVE – INDIANAPOLIS, IN. 46268
PH. (317)347-3850 FAX (317)347-3856
LEXINGTON LOUISVILLE NASHVILLE INDIANAPOLIS
FORT MITCHELL KNOXVILLE ARLINGTON COLUMBUS

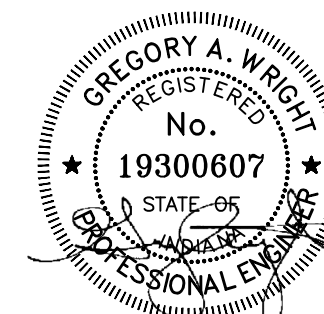

JULY 2008

SITE LOCATION MAP

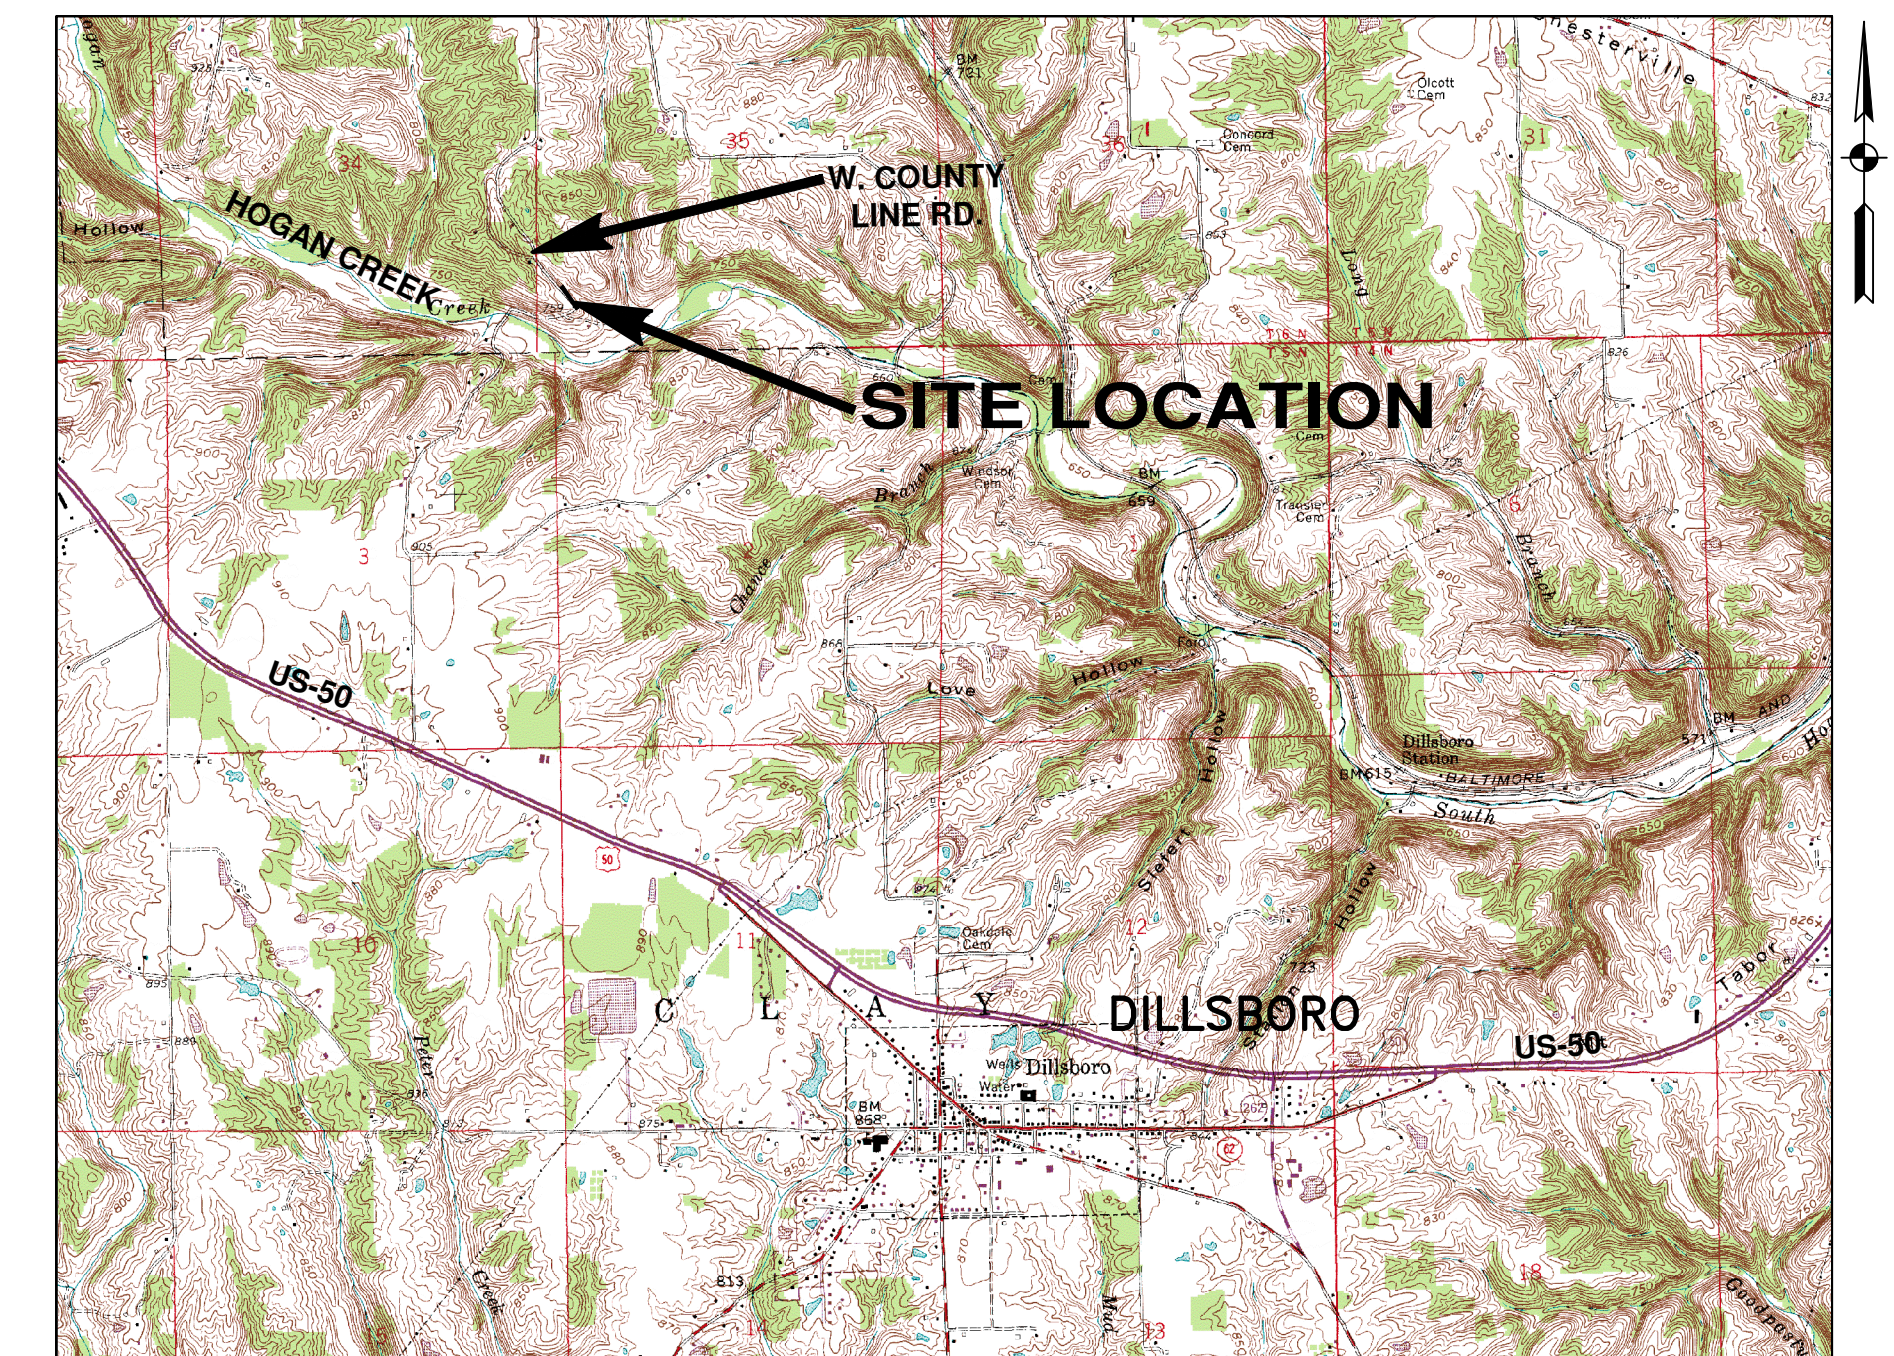

INDEX OF DRAWINGS	
NO.	DRAWING TITLE
	GENERAL
G-00	COVER SHEET
	CIVIL
725	WEST COUNTY LINE ROAD

GRW PROJECT NO. 3421-20