


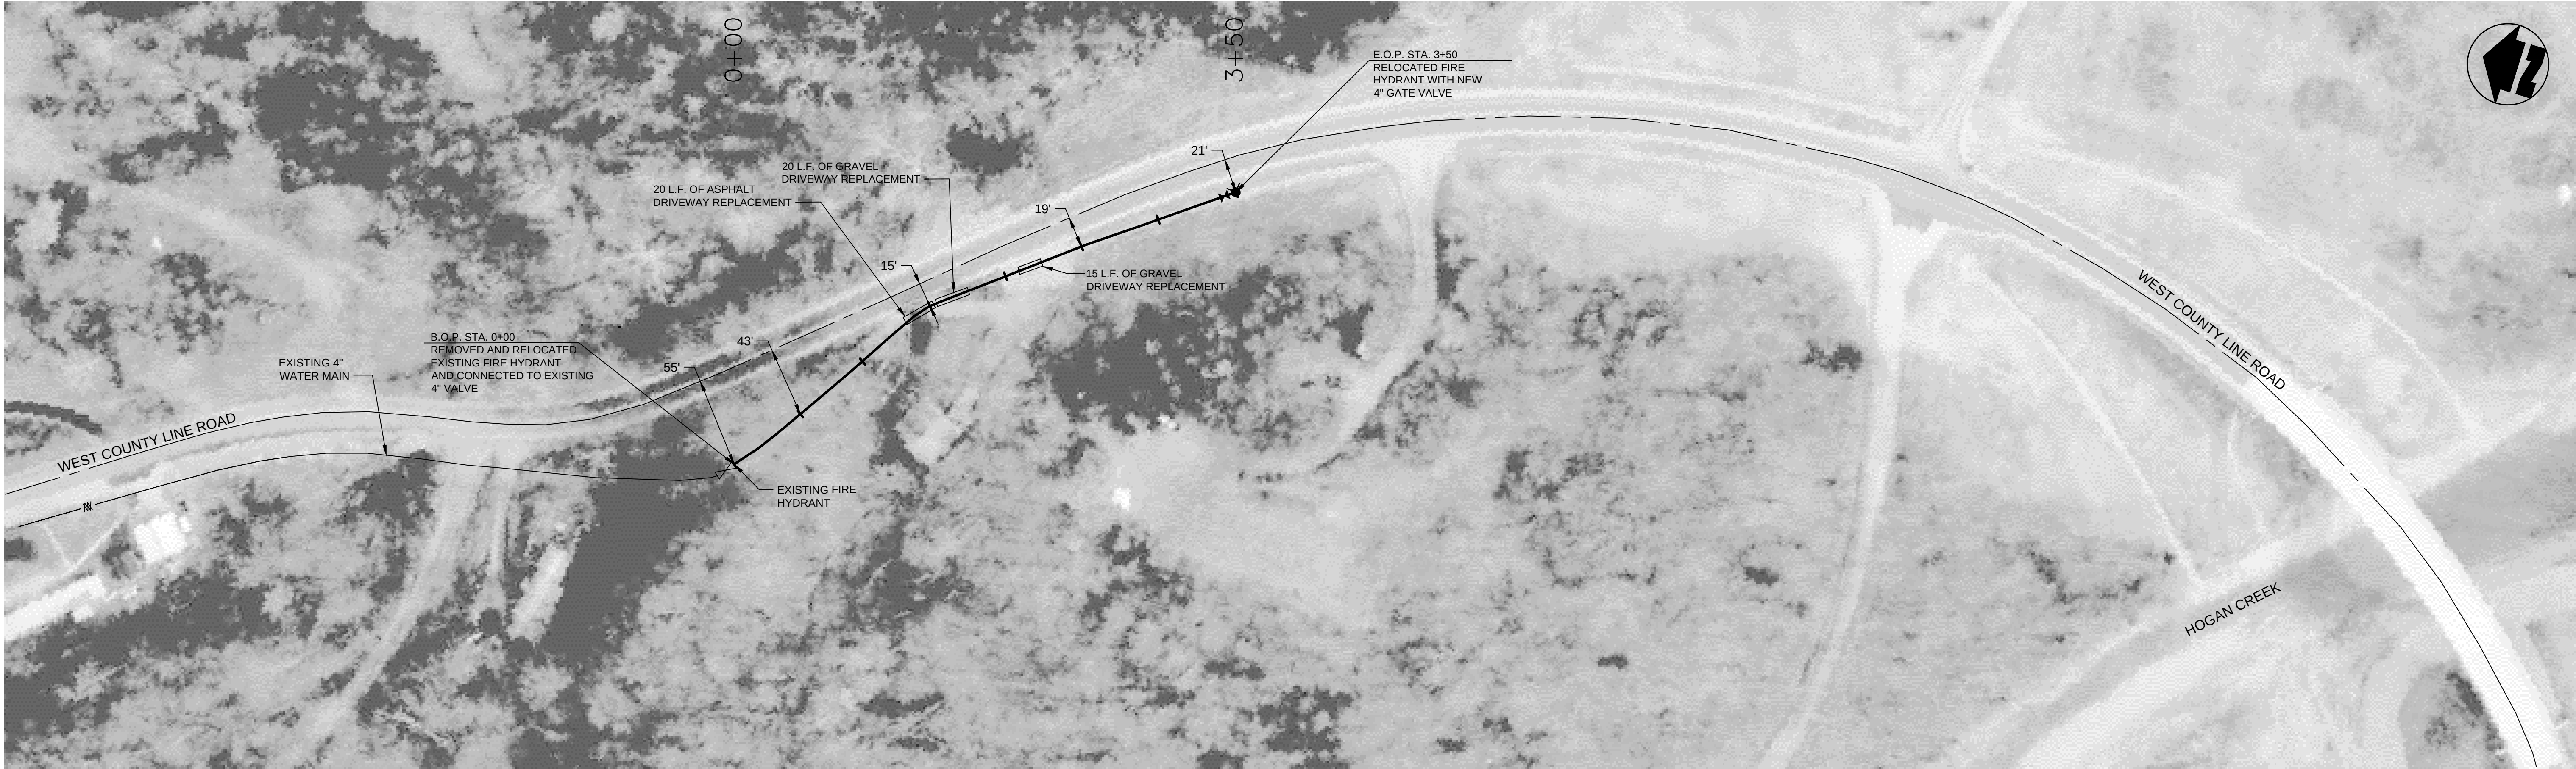

RECORD DRAWING

This drawing has been revised from the original contract drawing to show minor / major changes made during construction. This drawing is not warranted to be complete and accurate in all respects.

GRW Engineers, Inc.

Date: 04-05-10 By: NRE

	
GRW/PROJECT NO. 3421-20	
CLIENT PROJECT NO. N/A	
ALL RIGHTS RESERVED. THIS DOCUMENT IS THE PROPERTY OF GRW ENGINEERS, INC. AND IS NOT TO BE REPRODUCED IN WHOLE OR IN PART FOR ANY OTHER PROJECT WITHOUT WRITTEN PERMISSION.	
 ENGINEERS - ARCHITECTS - PLANNERS www.grwinc.com	
HOOSIER HILLS REGIONAL WATER DISTRICT	
WEST COUNTY LINE ROAD WATER MAIN EXTENSION	
DESIGNED:	DRC
BY:	DRAWN:
DATE:	GCR
4/05/10	NRE
REVISIONS	REVIEWED:
NO.	APPROVED:
1	GAW
AS-BUILT REVISIONS	
SCALE CHECK: THIS MARK SHOULD MEASURE EXACTLY 1" WHEN PLOTTED	
DATE: JULY, 2008	
SCALE: 1" = 50'	
SHEET NO. 725	