



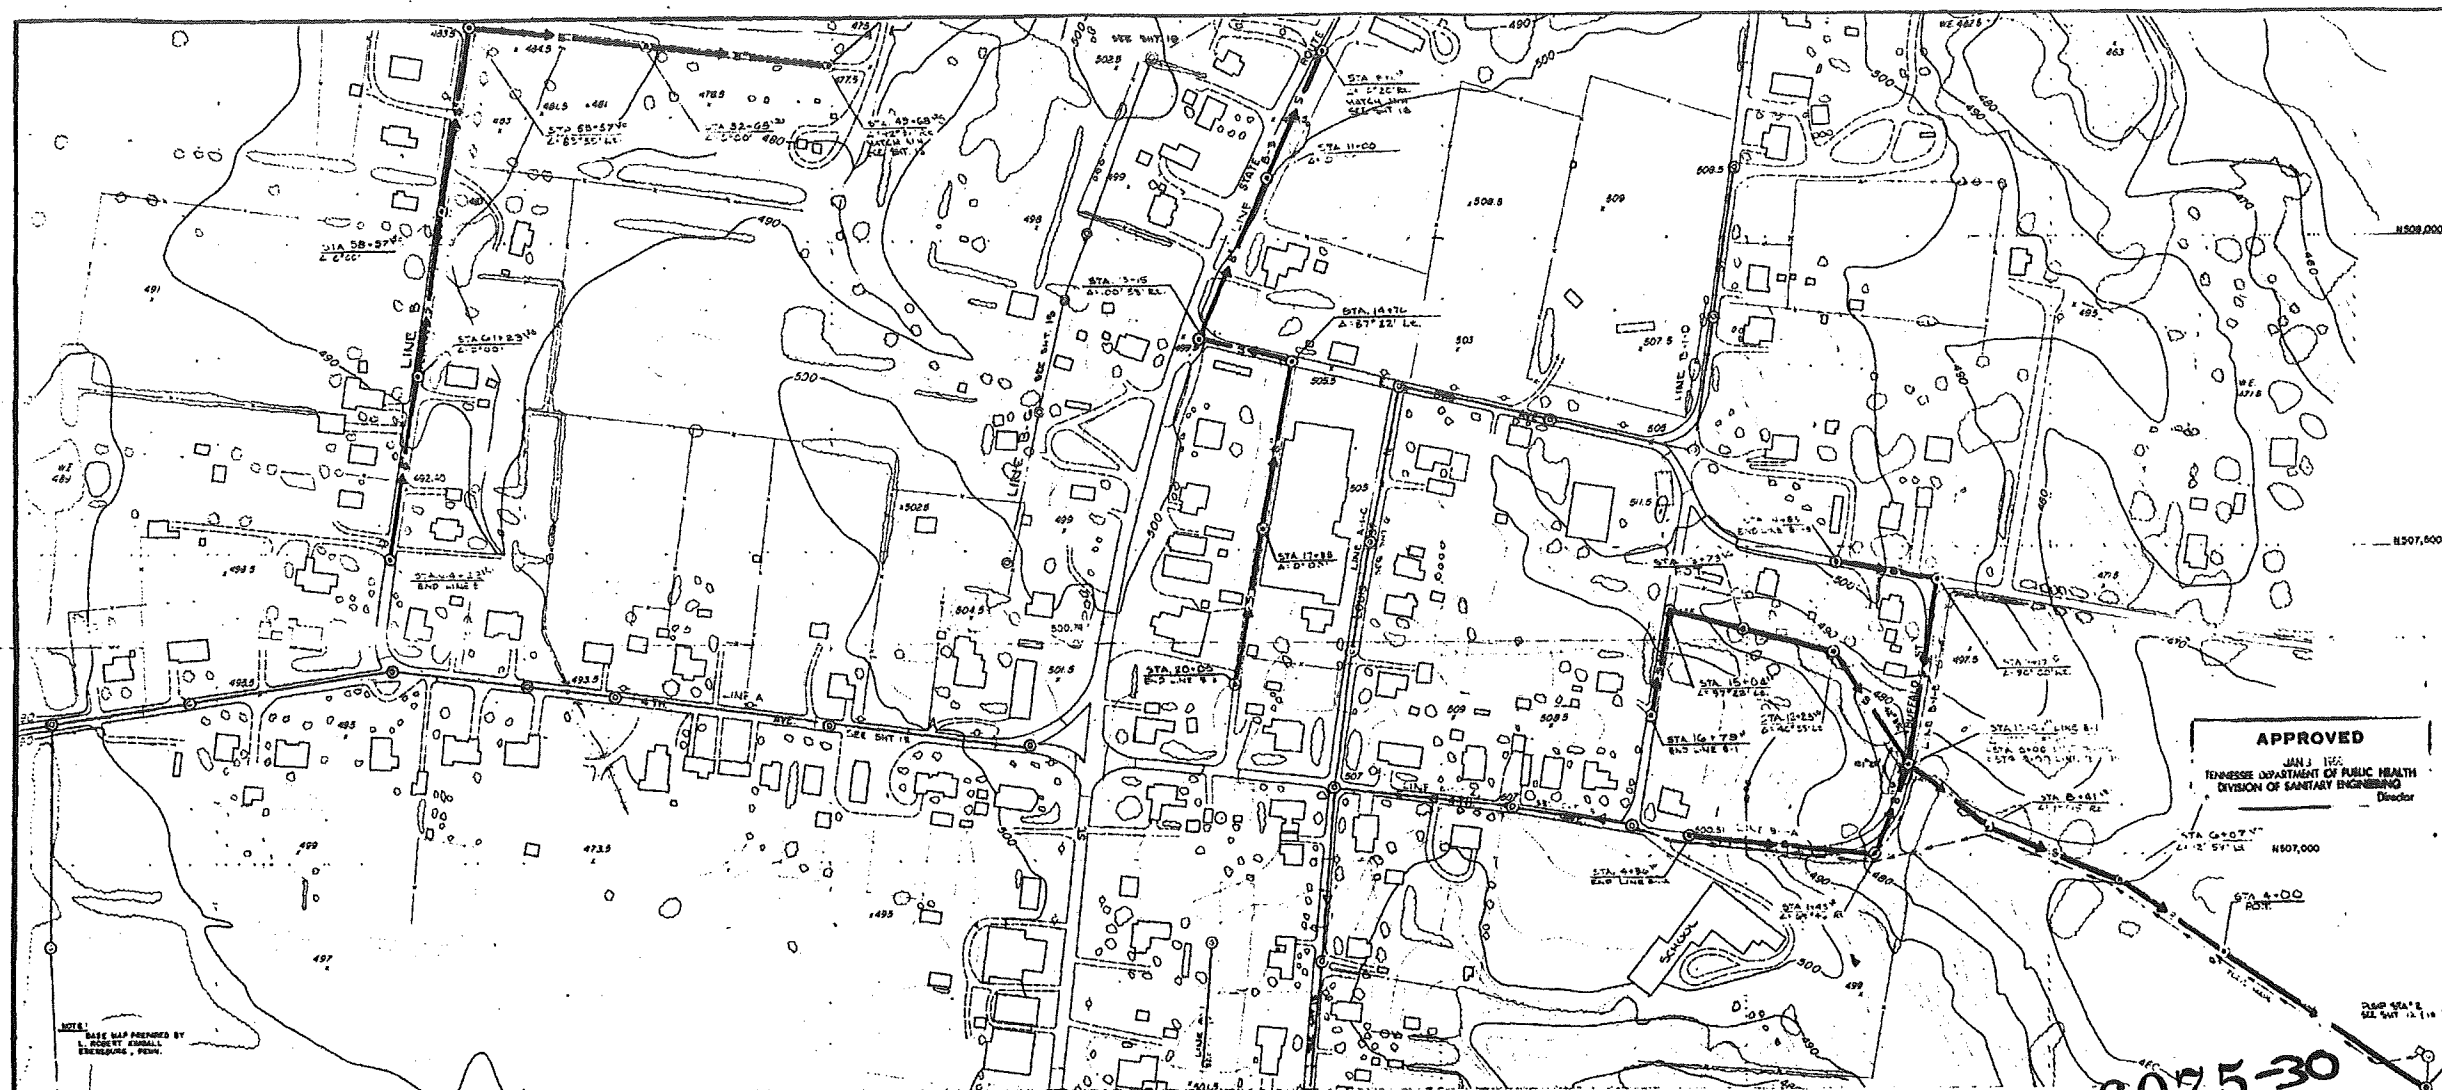

APPROVED
JAN 1 1955
TENNESSEE DEPARTMENT OF PUBLIC HEALTH
DIVISION OF SANITARY ENGINEERING
Director

6075-30

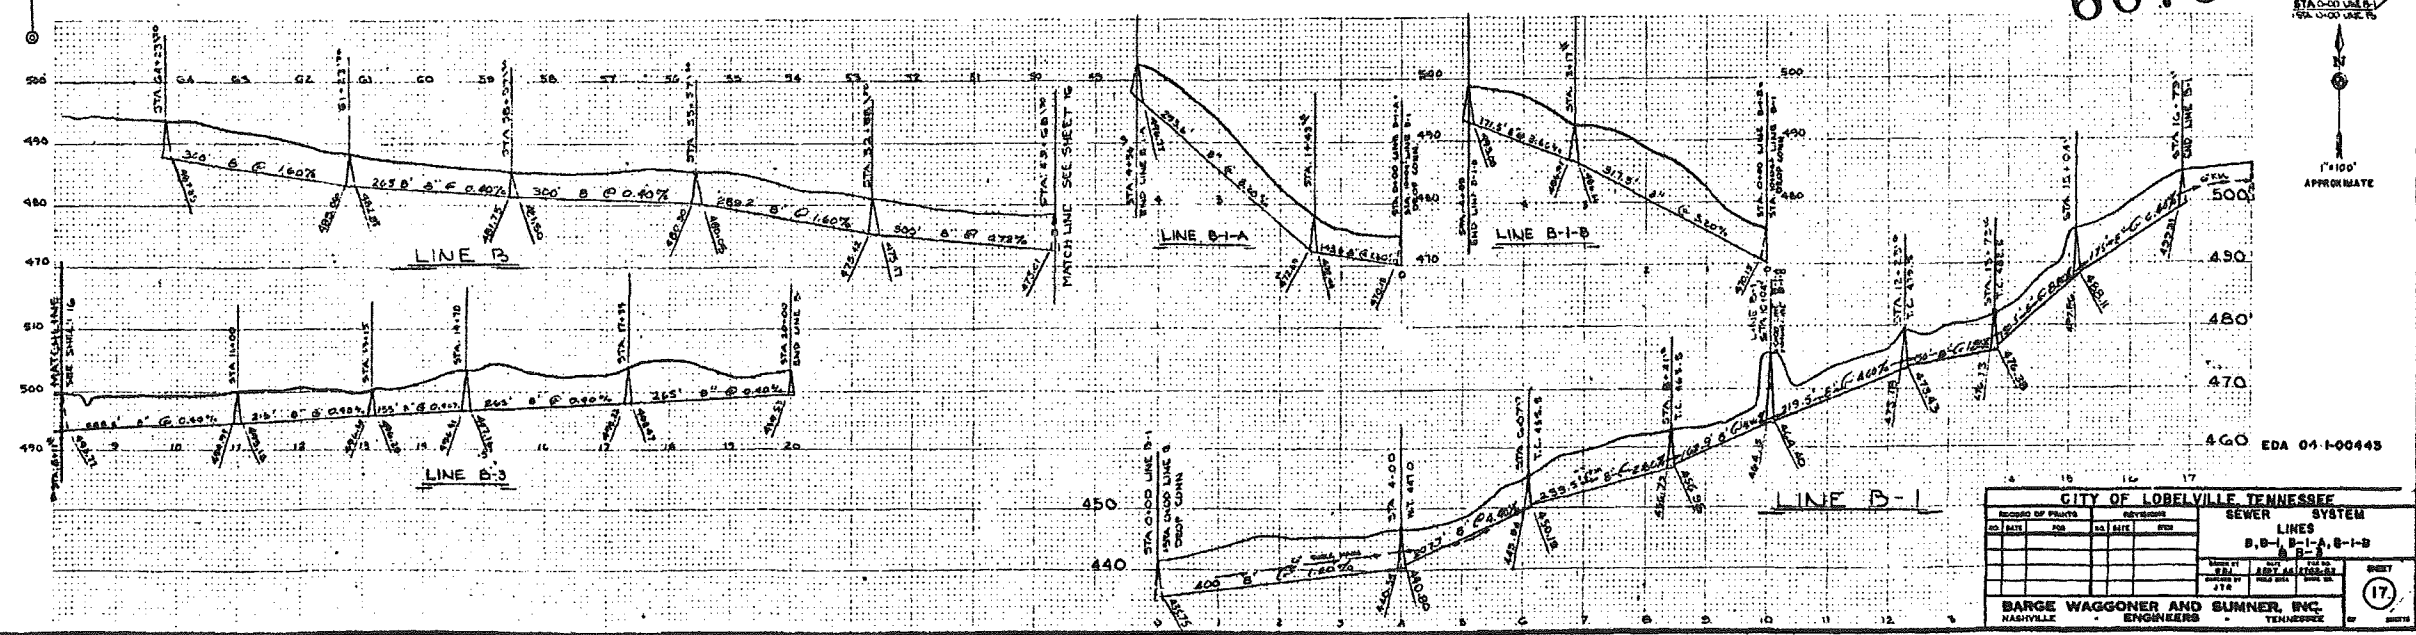

CITY OF LOBELVILLE, TENNESSEE			
RECORD OF PLATS		REVISIONS	
NO.	DATE	BY	REVISION
1			
2			
SEWER SYSTEM			
LINES			
B-1, B-2, B-3			
NO.	DATE	BY	REVISION
1			
2			
3			
BARGE WAGGONER AND SUMNER, INC.
NASHVILLE, TENNESSEE

