

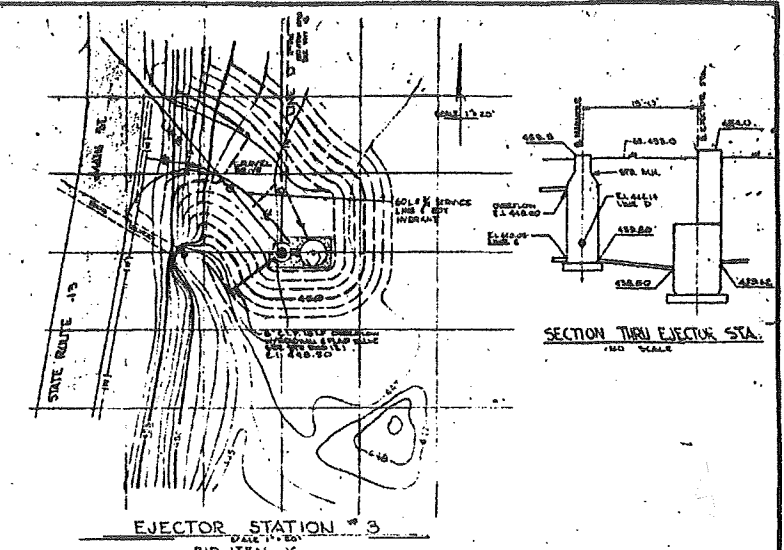
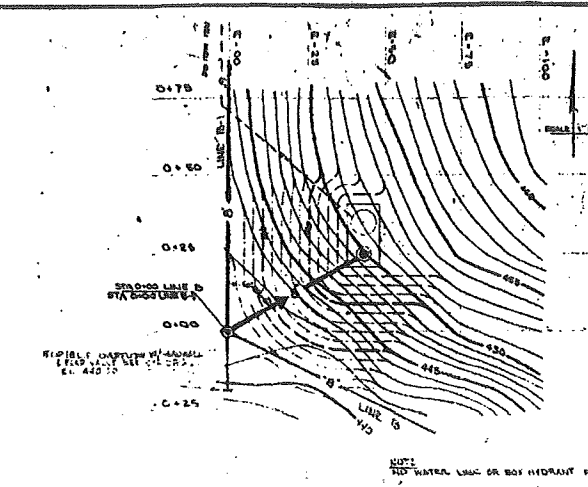
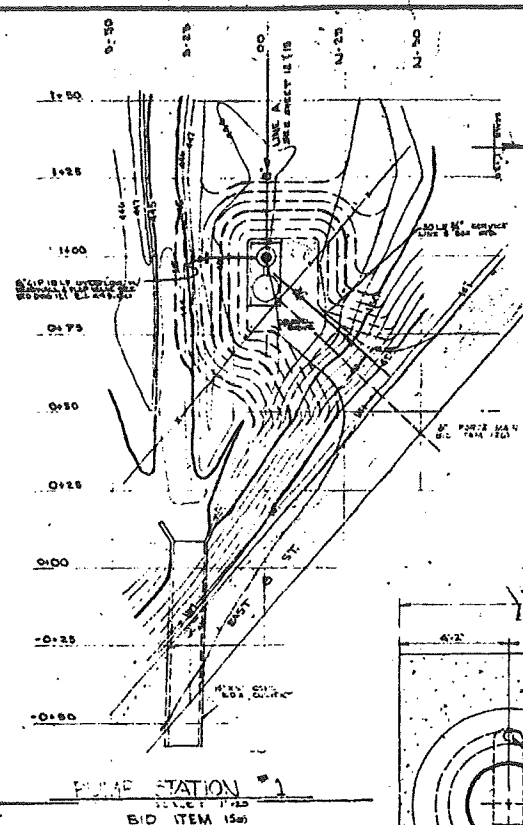
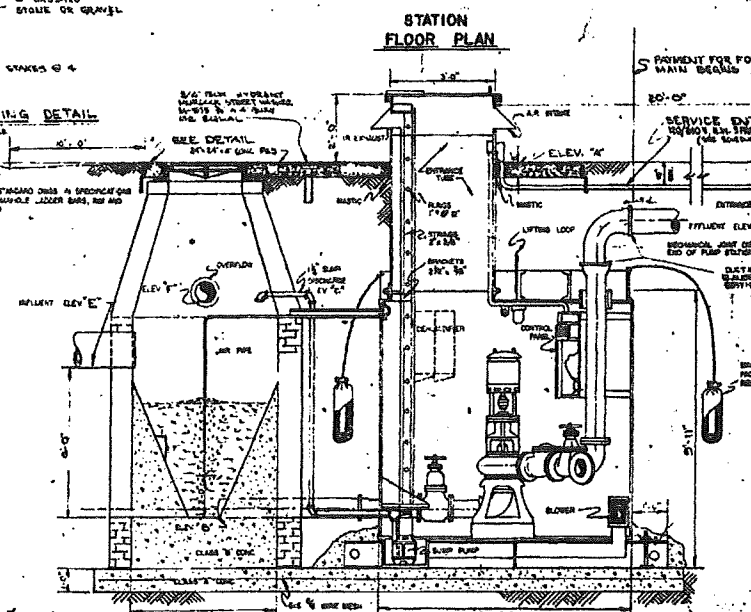


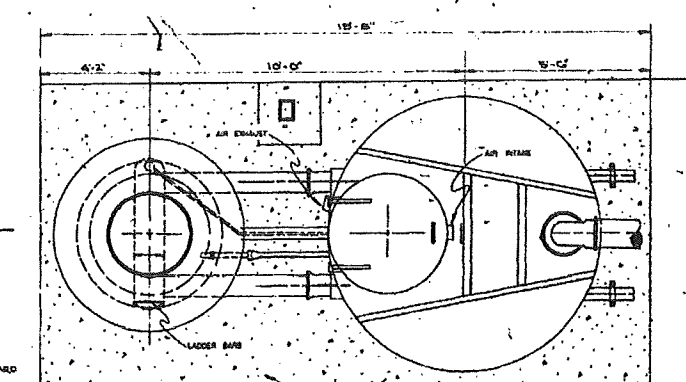


PUMP STATION #1
SCALE 1" = 20'
BID ITEM 15a)

PUMP STATION #2
SCALE 1" = 20'
BID ITEM 15b)


EJECTOR STATION #3
SCALE 1" = 20'
BID ITEM 16

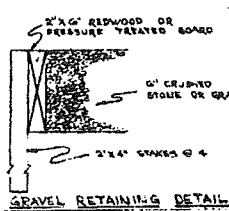


SECTION THRU STATION

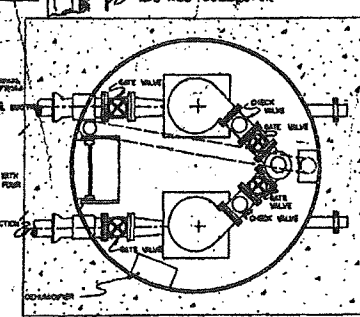

STATION PLAN

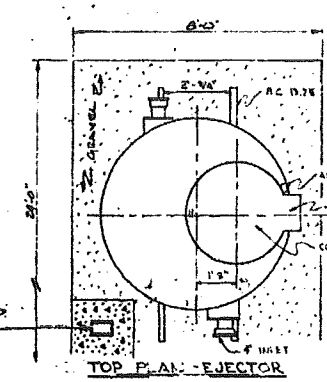


TOP PLAN - EJECTOR

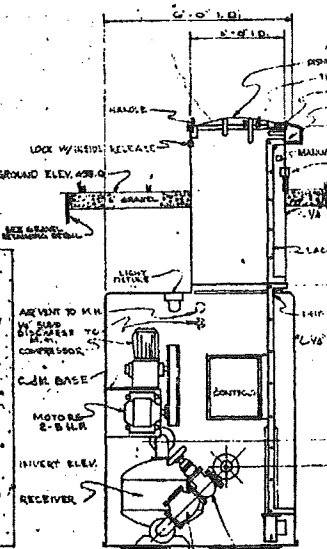

SECTION - EJECTOR

APPROVED
JUL 1 1972
TENNESSEE DEPARTMENT OF PUBLIC HEALTH
DIVISION OF SANITARY ENGINEERING
Director

6075-32

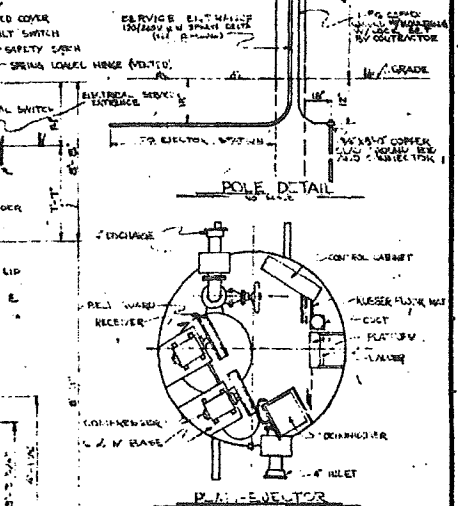

POLE DETAIL

STATION	ELEV. A	ELEV. B	ELEV. C	ELEV. D	ELEV. E	ELEV. F	RESULT	REMARKS	RECTIONS	PUMP	REMARKS
1. EAST OF ST	440.00	441.10	441.8	441.0	440.0	441.5	70.4 IN. 5/8"	45° TURN - R	C		5
2. EJECTOR	440.00	441.10	441.8	441.0	440.0	441.5	70.4 IN. 5/8"	45° TURN - R	C		5
3. EJECTOR							70.4 IN. 5/8"	45° TURN - R	C		5

CITY OF LOBELVILLE, TENNESSEE			
RECORD OF PROGRESS	REVISIONS	SEWAGE LIFT STATION	
NO.	DATE	NO.	DATE
1	7/1/72	1	7/1/72
2	7/1/72	2	7/1/72
3	7/1/72	3	7/1/72
4	7/1/72	4	7/1/72
5	7/1/72	5	7/1/72
6	7/1/72	6	7/1/72
7	7/1/72	7	7/1/72
8	7/1/72	8	7/1/72
9	7/1/72	9	7/1/72
10	7/1/72	10	7/1/72
11	7/1/72	11	7/1/72
12	7/1/72	12	7/1/72
13	7/1/72	13	7/1/72
14	7/1/72	14	7/1/72
15	7/1/72	15	7/1/72
16	7/1/72	16	7/1/72
17	7/1/72	17	7/1/72
18	7/1/72	18	7/1/72
19	7/1/72	19	7/1/72
20	7/1/72	20	7/1/72

BARGE WAGGONER AND SUMNER, INC.
NASHVILLE, TENNESSEE