




APPROVED
 DEC 20 1968
 TENNESSEE DEPARTMENT OF PUBLIC HEALTH
 DIVISION OF SANITARY ENGINEERING
 By _____

EDA 04-1-00443

CITY OF LOBELVILLE TENNESSEE									
RECORD OF PROGRESS					WATER DISTRIBUTION SYSTEM				
NO.	DATE	BY	REVISION	DATE	NO.	DATE	BY	REVISION	DATE
DESIGNED BY: _____ CHECKED BY: _____ DATE: _____					DRAWN BY: _____ DATE: _____				
BARGE WAGGONER AND SUMNER, INC. KANSAS CITY, MISSOURI									

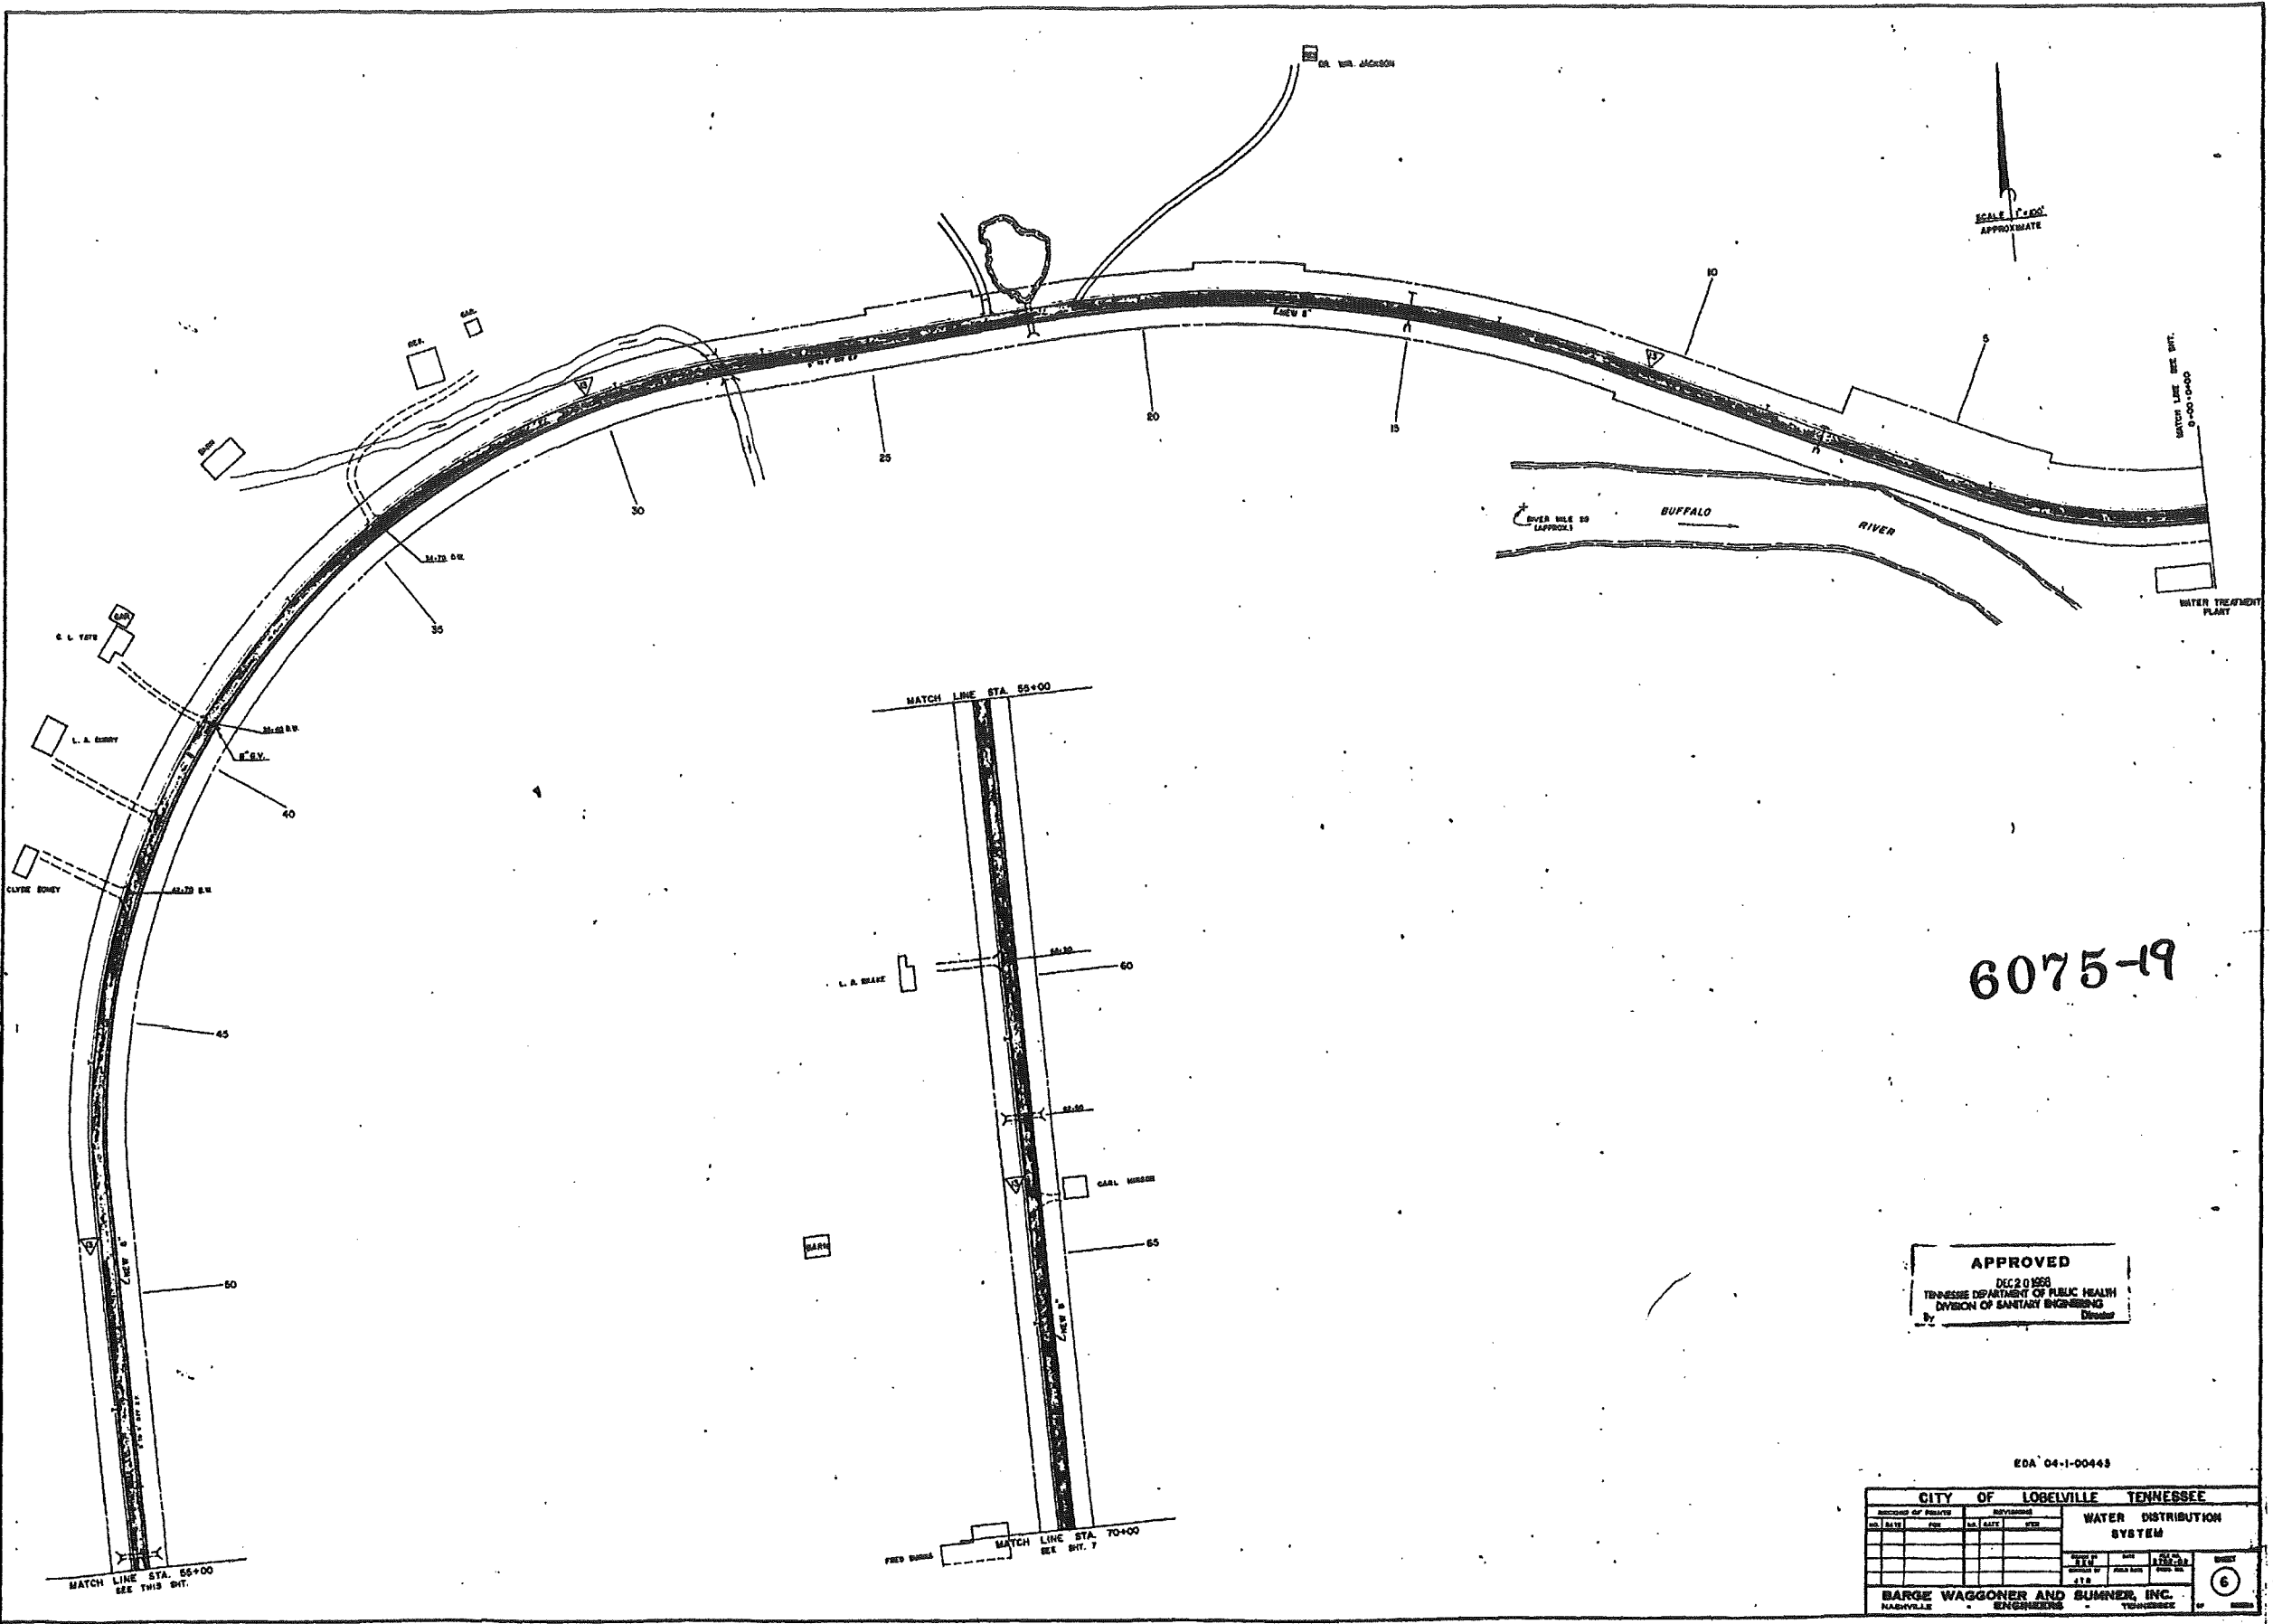