
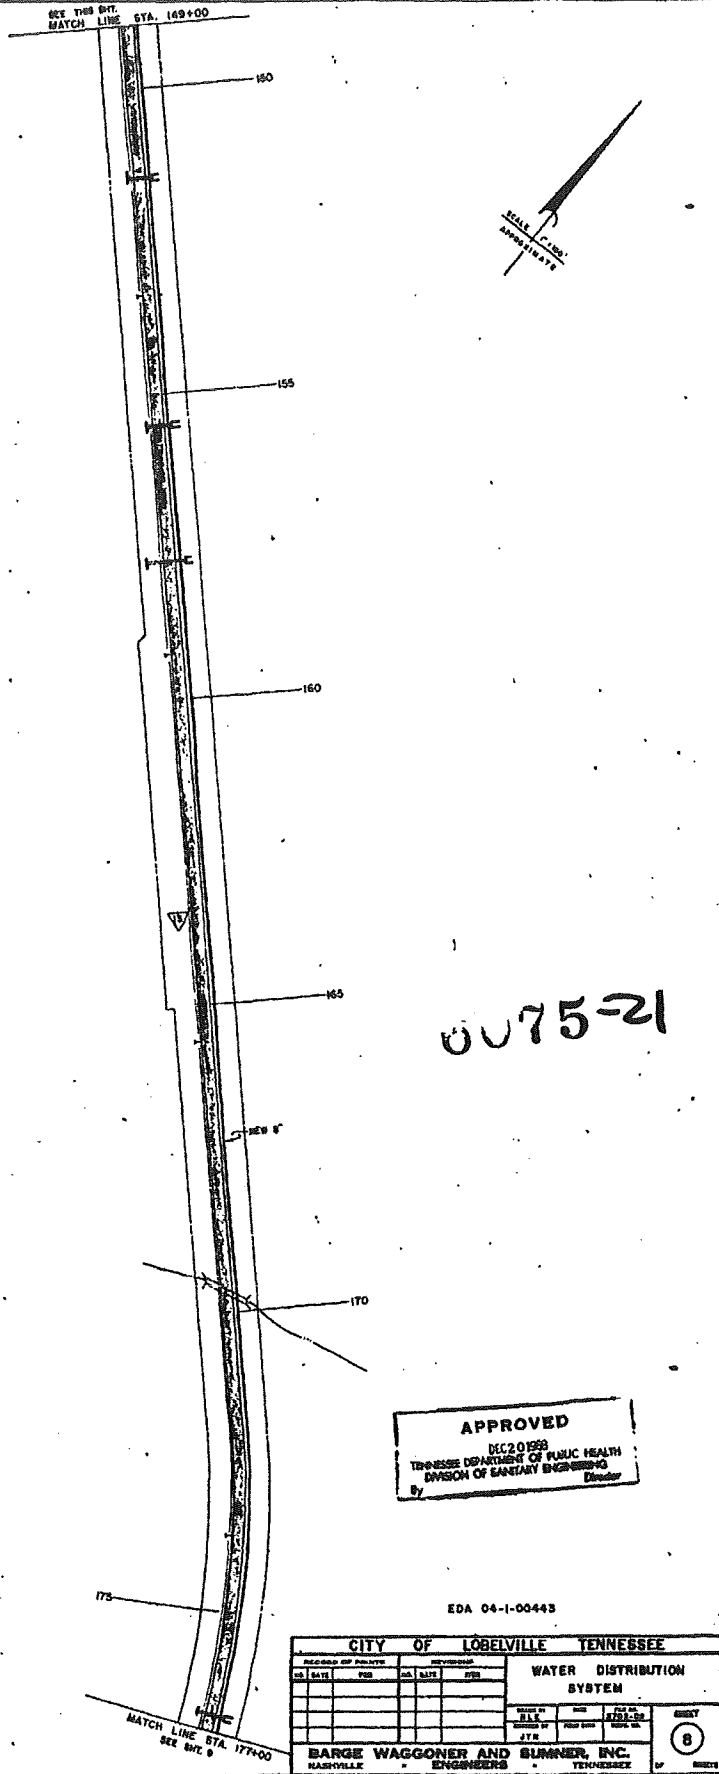
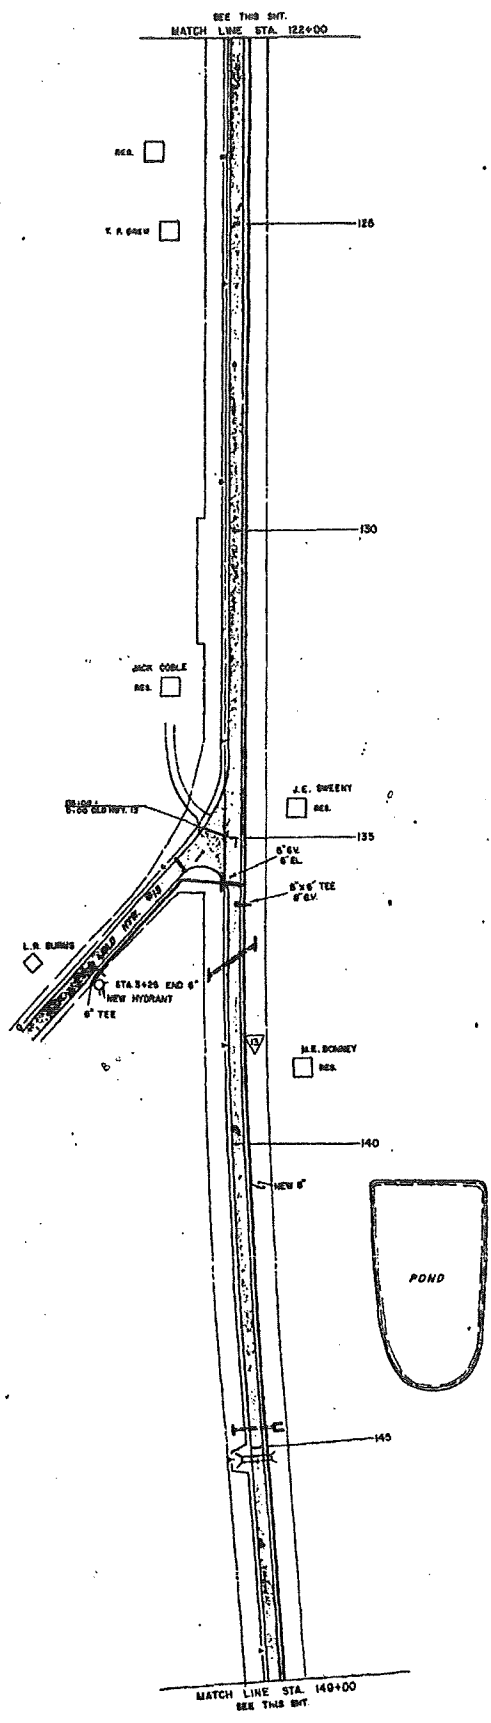


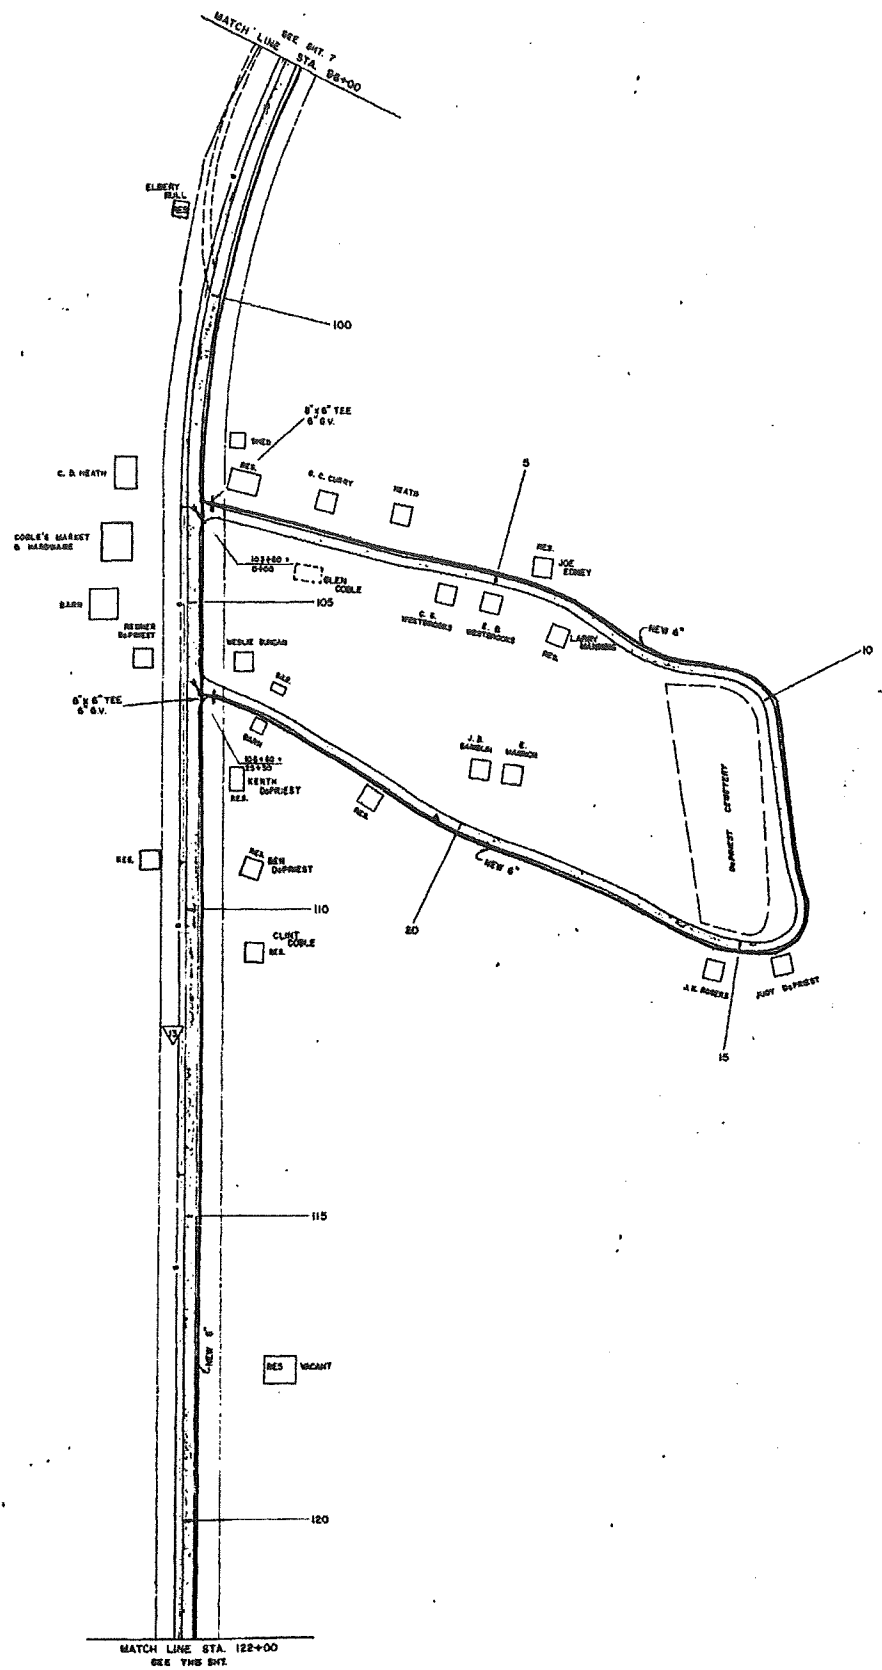

0075-21

APPROVED
DEC 20 1958
TENNESSEE DEPARTMENT OF PUBLIC HEALTH
DIVISION OF SANITARY ENGINEERING
By

EDA 04-1-00443

CITY OF LOBELVILLE TENNESSEE									
RECORD OF POINTS					WATER DISTRIBUTION SYSTEM				
NO.	DATE	BY	NO.	DATE	BY	NO.	DATE	BY	NO.

BARGE WAGGONER AND SUMNER, INC.
NASHVILLE - ENGINEERS - TENNESSEE

