



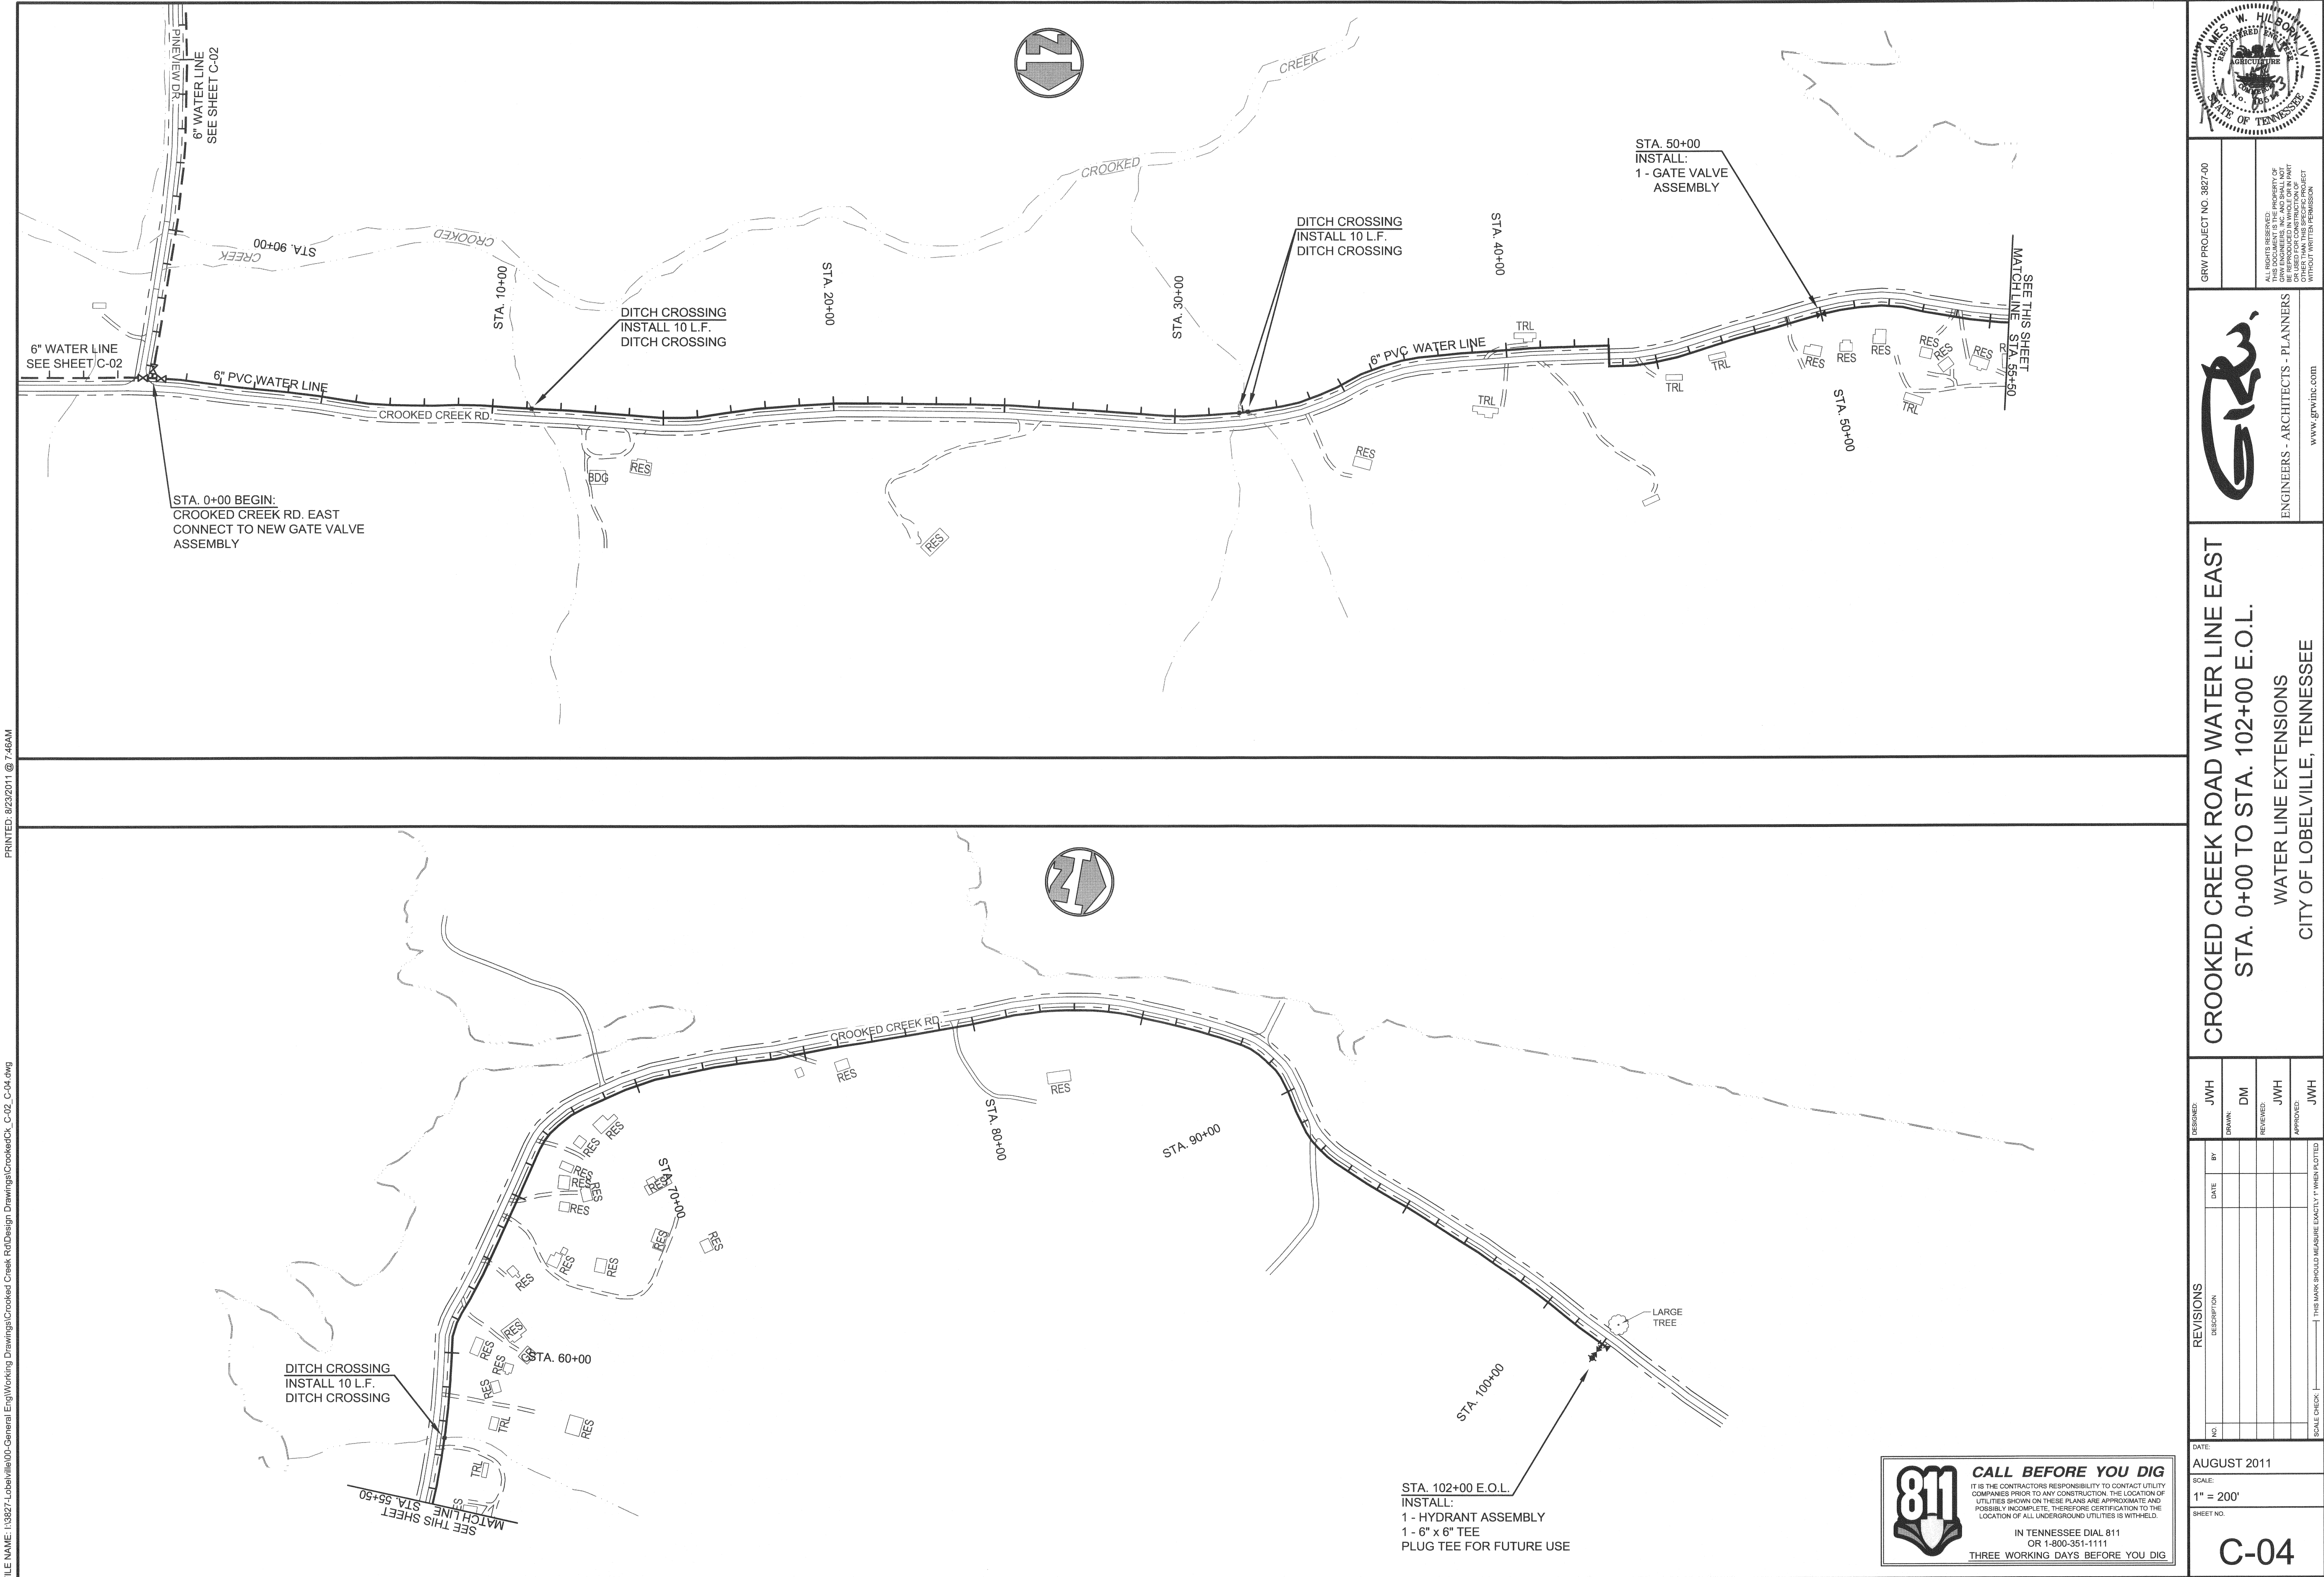

PRINTED: 8/23/2011 @ 7:46AM

FILE NAME: I:\3827-Lobelville\03-General_Eng\Working Drawings\Crooked Creek_Rd\Design Drawings\CrookedCk_C-02_C-04.dwg

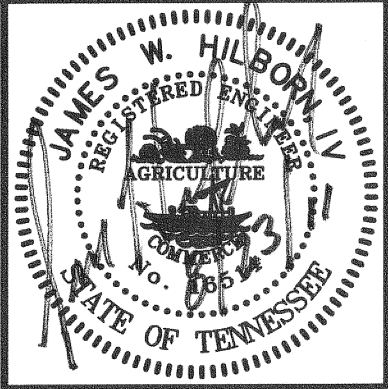

GRW PROJECT NO. 3827-00

ALL RIGHTS RESERVED.
THIS DOCUMENT IS THE PROPERTY OF
GRW ENGINEERS - ARCHITECTS - PLANNERS.
IT IS TO BE USED ONLY FOR THE PROJECT
SPECIFICALLY IDENTIFIED HEREIN AND IS NOT
TO BE REPRODUCED IN WHOLE OR IN PART
FOR ANY OTHER PROJECT WITHOUT THE WRITTEN PERMISSION
OF GRW ENGINEERS - ARCHITECTS - PLANNERS.



CROOKED CREEK ROAD WATER LINE EAST
STA. 0+00 TO STA. 102+00 E.O.L.
WATER LINE EXTENSIONS
CITY OF LOBELVILLE, TENNESSEE

REVISIONS				DESIGNED: JWH	
NO	DESCRIPTION	DATE	BY	DRAWN: DM	
				REVIEWED: JWH	
				APPROVED: JWH	
SCALE CHECK: _____				THIS MARK SHOULD MEASURE EXACTLY 1" WHEN PLOTTED	

DATE: AUGUST 2011

SCALE: 1" = 200'

SHEET NO. C-04

STATE SUBMITTAL