











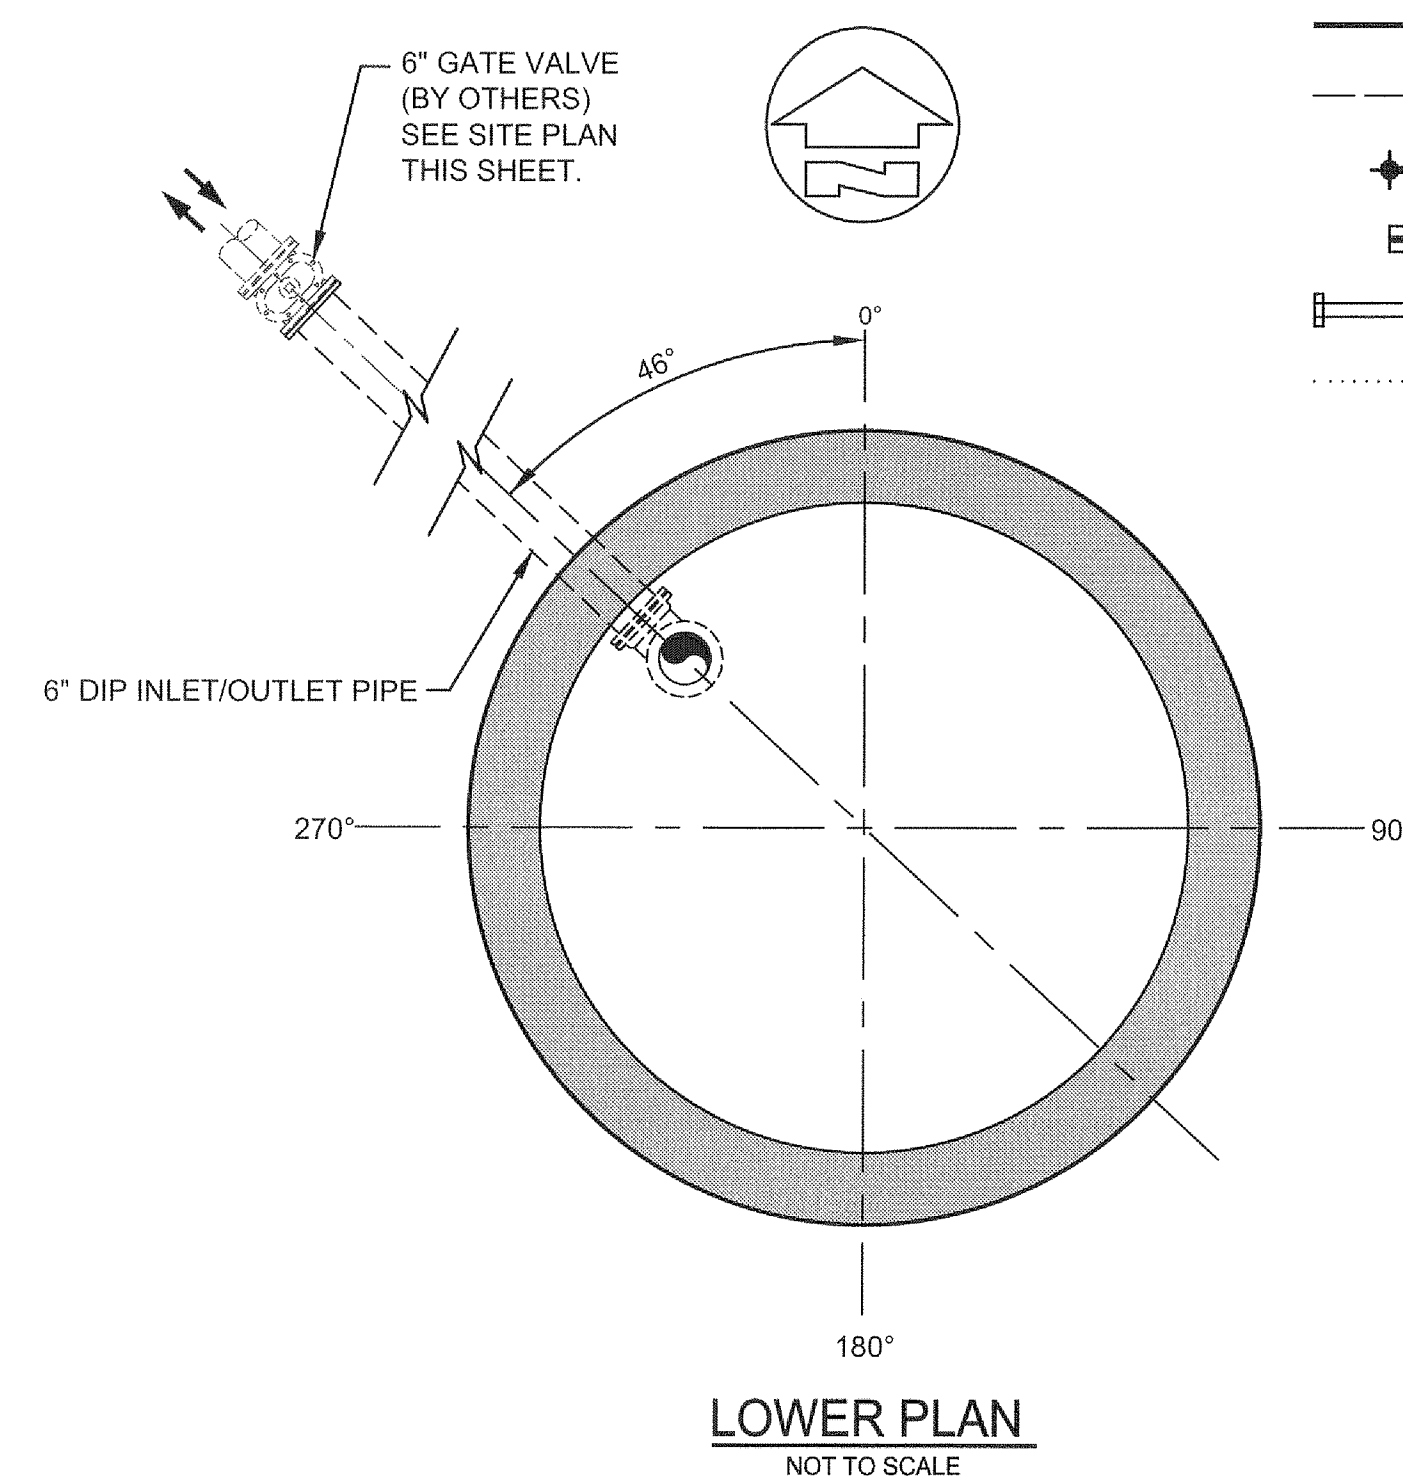



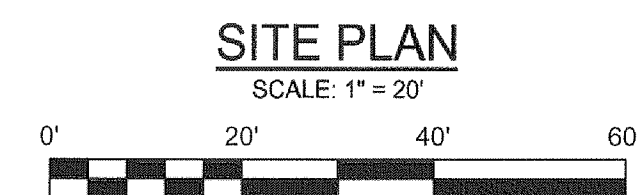


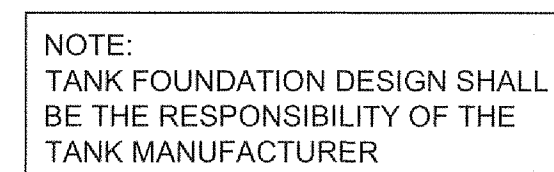



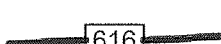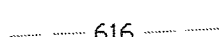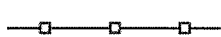

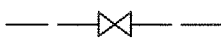NOTES:

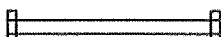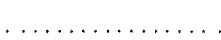1. EQUIPMENT AND DIMENSIONS ARE PER TANK MANUFACTURE
OTHER EQUIPMENT AND DIMENSIONS MAY VARY.



- ### LEGEND
- | | |
|---|----------------------------------|
|  | NEW GRAVEL DRIVE/AREA |
|  | NEW RIP-RAP |
|  | NEW POURED IN PLACE CONCRETE |
|  | FUTURE STRUCTURE |
|  | NEW CONTOUR ELEVATION |
|  | EXISTING CONTOUR ELEVATION |
|  | NEW SILT FENCE |
|  | NEW CHAIN LINK FENCE |
|  | NEW WATER LINE & GATE VALVE |
|  | EXISTING WATER LINE & GATE VALVE |
|  | NEW FIRE HYDRANT |
|  | NEW RESTRAINED PLUG |
|  | NEW CULVERT w/HEADWALLS |
|  | EXISTING POWER LINE |
|  | EXISTING POWER POLE |
|  | NEW 1/2" IRON PIN SET |
|  | EXISTING 1/2" IRON PIN |
|  | RR SPIKE SET |

[illegible]