

- EROSION CONTROL NOTES:**
1. All work shall be done in accordance with the Storm Water Pollution Prevention Plan (SWPPP).
  2. No work may proceed until a Notice of Coverage (NOC) has been issued by the State of Tennessee Department of Environment and Conservation.
  3. SWPPP must be available at the site for review at all times.
  4. At a minimum, the Contractor shall install silt fence on the downhill side of the proposed water line construction area.
  5. Contractor shall provide ditch checks as required.
  6. Contractor shall furnish and install temporary erosion control blanket/matting on all slopes greater than 2.5:1
  7. All areas to remain bare more than 15 days must be temporarily stabilized in accordance with the current Best Management Practices (BMP's).
  8. Erosion controls shall be checked and repaired if necessary at least twice each calendar week in accordance with the SWPPP.
  9. All erosion control measures utilized within State of Tennessee ROW's shall meet or exceed the TDOT requirements.

**CALL BEFORE YOU DIG**

IT IS THE CONTRACTORS RESPONSIBILITY TO CONTACT UTILITY COMPANIES PRIOR TO ANY CONSTRUCTION. THE LOCATION OF UTILITIES SHOWN ON THESE PLANS ARE APPROXIMATE AND POSSIBLY INCOMPLETE. THEREFORE CERTIFICATION TO THE LOCATION OF ALL UNDERGROUND UTILITIES IS WITHHELD.


1 - 800 - 351-1111

**THREE WORKING DAYS BEFORE YOU DIG**

IN TENNESSEE CALL

1 - 800 - 351-1111

**THREE WORKING DAYS BEFORE YOU DIG**

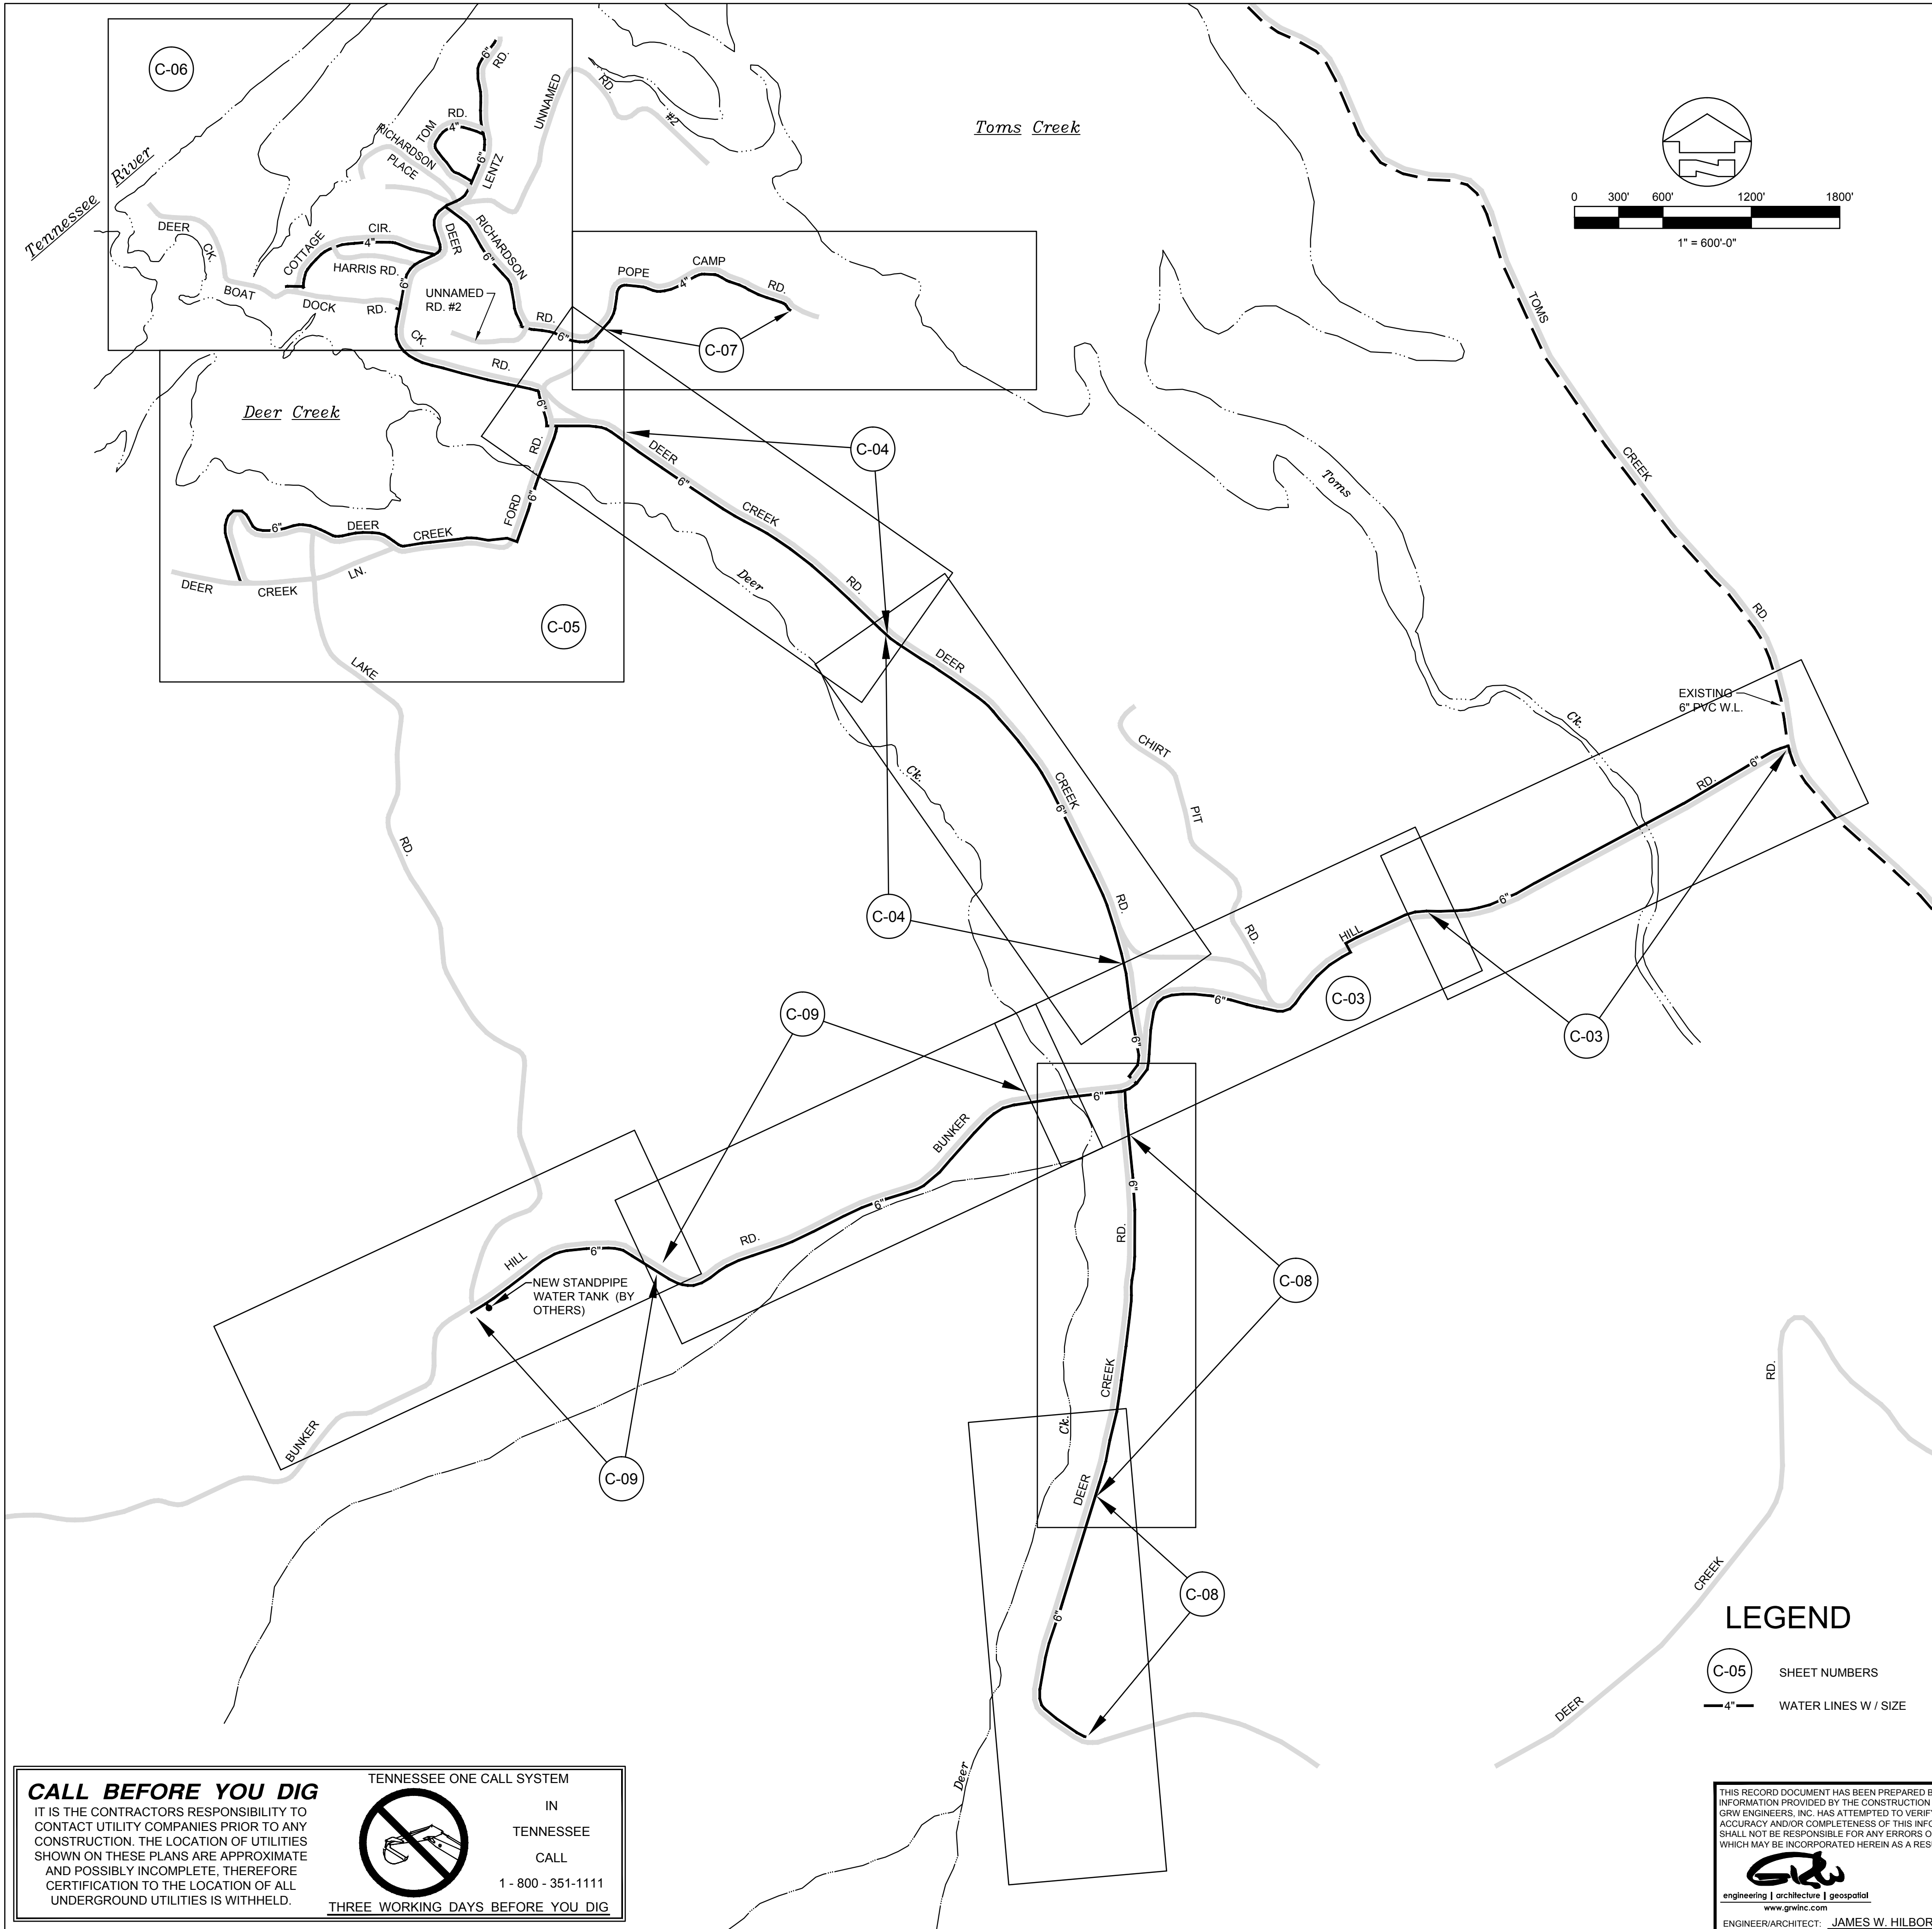

**LEGEND**

C-05 SHEET NUMBERS

4" WATER LINES W / SIZE

THIS RECORD DOCUMENT HAS BEEN PREPARED BASED ON INFORMATION PROVIDED BY THE CONSTRUCTION CONTRACTOR. GRW ENGINEERS, INC. HAS ATTEMPTED TO VERIFY THE ACCURACY AND/OR COMPLETENESS OF THIS INFORMATION BUT SHALL NOT BE RESPONSIBLE FOR ANY ERRORS OR OMISSIONS WHICH MAY BE INCORPORATED HEREIN AS A RESULT.

**GRW**

engineering | architecture | geospatial

www.grwinc.com

ENGINEER/ARCHITECT: JAMES W. HILBORN

CONSTRUCTION COMPANY: WARD CONSTRUCTION

DATE: MAY 5, 2014

GRW PROJECT NO. 3827-02

ALL RIGHTS RESERVED. THIS DOCUMENT IS THE PROPERTY OF GRW ENGINEERS, INC. AND SHALL BE REPRODUCED IN WHOLE OR IN PART WITHOUT WRITTEN PERMISSION FROM GRW ENGINEERS, INC.

**GRW**

ENGINEERS - ARCHITECTS - PLANNERS

www.grwinc.com

**KEYMAP**

WATER LINE EXTENSION

CITY OF LOBELVILLE AND PERRY COUNTY TENNESSEE

NO.	DESCRIPTION	DATE	BY	DESIGNED: JWH	DRAWN: SG	REVIEWED: JWH	APPROVED: JWH

REVISIONS

DATE: JULY 2010

SCALE: AS NOTED

SHEET NO. C-02