
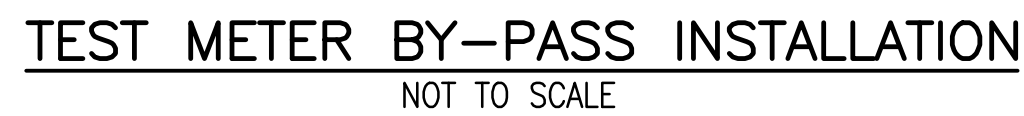
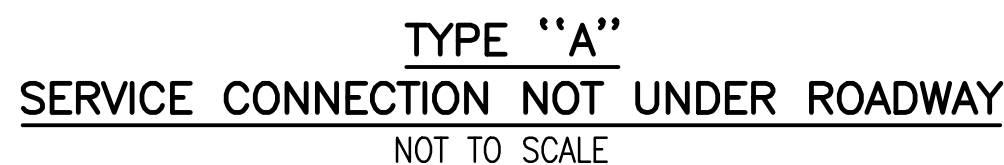
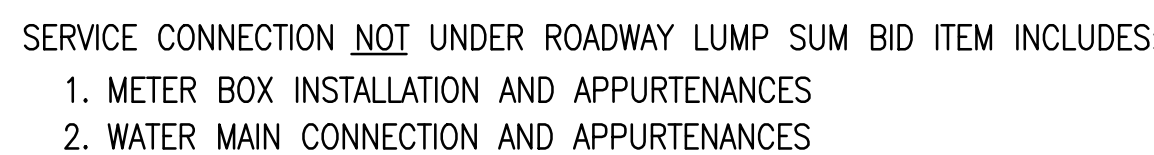


PRINTED: 5/15/2014 @ 5:01PM

NOTES:


1. 17"x28" CONC. METER BOX - AS MANUF. BY BROOKS PRODUCTS, INC. MEMPHIS, TN - OR APPROVED EQUAL. USE EXTENSIONS AS REQ'D.
2. PLACE MANUAL AIR BLEED VALVE @ HIGH POINT IN LINE (SHOWN ON PLANS)
3. SEAL SLOTS IN METER BOX W/NON-SHRINK GROUT.
4. ALL ACCESSORY VALVES AND PIPING SHALL BE BRASS UNLESS OTHERWISE NOTED.

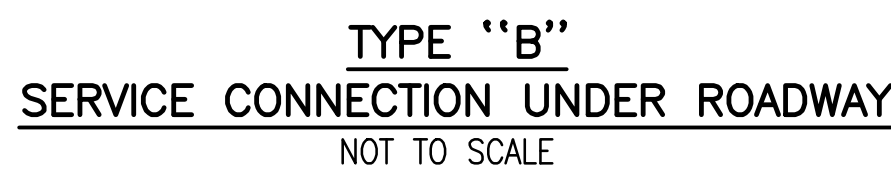

- NOTES:
1. THE CONTRACTOR SHALL MAKE PROVISIONS TO GIVE ADEQUATE SPACE FOR AIR RELEASE APPURTENANCES (SEE SHOP DRAWINGS).
 2. 17"x28" CONC. METER BOX - AS MANUF. BY BROOKS PRODUCTS, INC. MEMPHIS, TN - OR APPROVED EQUAL.
 3. SEAL SLOTS IN METER BOX W/NON-SHRINK GROUT.
 4. ALL ACCESSORY VALVES AND PIPING SHALL BE BRASS.



- NOTES:
1. STANDARD OBLONG PLASTIC METER BOX - AS SUPPLIED BY G & C - OR APPROVED EQUAL.
 2. METER BOX SHALL BE 24" MINIMUM DEPTH.
 3. WHERE PRESSURE REGULATOR IS REQUIRED USE FORD TANDEM SETTER WITH METER BOX SIZED TO FIT. AS MANUF. BY POLY PLASTIC WATER METER BOX CO. - OR APPROVED EQUAL.

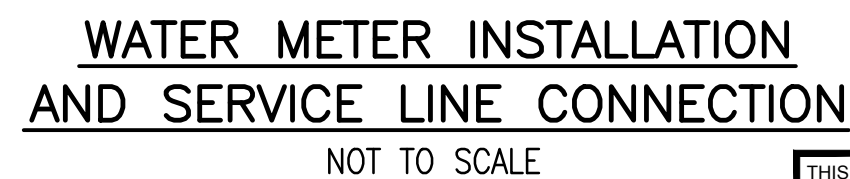

engineering | architecture | geospatial
www.grwinc.com

ENGINEER/ARCHITECT: JAMES W. HILBORN
CONSTRUCTION COMPANY: WARD CONSTRUCTION
DATE: MAY 5, 2014

This document, originally issued, sealed, and signed by James W. Hilborn, Kentucky Professional Engineer, No. 16514, on March 14, 2011, shall not be used in lieu of a certified document.

GRW PROJECT NO. 3827-02

ALL RIGHTS RESERVED:
THIS DOCUMENT IS THE PROPERTY OF
GRW ENGINEERS, INC. AND SHALL NOT
BE REPRODUCED IN WHOLE OR IN PART
OR USED FOR CONSTRUCTION OF
ANY OTHER THAN THIS SPECIFIC PROJECT

ENGINEERS - ARCHITECTS - PLANNERS

www.grvnc.com

STANDARD WATER LINE DETAILS

WATER LINE EXTENSION
CITY OF LOBELVILLE AND PERRY COUNTY TENNESSEE

| REVISIONS | | | DESIGNED | LER |
|-----------|-------------|------|----------|-----------|
| NO. | DESCRIPTION | DATE | BY | CHOWN |
| | | | | SG |
| | | | | REWORKED |
| | | | | LER |
| | | | | APPROVED: |

SCALE CHECK: _____ THIS MARK SHOWN IN MEASURE EXACTLY V. V. MEASURE OBTAINED

| | |
|-----------|-----------|
| DATE: | JULY 2010 |
| SCALE: | AS NOTED |
| SHEET NO. | |

C-10