


STATE HIGHWAY 13 NORTH WATER LINE EXTENSION

CITY OF LOBELVILLE, TENNESSEE

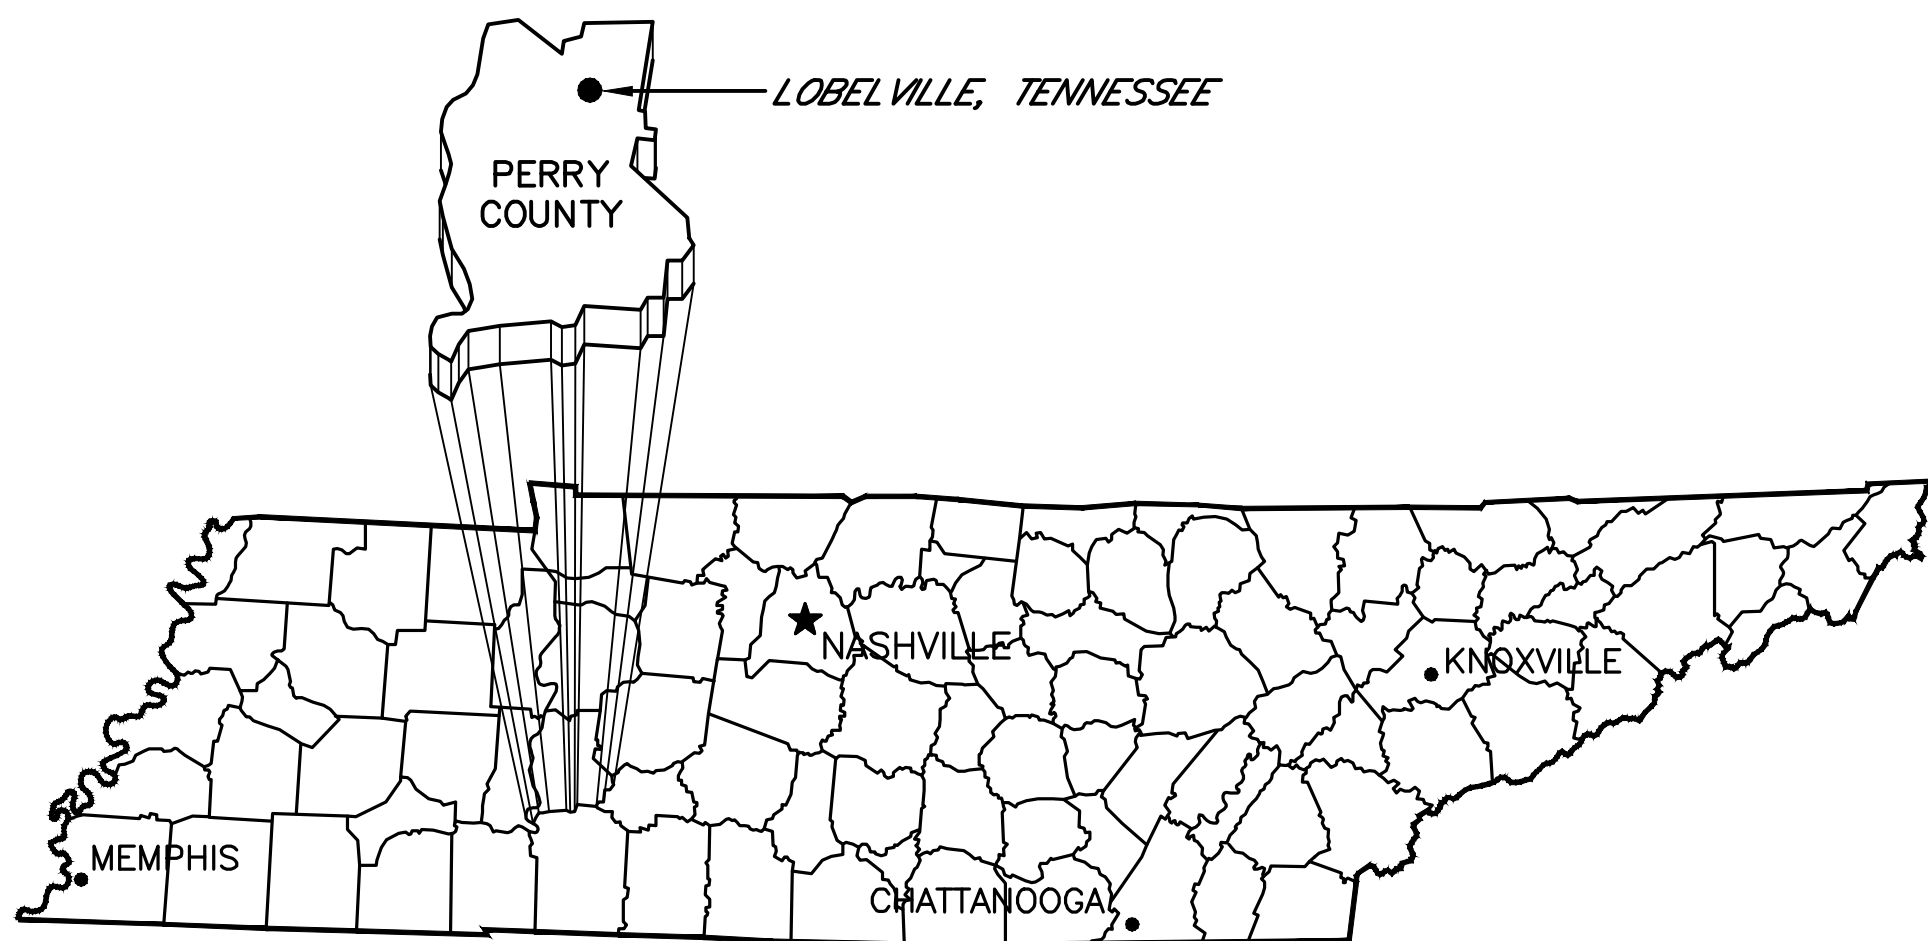


TENNESSEE VICINITY MAP
NOT TO SCALE



ENGINEERS - ARCHITECTS - PLANNERS

www.grwinc.com

DWG. No.	INDEX OF DRAWINGS
	COVER SHEET
C-2 -	GENERAL NOTES, PROJECT AREA MAP AND LEGEND
C-3 -	HIGHWAY 13 - 12" PVC WATER LINE - STA. 0+00 TO STA. 52+42
C-4 -	STANDARD WATER LINE DETAILS
C-5 -	STANDARD WATER LINE DETAILS
C-6 -	STANDARD EROSION CONTROL DETAILS

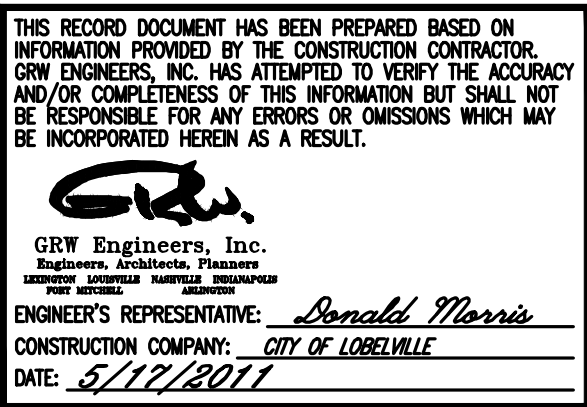

OCTOBER 2010

GRW PROJECT NO. 3827-02