


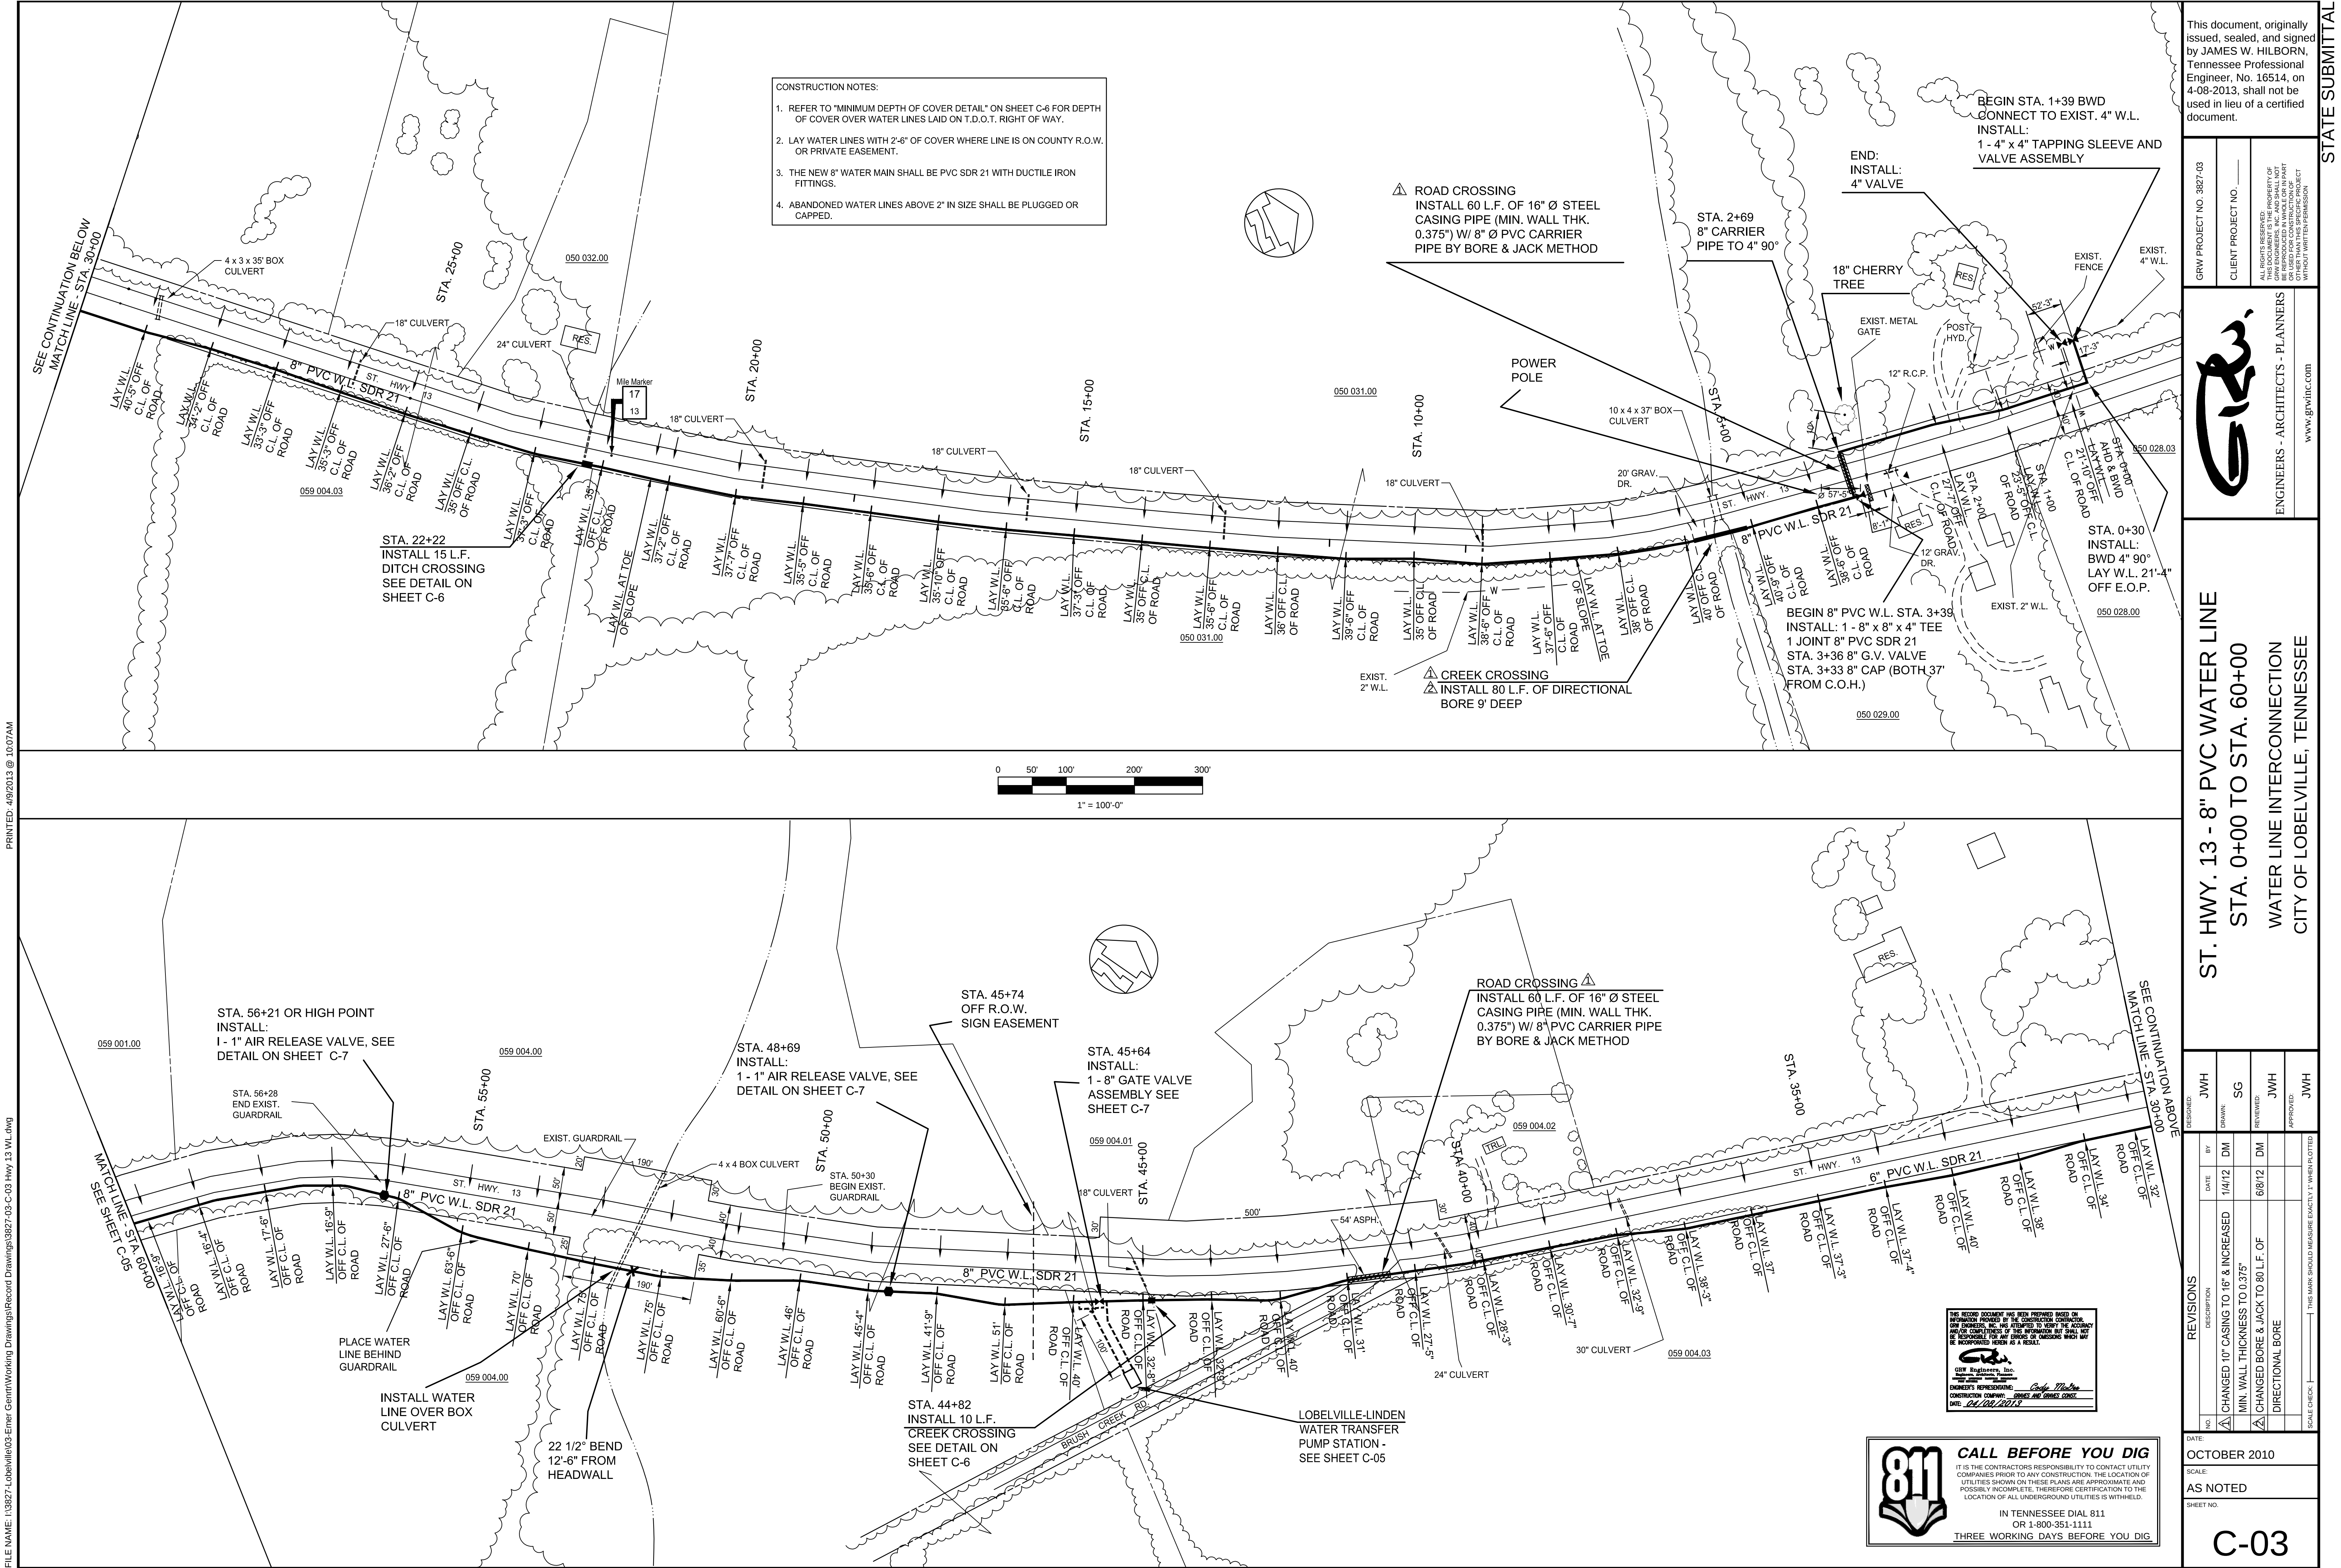

This document, originally issued, sealed, and signed by JAMES W. HILBORN, Tennessee Professional Engineer, No. 16514, on 4-08-2013, shall not be used in lieu of a certified document.

GRW PROJECT NO. 3827-03

CLIENT PROJECT NO. _____

ALL RIGHTS RESERVED. NO PART OF THIS DOCUMENT IS TO BE REPRODUCED OR TRANSMITTED IN ANY FORM OR BY ANY MEANS, ELECTRONIC OR MECHANICAL, INCLUDING PHOTOCOPYING, RECORDING, OR BY ANY INFORMATION STORAGE AND RETRIEVAL SYSTEM, WITHOUT THE WRITTEN PERMISSION OF GRW ENGINEERS, INC. AND SHALL NOT BE USED FOR CONSTRUCTION OF OTHER THAN THIS SPECIFIC PROJECT.

ENGINEERS - ARCHITECTS - PLANNERS

www.grwinc.com

ST. HWY. 13 - 8" PVC WATER LINE
STA. 0+00 TO STA. 60+00
WATER LINE INTERCONNECTION
CITY OF LOBELVILLE, TENNESSEE

DESIGNED	JWH	BY	JWH
DRAWN	SG	CHECKED	DM
REVIEWED	JWH	APPROVED	JWH

DATE: OCTOBER 2010

SCALE: AS NOTED

SHEET NO. C-03