

- NOTES:
1. THRUST BLOCKS DESIGNED FOR 200 PSI PRESSURE AND 2000 PSF SOIL BEARING. FOR GREATER PRESSURE OR LESS SOIL BEARING, QUANTITIES WILL HAVE TO BE RECALCULATED.
 2. THRUST BLOCKING TO BE POURED AGAINST UNDISTURBED EARTH.
 3. IF EXACT SIZE PIPE BLOCKING IS NOT SHOWN, USE NEXT LARGER SIZE.
 4. THRUST BLOCKING TO BE POURED IN PLACE CLASS C CONC.

THRUST BLOCKING DETAIL
NOT TO SCALE

90° BEND							
SIZE	16"	12"	10"	8"	6"	4"	2"
A	84	60	51	42	32	24	18
B	72	60	51	42	32	24	18
C	30	18	16	12	12	9	9
D	34	30	24	17	13	9	9

45° BEND							
SIZE	16"	12"	10"	8"	6"	4"	2"
A	58	43	38	32	24	18	12
B	58	43	38	32	24	18	12
C	24	16	14	12	12	8	8
D	24	18	15	12	9	6	6


22 1/2° BEND							
SIZE	16"	12"	10"	8"	6"	4"	2"
A	42	32	27	24	18	12	9
B	42	32	27	24	18	12	9
C	18	16	14	12	10	8	8
D	18	13	11	9	6	4	4

11 1/4° BEND							
SIZE	16"	12"	10"	8"	6"	4"	2"
A	30	24	21	17	12	9	9
B	30	24	21	17	12	9	9
C	18	16	14	12	10	8	8
D	12	9	8	6	5	4	4

PLUG							
SIZE	16"	12"	10"	8"	6"	4"	2"
A	66	52	43	34	27	20	18
B	66	52	43	34	27	20	18
C	12	12	12	12	12	12	12
D	44	32	22	15	11	11	11

TEE							
SIZE	MAIN 16"	12"	12"	12"	8"-10"	8"-12"	2"-6"
A	66	52	43	34	43	26	26
B	66	52	43	34	43	26	26
C	30	12	12	12	12	12	12
D	30	26	21	14	21	13	13

DIMENSIONS ARE IN INCHES

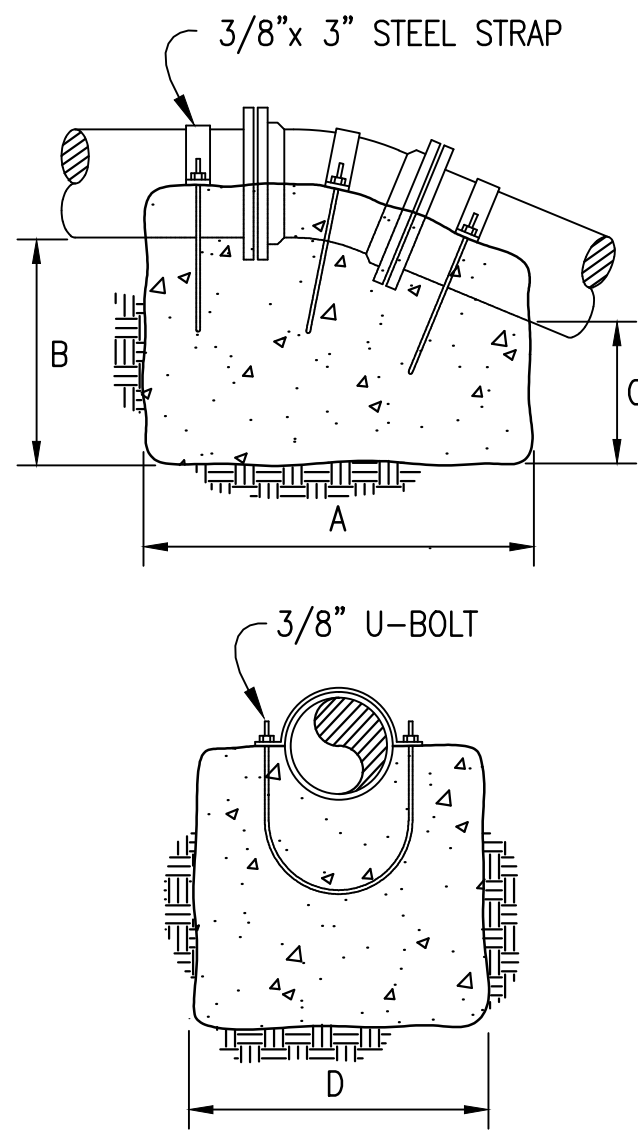

- NOTES:
1. THRUST BLOCKING DESIGNED FOR 150 PSI PRESSURE. FOR GREATER PRESSURE QUANTITIES WILL HAVE TO BE RECALCULATED.
 2. THRUST BLOCKING TO BE POURED AGAINST UNDISTURBED EARTH.
 3. IF EXACT SIZE PIPE BLOCKING IS NOT SHOWN, USE NEXT LARGER SIZE.
 4. THRUST BLOCKING TO BE POURED IN PLACE - CLASS "C" CONCRETE.

VERTICAL CONCRETE ANCHOR
NOT TO SCALE

90° BEND							
SIZE	16"	12"	10"	8"	6"	4"	2"
A	85	67	60	54	42	34	30
B	85	67	60	54	42	34	18
C	80	63	56	50	38	30	16
D	76	66	60	48	48	36	24


45° BEND							
SIZE	16"	12"	10"	8"	6"	4"	2"
A	72	60	50	46	35	30	24
B	72	60	50	46	35	28	24
C	68	56	46	42	30	24	18
D	72	60	60	48	48	36	24

22 1/2° BEND							
SIZE	16"	12"	10"	8"	6"	4"	2"
A	58	50	42	38	30	24	18
B	58	48	42	38	30	24	18
C	54	44	38	34	26	20	14
D	60	48	48	36	36	30	24

11 1/4° BEND							
SIZE	16"	12"	10"	8"	6"	4"	2"
A	42	36	30	29	24	20	18
B	42	36	30	29	24	20	18
C	38	32	26	24	20	16	14
D	60	48	48	36	30	24	24


DIMENSIONS ARE IN INCHES

- NOTES:
1. CRUSHED STONE OR CONCRETE AS REQUIRED.

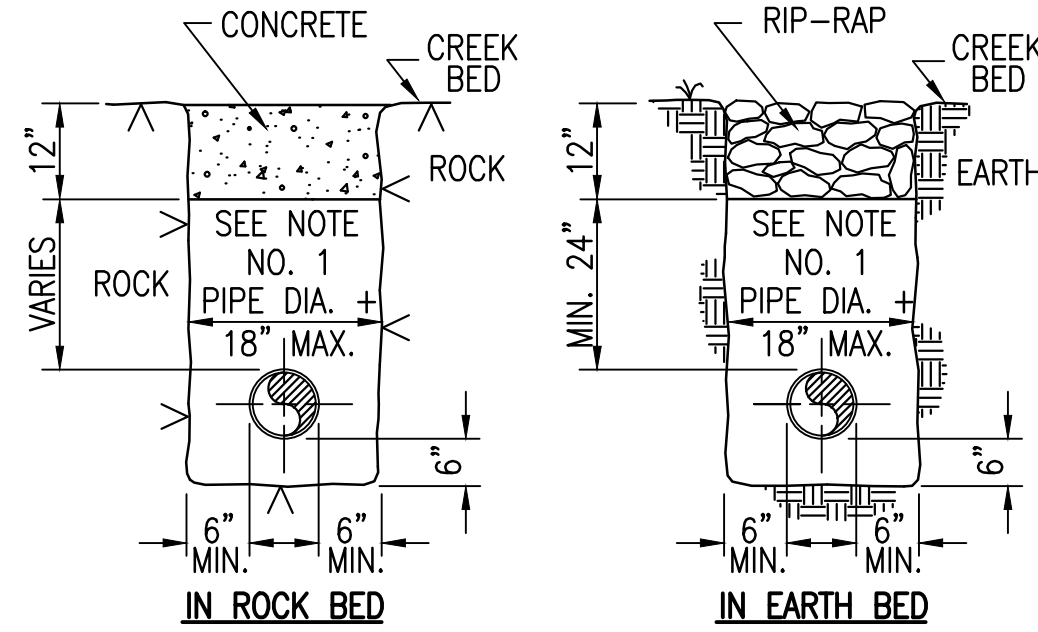


STANDARD DITCH CROSSING DETAIL
NOT TO SCALE



- NOTES:
1. CRUSHED STONE OR CONCRETE AS REQUIRED.

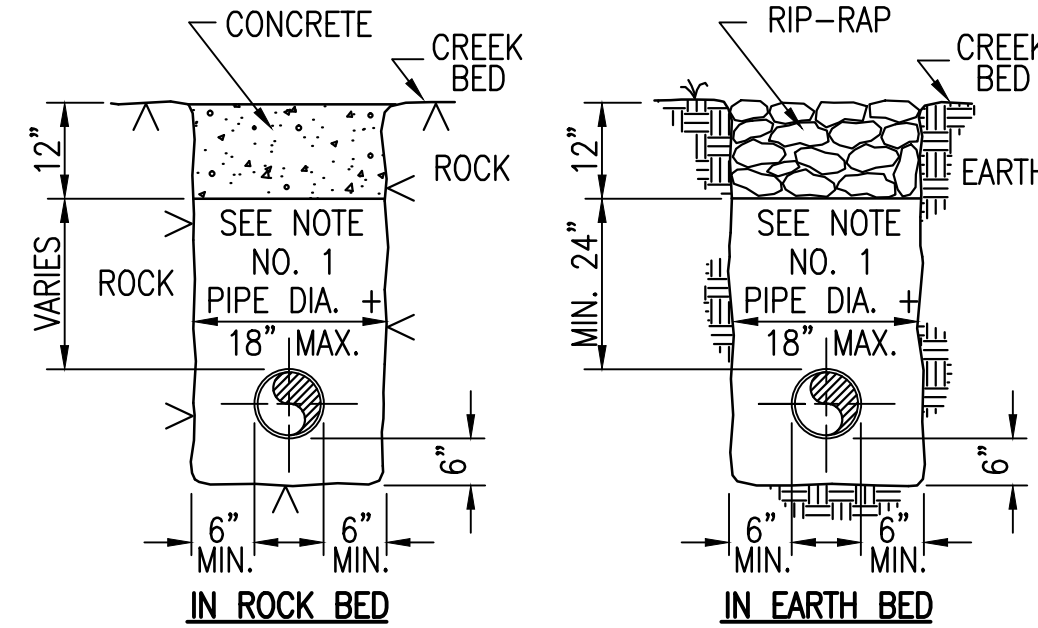


STANDARD CREEK CROSSING DETAIL
NOT TO SCALE

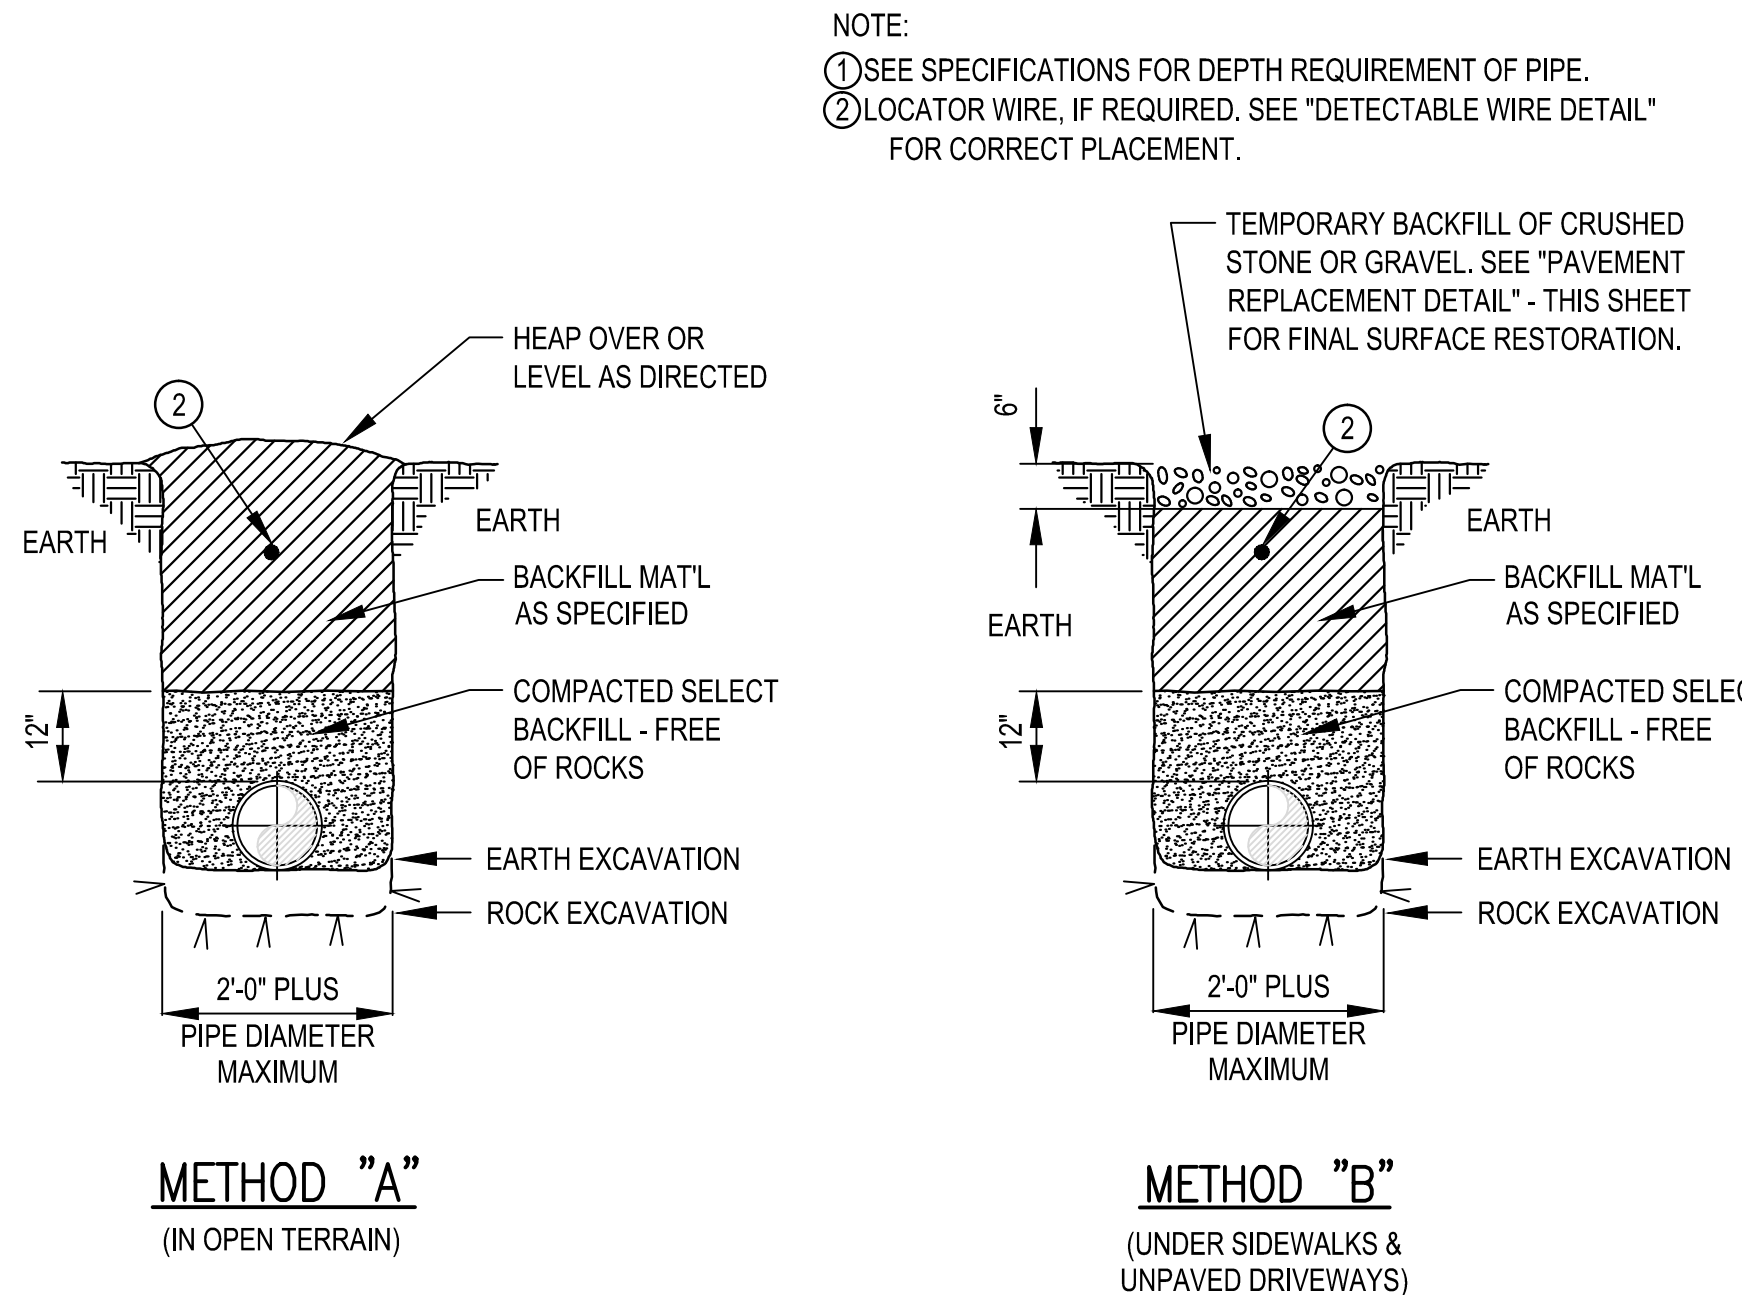


PRESSURE PIPE BEDDING & BACKFILLING DETAILS
NOT TO SCALE

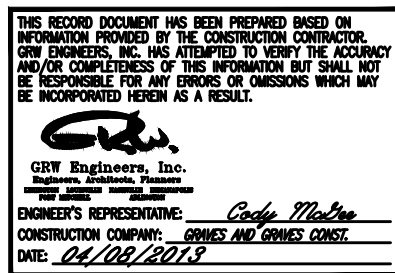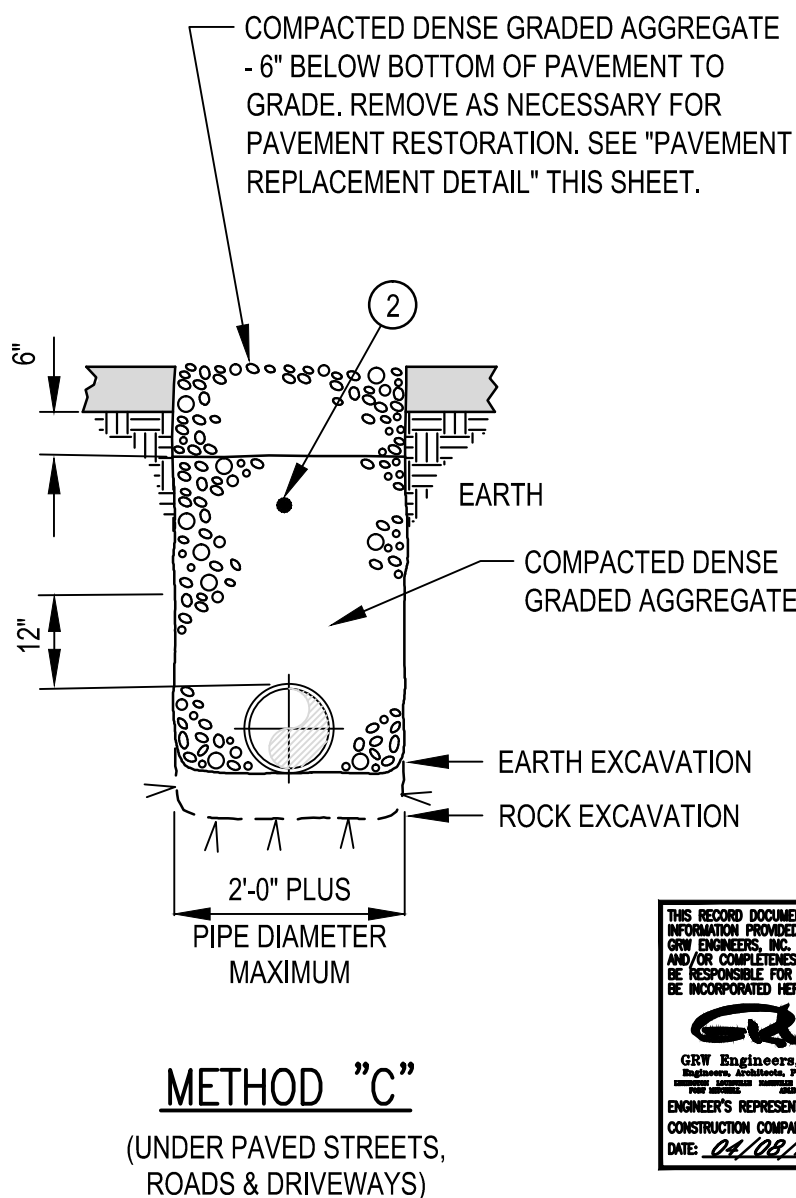

CALL BEFORE YOU DIG
IT IS THE CONTRACTOR'S RESPONSIBILITY TO CONTACT UTILITY COMPANIES PRIOR TO ANY CONSTRUCTION. THE LOCATION OF UTILITIES SHOWN ON THESE PLANS ARE APPROXIMATE AND POSSIBLY INCOMPLETE. THEREFORE CERTIFICATION TO THE LOCATION OF ALL UNDERGROUND UTILITIES IS WITHHELD.
IN TENNESSEE DIAL 811
OR 1-800-351-1111
THREE WORKING DAYS BEFORE YOU DIG.

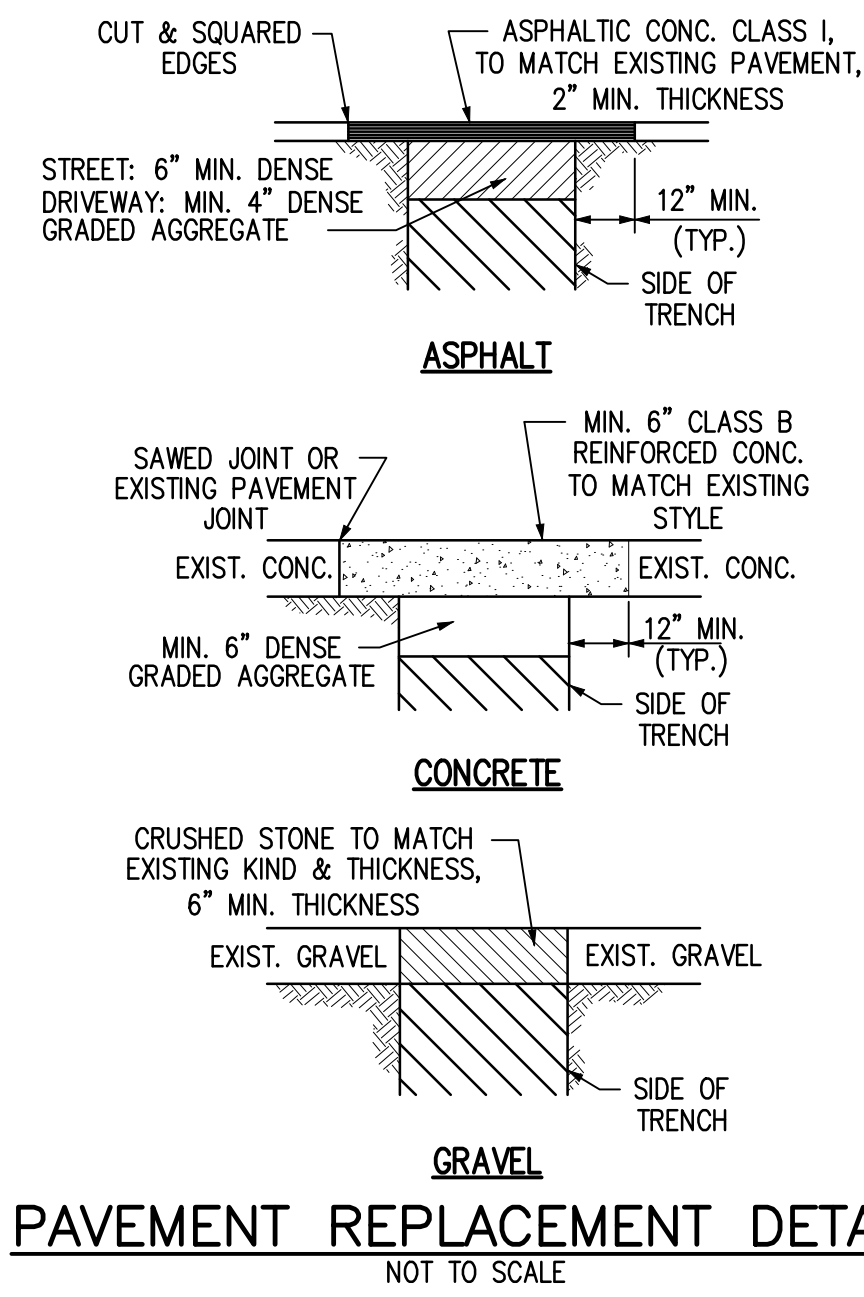

PAVEMENT REPLACEMENT DETAILS
NOT TO SCALE

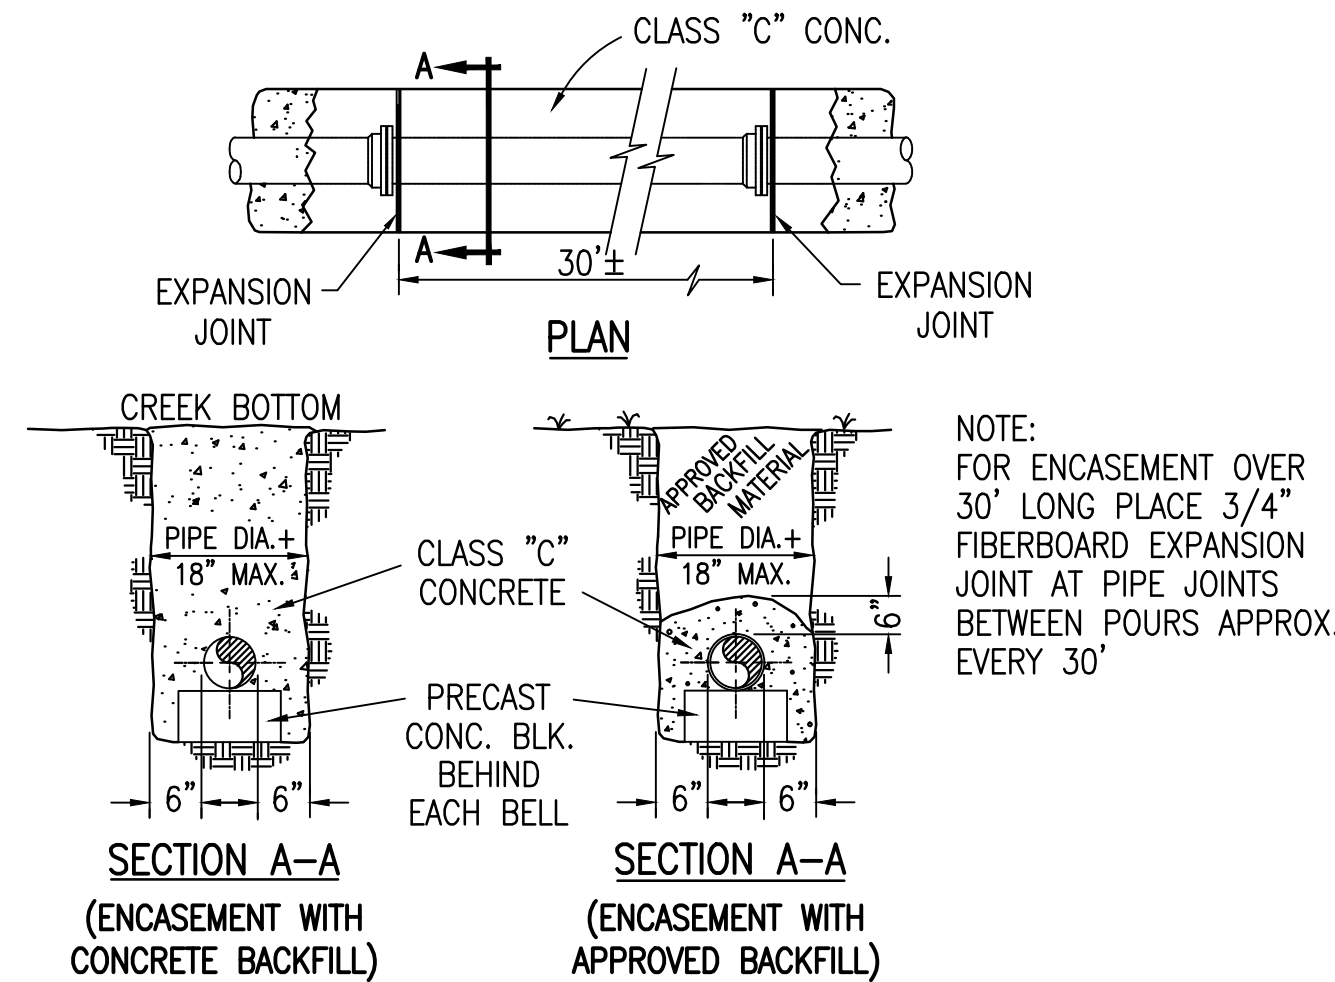

STANDARD CONCRETE ENCASEMENT
NOT TO SCALE

This document, originally issued, sealed, and signed by JAMES W. HILBORN, Tennessee Professional Engineer, No. 16514, on 4-08-2013, shall not be used in lieu of a certified document.

GRW PROJECT NO. 3927-03

CLIENT PROJECT NO. _____

ALL RIGHTS RESERVED. NO PART OF THIS DOCUMENT MAY BE REPRODUCED IN WHOLE OR IN PART WITHOUT THE WRITTEN PERMISSION OF GRW ENGINEERS, S.C. AND SHALL NOT BE USED FOR ANY OTHER PROJECT WITHOUT THE WRITTEN PERMISSION OF GRW ENGINEERS, S.C.

GRW
ENGINEERS - ARCHITECTS - PLANNERS

www.grwinc.com

STANDARD WATER LINE DETAILS

WATER LINE INTERCONNECTION
CITY OF LOBELVILLE, TENNESSEE

REVISIONS	NO.	DESCRIPTION	DATE	BY	DESIGNED	DRAWN	REVIEWED	APPROVED
					JWH	SG	JWH	JWH

DATE: OCTOBER 2010

SCALE: AS NOTED

SHEET NO.