

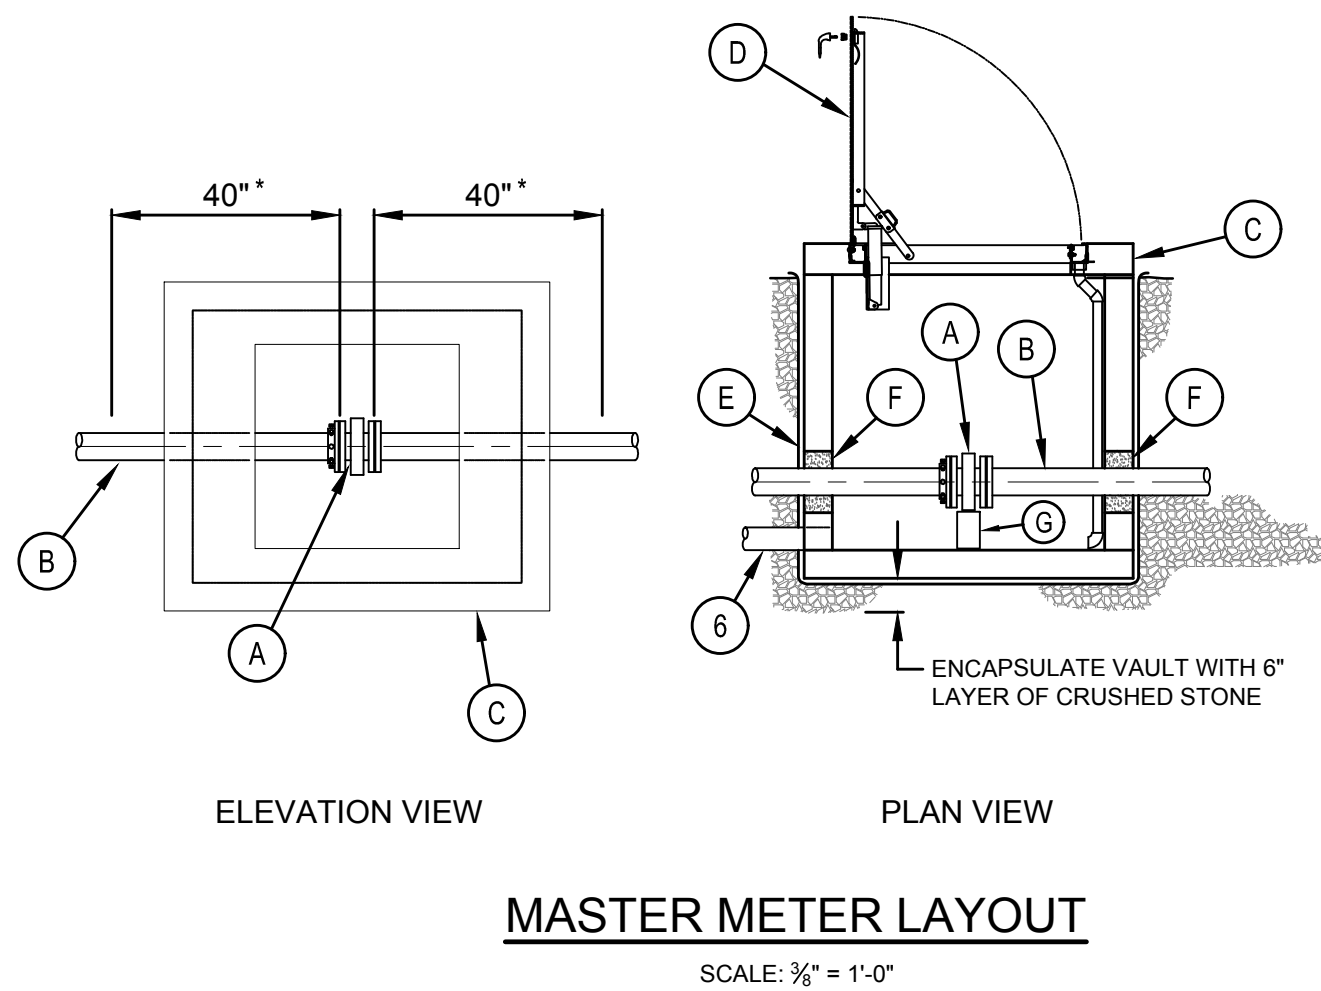
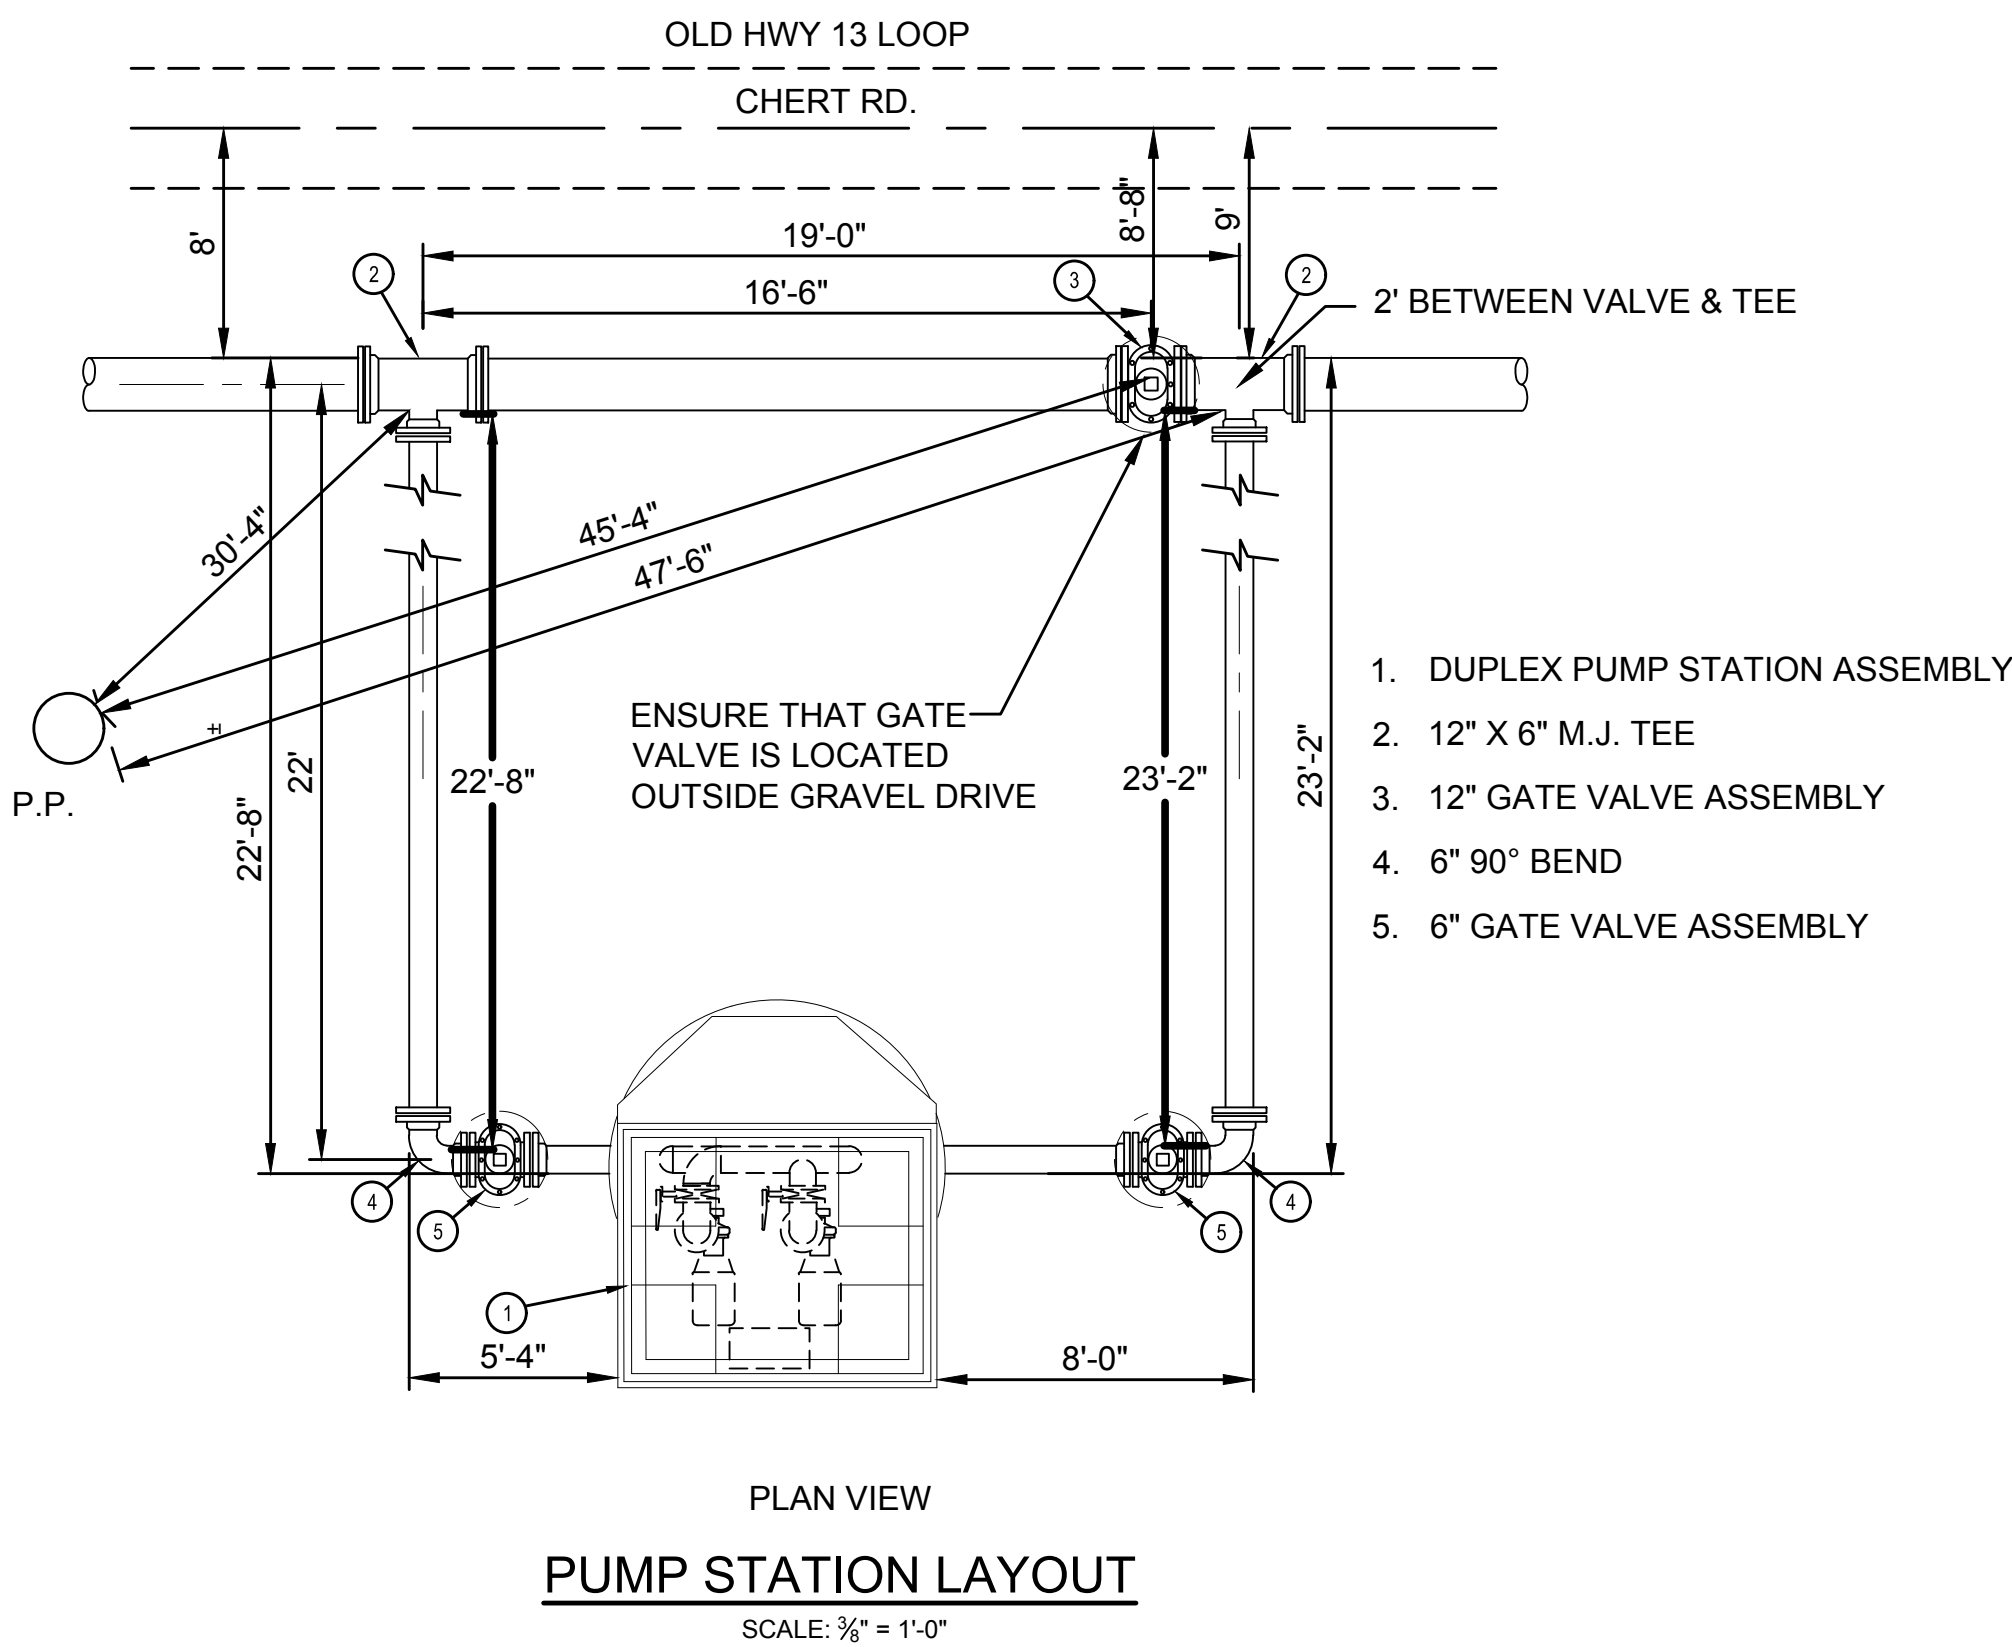
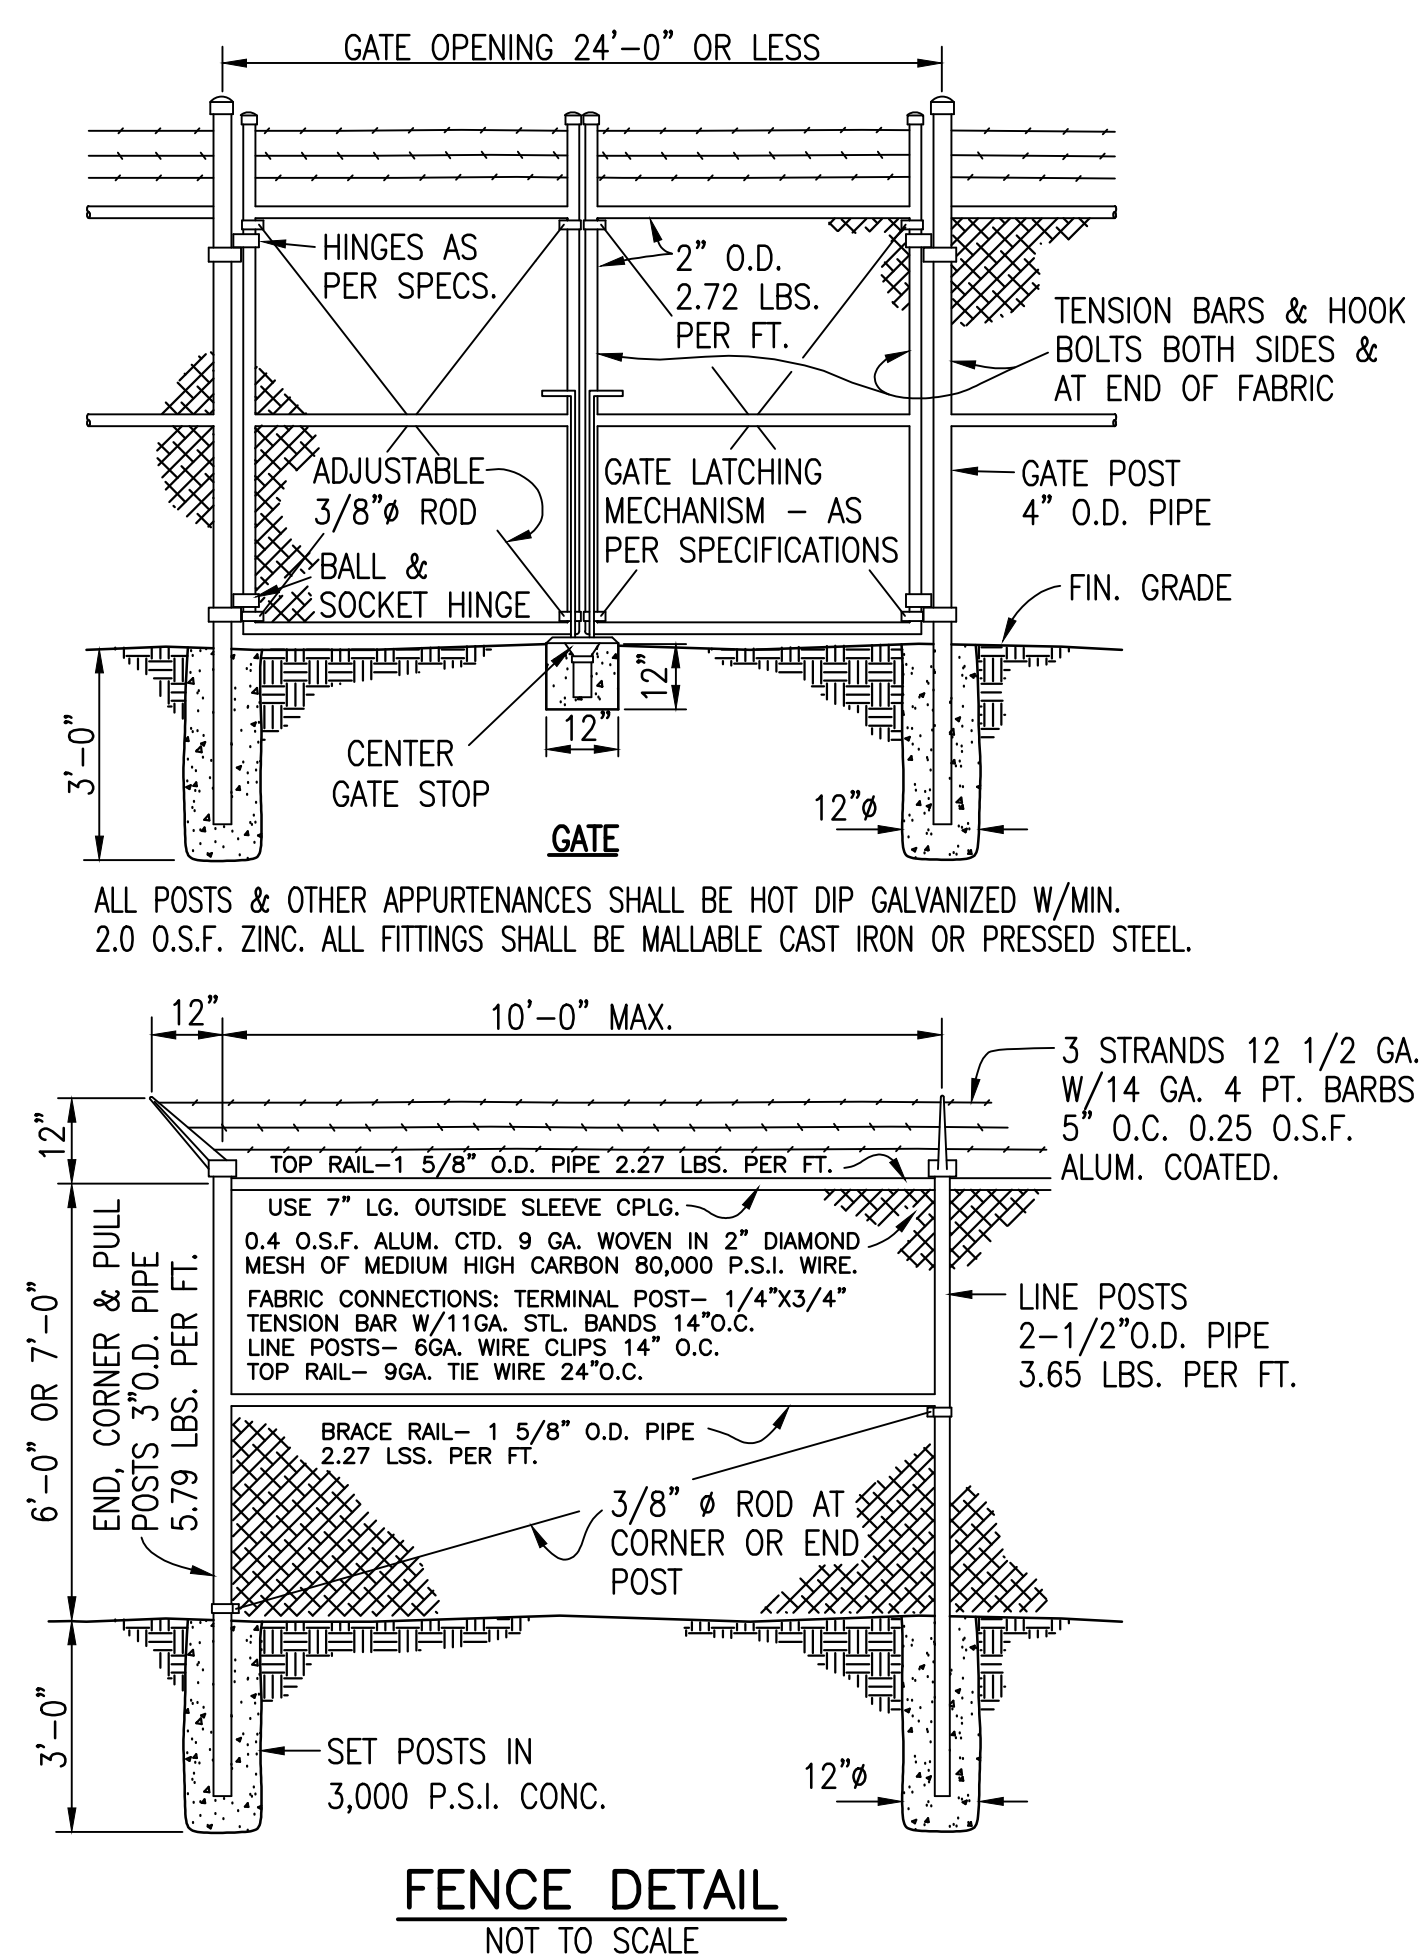
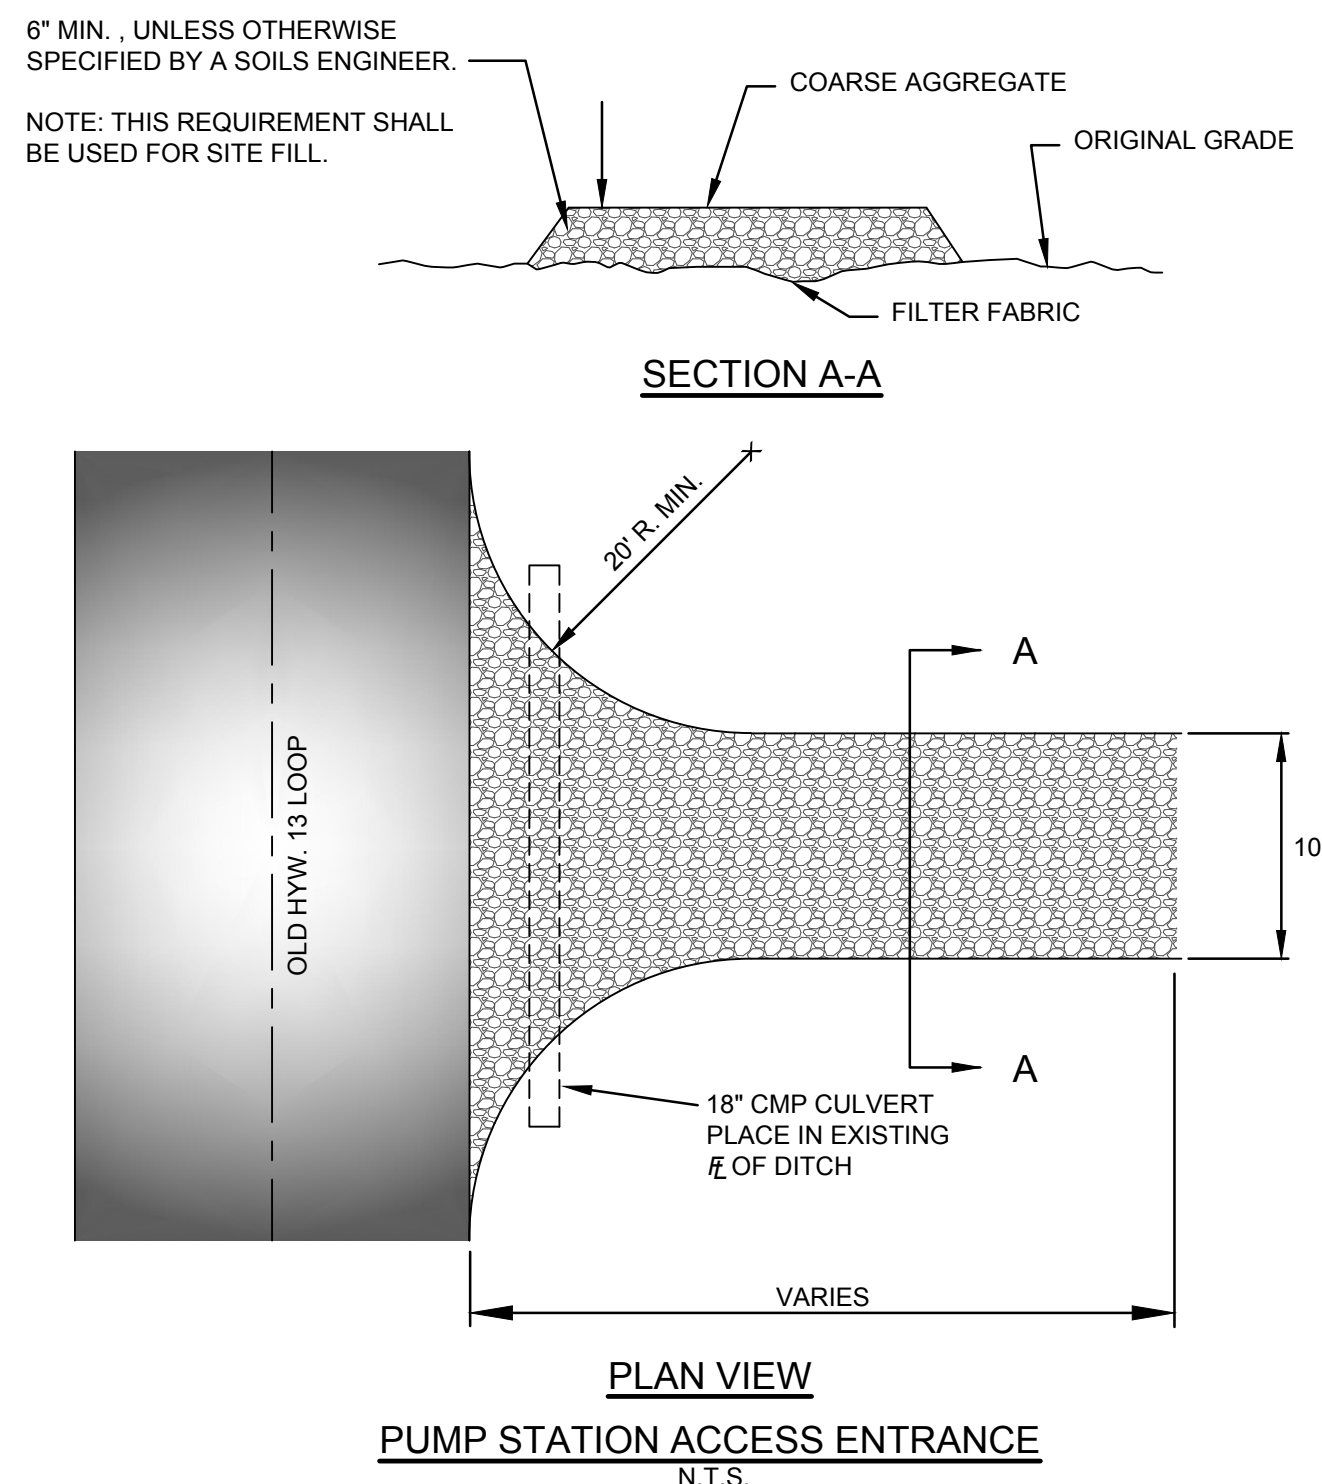
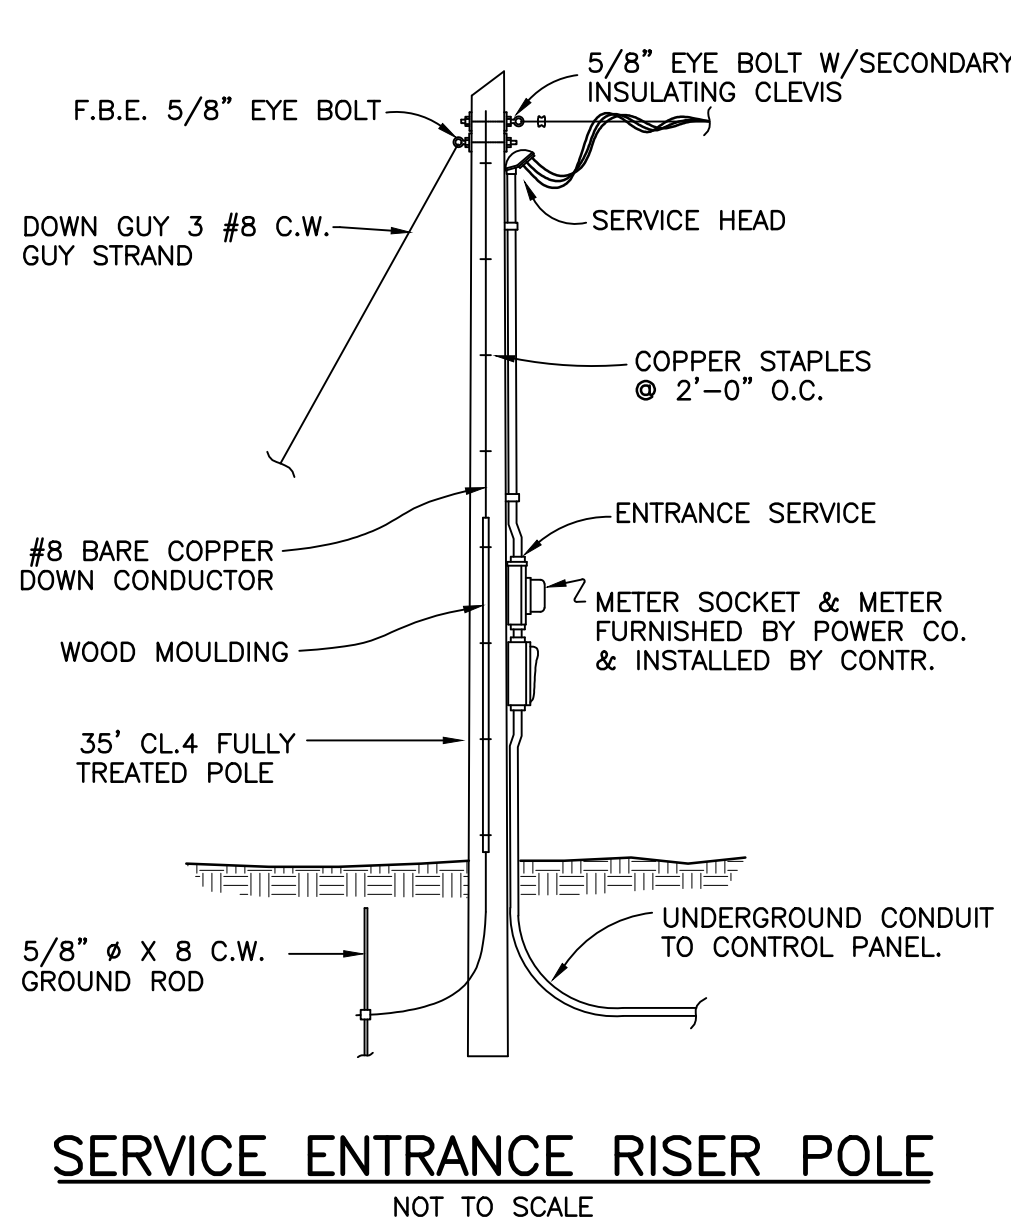


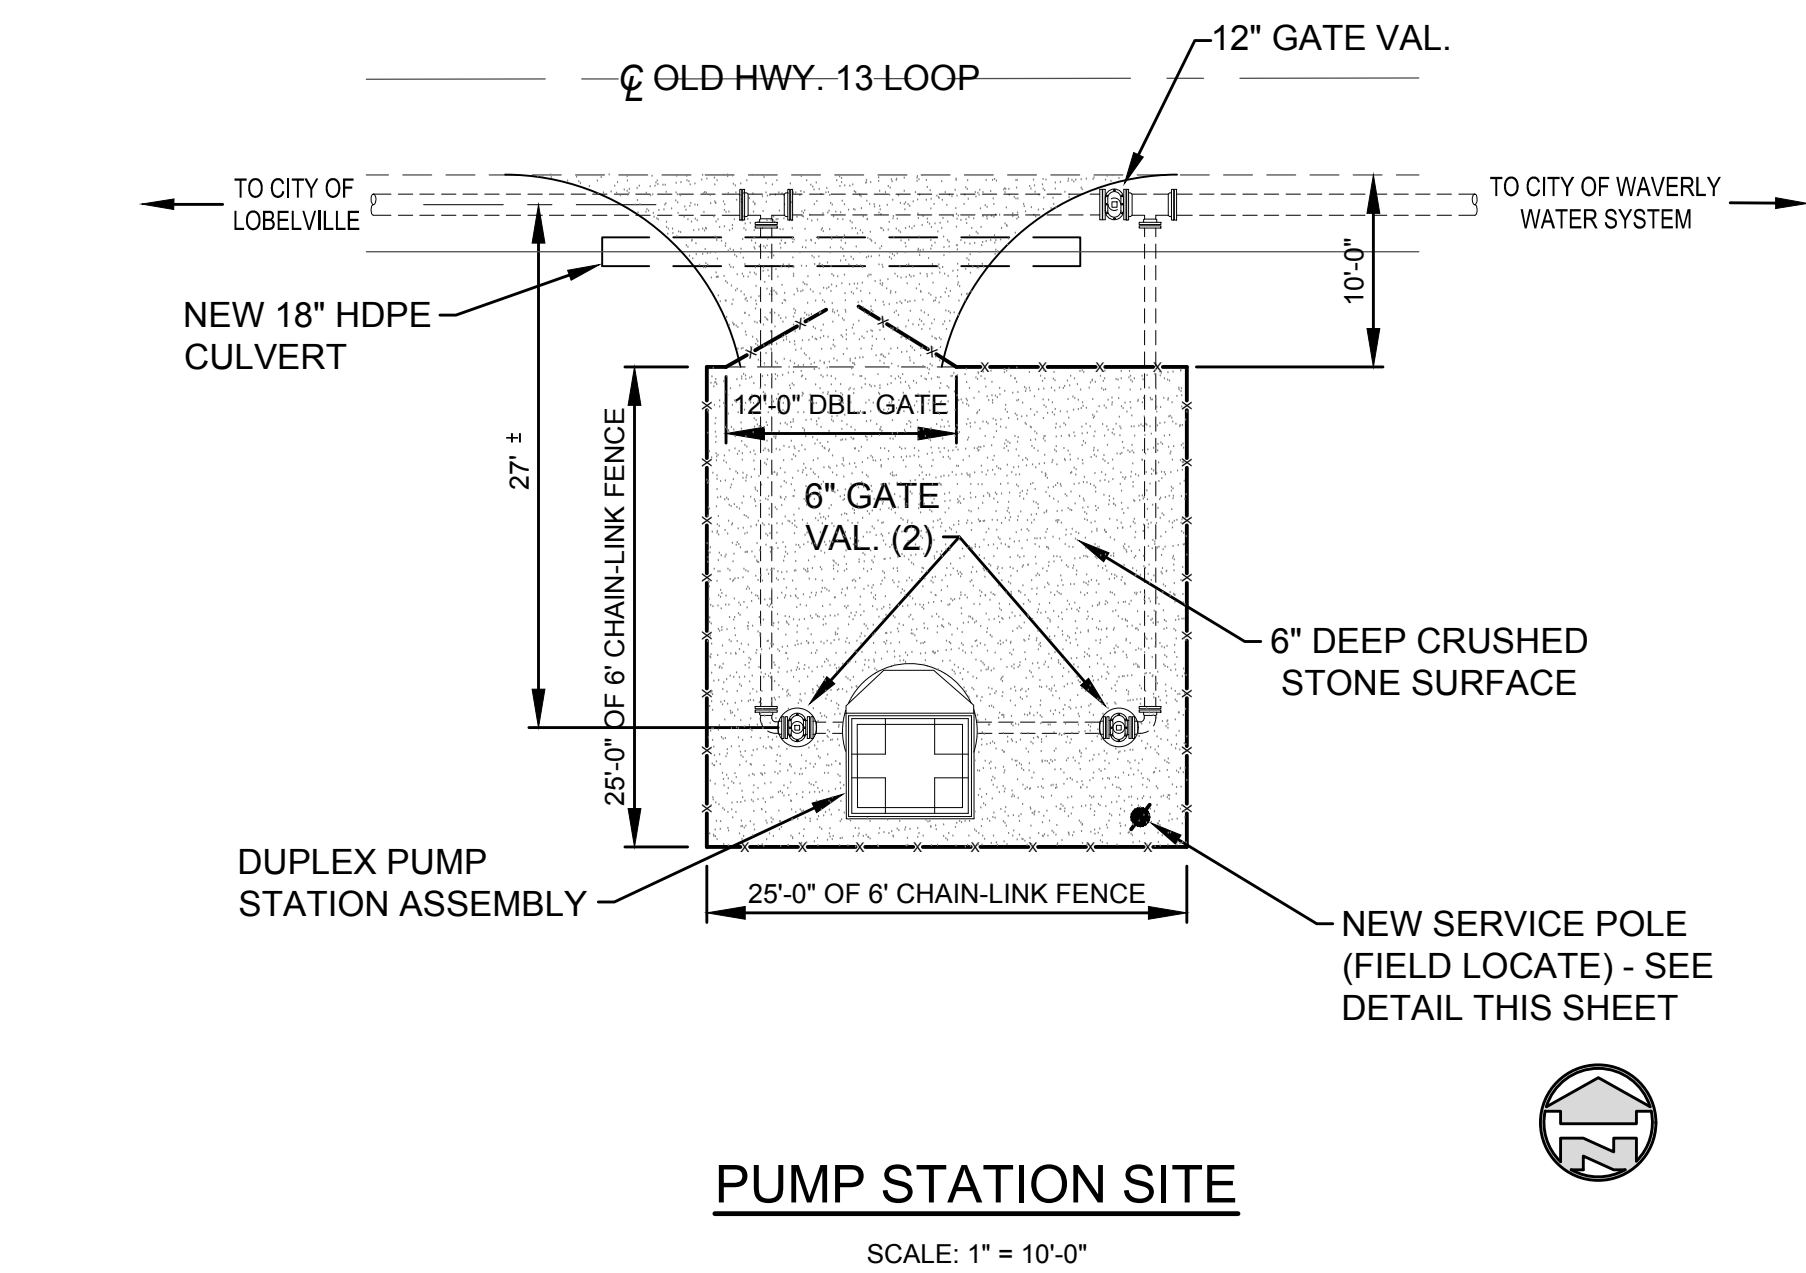

- MASTER METER**
- A. 4" MASTER METER w/UNI-FLANGE CONNECTOR
 - B. 4" PIPING
 - C. 5'-0" X 4'-0" CONCRETE VAULT
 - D. 36" X 36" SINGLE LEAF ALUM. HATCH
 - E. 4 MIL VAPOR BARRIER AROUND VAULT
 - F. SEAL OPENINGS WITH NON-SHRINK GROUT
 - G. CONCRETE BLOCK SUPPORT UNDER METER
- * 40" MINIMUM STRAIGHT UNOBSTRUCTED PIPING PER METER MANUFACTURER'S REQUIREMENTS
- CONSTRUCTION NOTES:**
1. ALL FITTINGS IN METER PIT SHALL BE FLANGE JOINT.
 2. SEAL OPENINGS WITH NON-SHRINK GROUT.
 3. MINIMUM 6" COMPACTED CRUSHED STONE ON FIRM SOIL OR ROCK.
 4. FILL AROUND STRUCTURES UP TO 6" FROM TOP AND SLOPE TO BLEND WITH FINISHED GRADE.

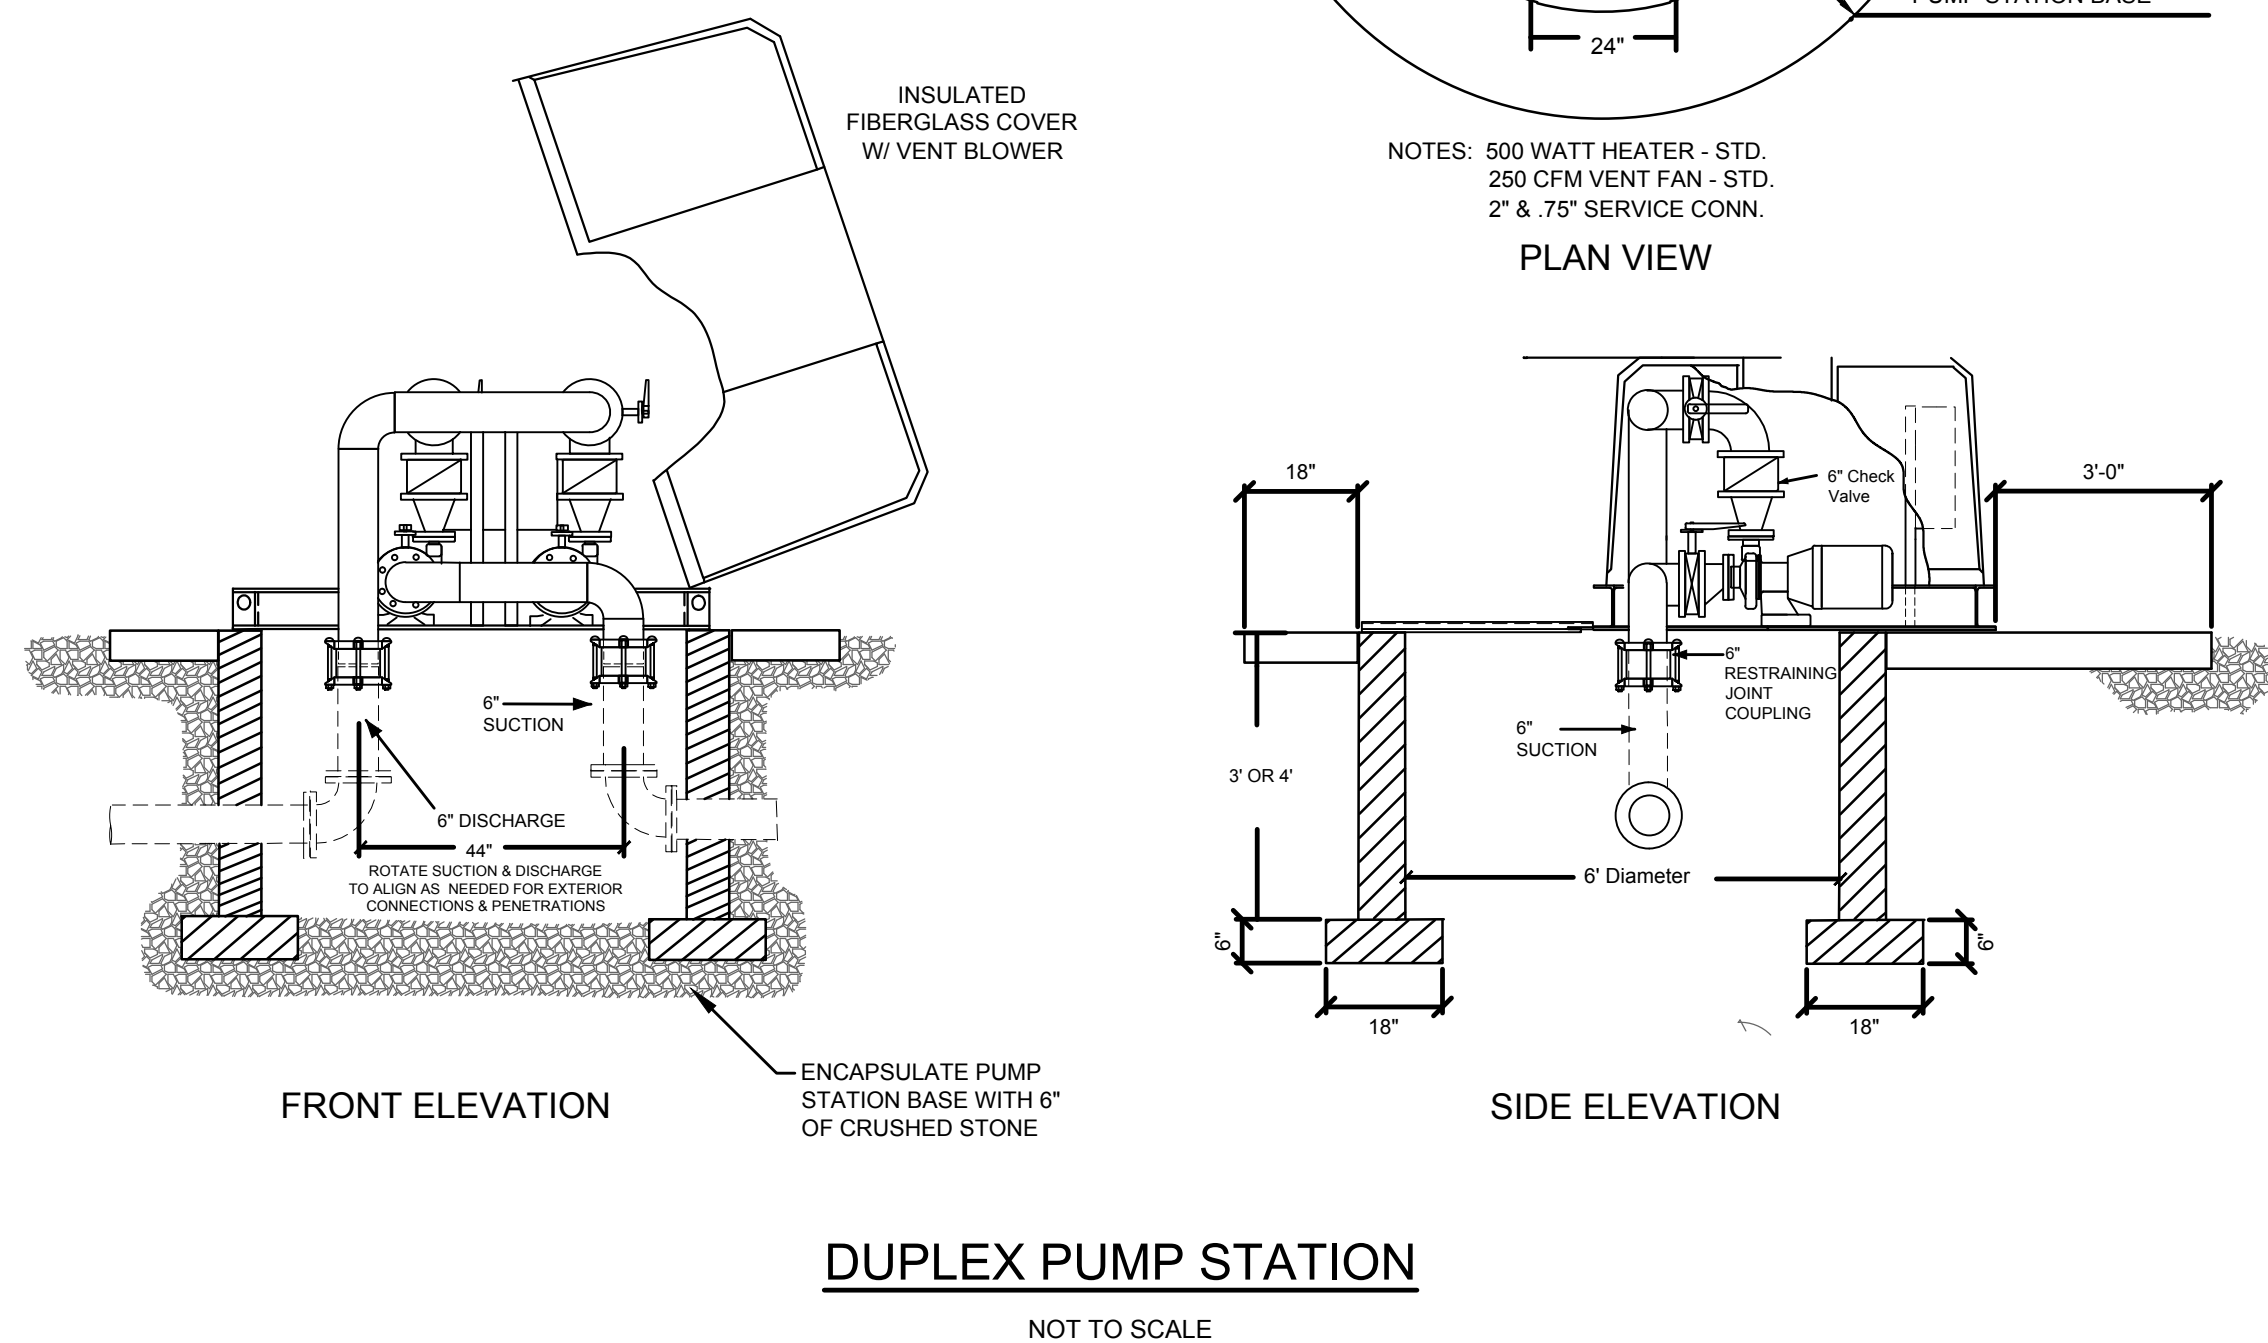

THIS RECORD DOCUMENT HAS BEEN PREPARED BASED ON INFORMATION PROVIDED BY THE CONSTRUCTION CONTRACTOR. GRW ENGINEERS, INC. HAS ATTEMPTED TO VERIFY THE ACCURACY AND/OR COMPLETENESS OF THIS INFORMATION BUT SHALL NOT BE RESPONSIBLE FOR ANY ERRORS OR OMISSIONS WHICH MAY BE INCORPORATED HEREIN AS A RESULT.

GRW
engineering | architecture | geospatial
www.grwinc.com

ENGINEER/ARCHITECT: GRW Engineers, Inc.
CONSTRUCTION COMPANY: Hughes Construction Co.
DATE: 11/6/2015

This document, originally issued, sealed, and signed by Barry L. Cloyd, Tennessee Professional Engineer, No. 100893, on JULY 2013, shall not be used in lieu of a certified document.

GRW PROJECT NO. 3827-06

ALL RIGHTS RESERVED. NO PART OF THIS DOCUMENT MAY BE REPRODUCED IN WHOLE OR IN PART WITHOUT WRITTEN PERMISSION.

ENGINEERS - ARCHITECTS - PLANNERS
www.grwinc.com

LOBELVILLE-WAVERLY PUMP STATION
PLAN, SECTIONS AND DETAILS
 2012-D DISASTER RECOVERY EMERGENCY
 WATER CONNECTION IMPROVEMENTS - CONTRACT 34821
 CITY OF LOBELVILLE, TENNESSEE

DESIGNED	BLC	BY	DATE	REVISIONS
DM	DM			
BLC	BLC			
BLC	BLC			

DATE: JULY 2013
 SCALE: AS NOTED
 SHEET NO. C-0-10