



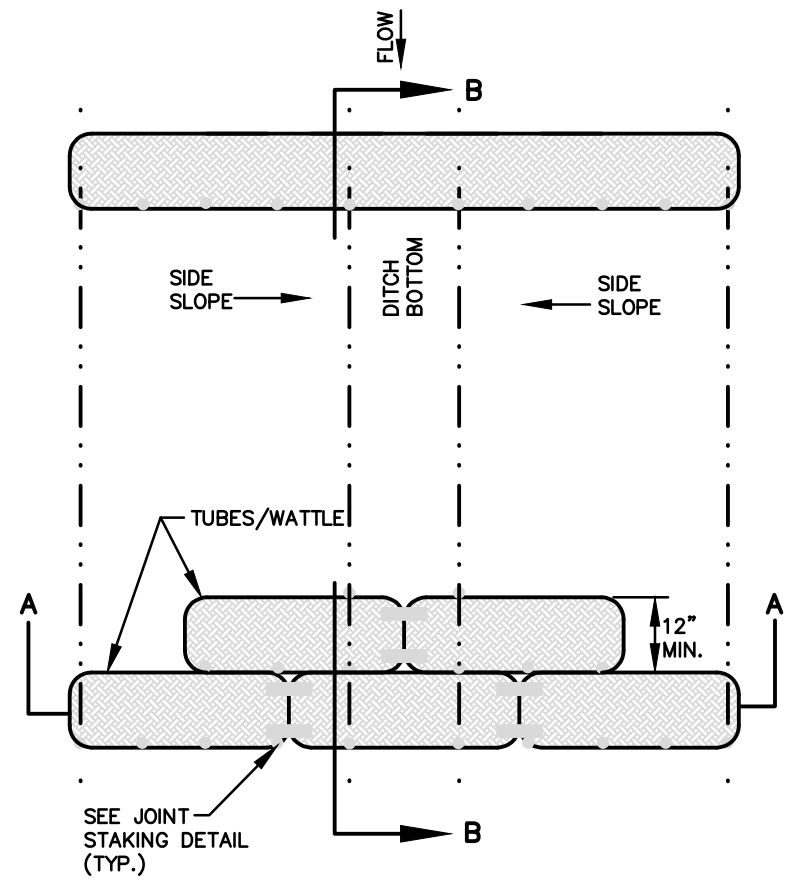


PLAN VIEW FOR DITCH APPLICATION

NOTES:

- THE DEPTH AND WIDTH OF THE WEIR SECTION OF THE WATTLE SHALL BE DESIGNED TO PASS THE 24"/24HR OR 54"/24HR STORM EVENT WITHOUT OVERTOPPING THE CHANNEL.
- STAKE PER MANUFACTURERS RECOMMENDATIONS

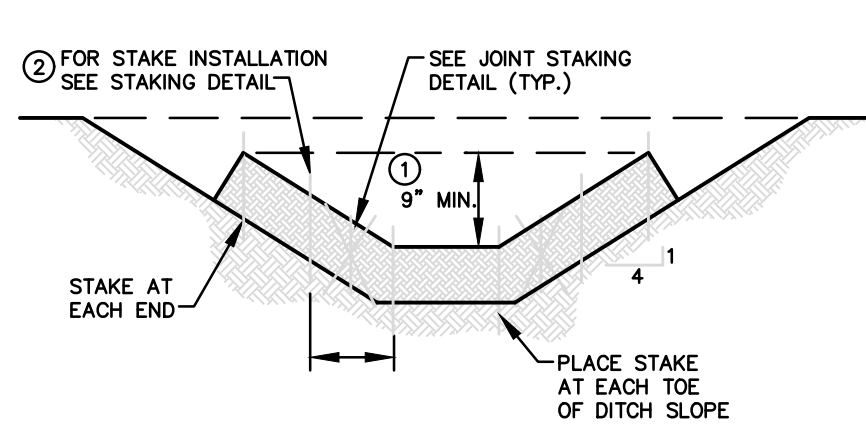

SECTION A-A

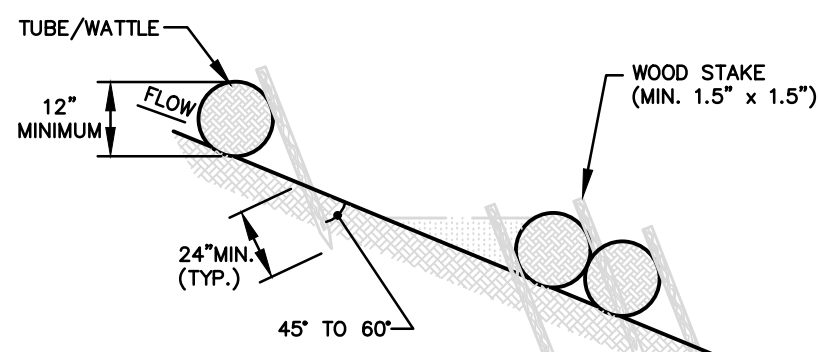


SECTION B-B


TUBES & WADDLES FOR DITCH APPLICATION

TENNESSEE EROSION AND SEDIMENT CONTROL HANDBOOK - CHAPTER 7.25

SCALE: NOT TO SCALE

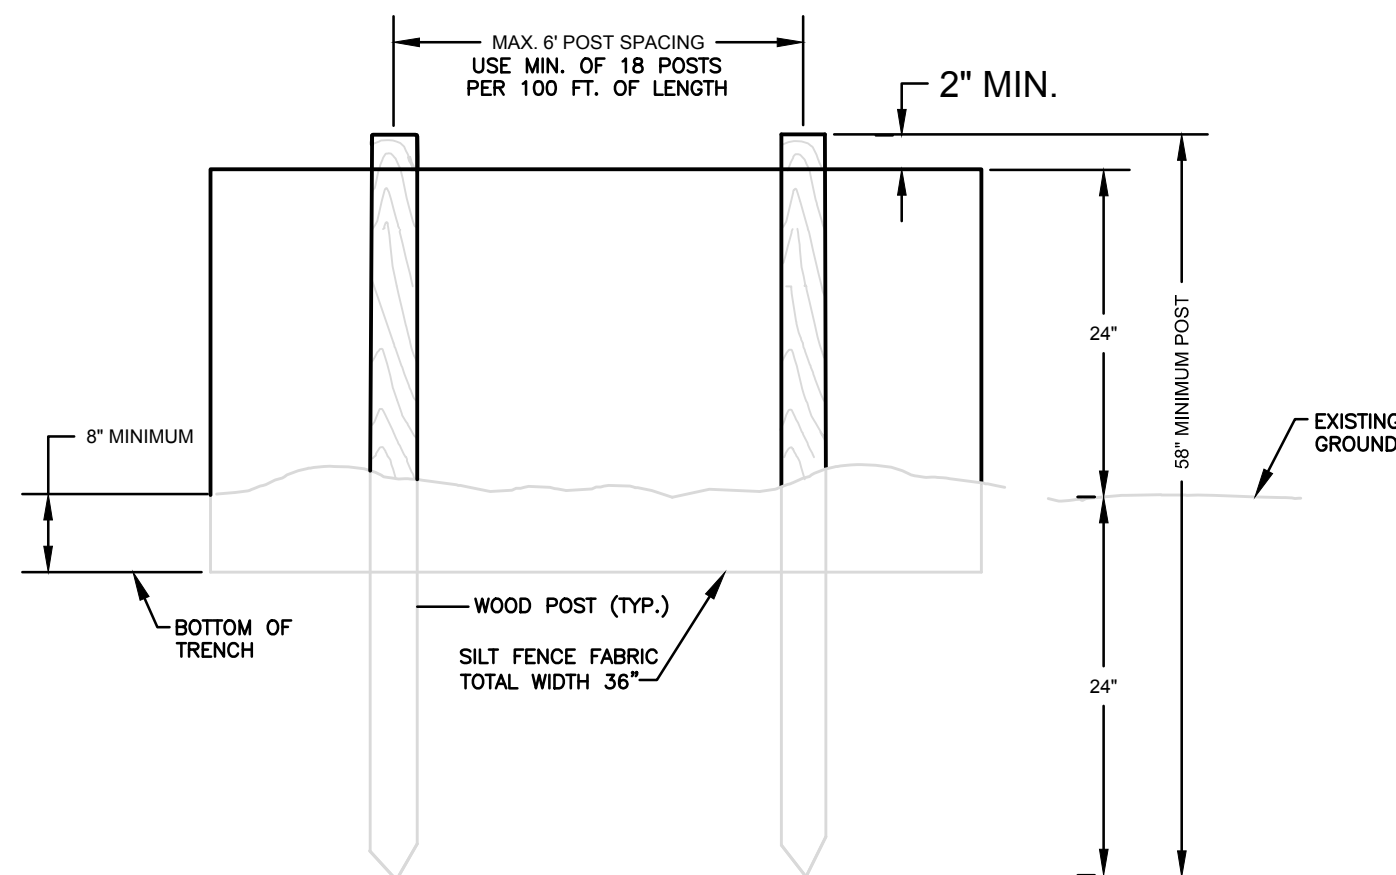

ELEVATION VIEW

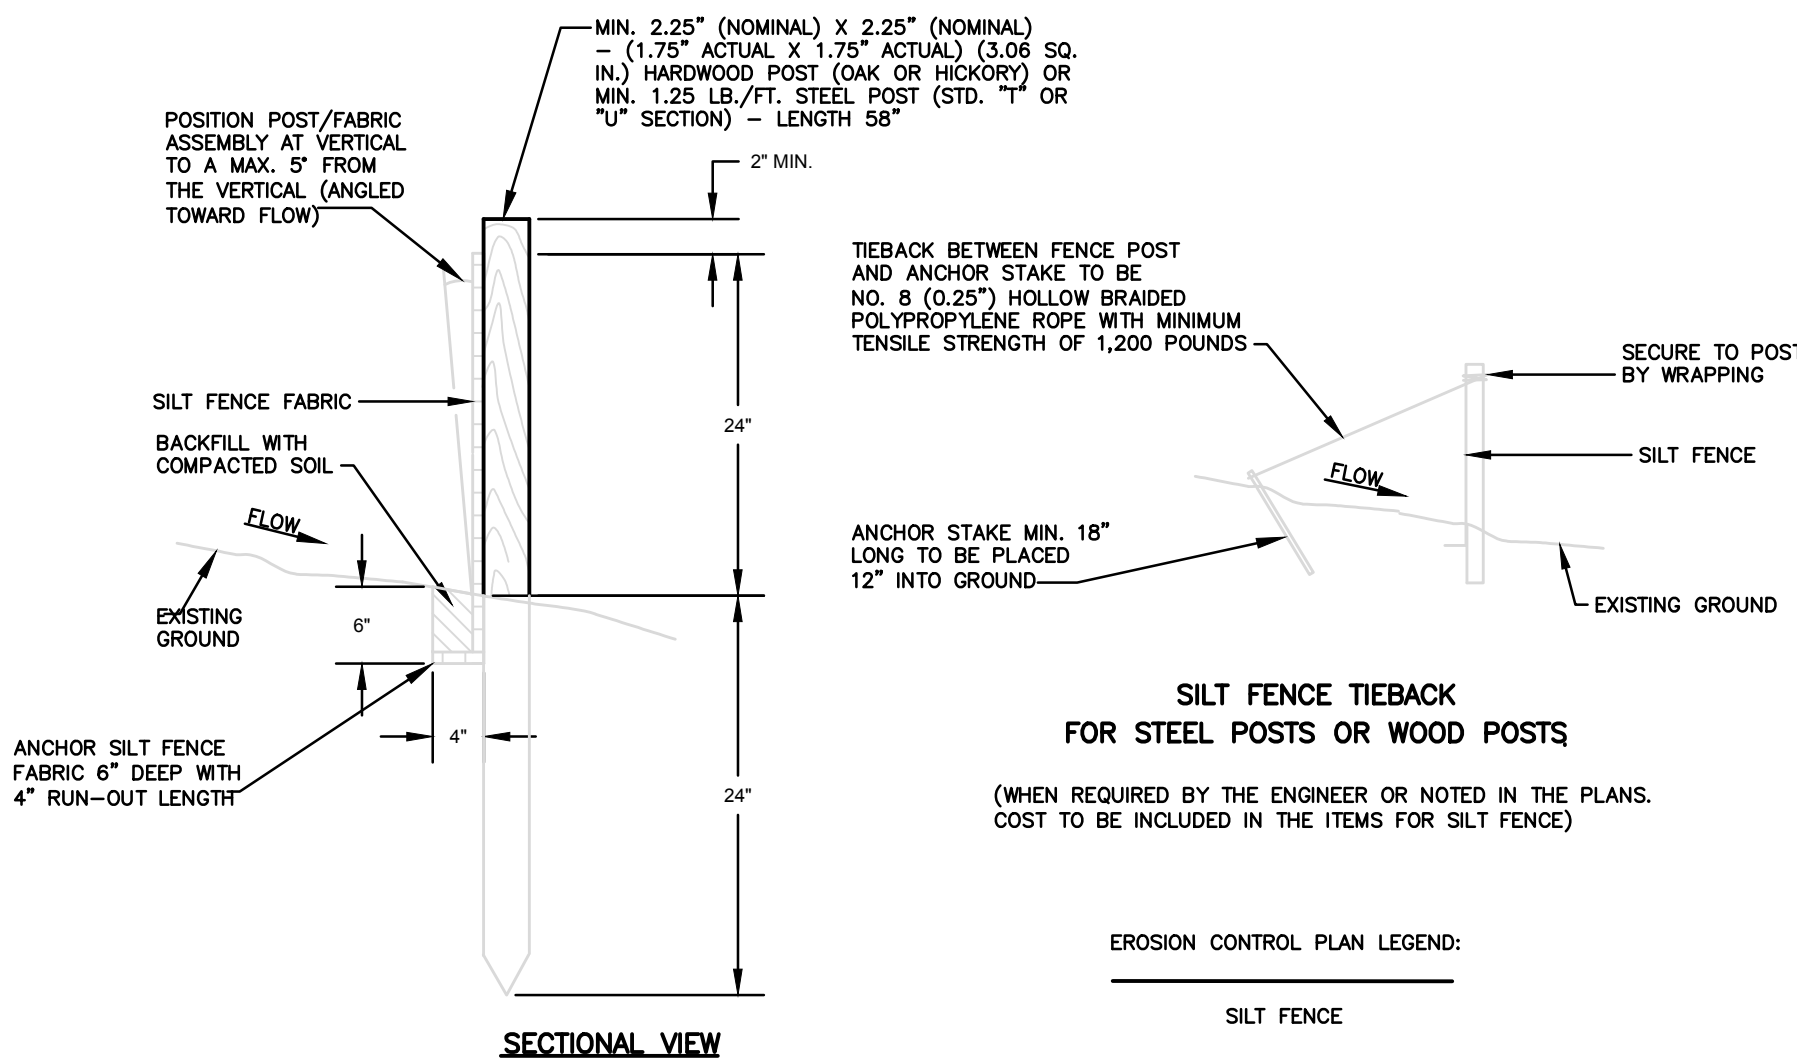


SECTIONAL VIEW


SILT FENCE

TENNESSEE EROSION AND SEDIMENT CONTROL HANDBOOK - CHAPTER 7.34

SCALE: NOT TO SCALE

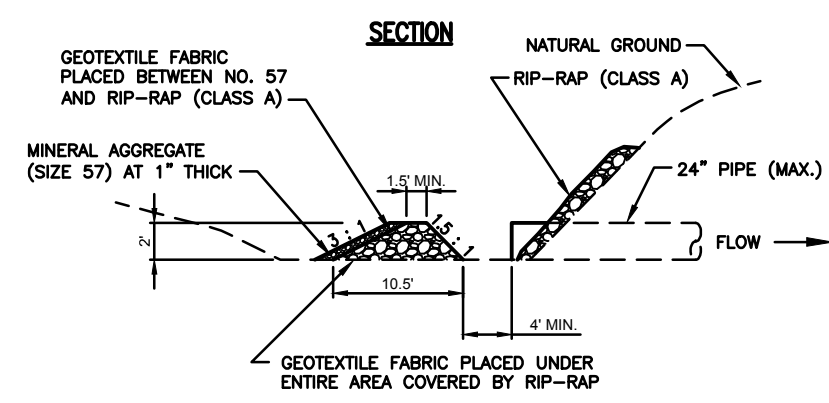

PERSPECTIVE VIEW

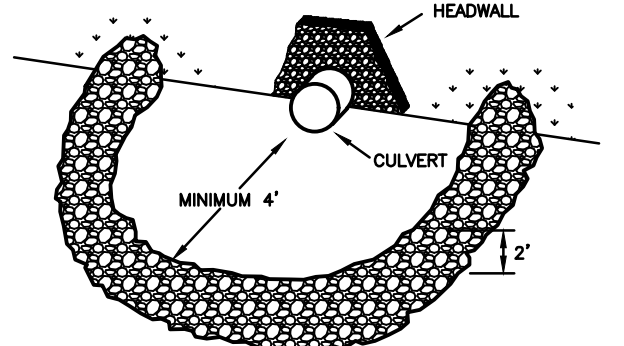


STONE FILTER RING

TENNESSEE EROSION AND SEDIMENT CONTROL HANDBOOK - CHAPTER 7.30


SCALE: NOT TO SCALE

PIPE DIAMETER (INCHES)	AVERAGE CHANNEL SLOPE					
	0.5%	1.0%	1.5%	2.0%	2.5%	3.0%
18	8.5	9.1	9.8	10.4	11.0	11.3
24	17.4	18.8	20.0	21.4	21.5	21.7
30	30.1	32.3	33.9	34.1	33.5	33.0
36	46.8	50.4	49.5	47.8	46.6	45.8
42	67.7	68.0	65.5	62.8	61.0	59.6
48	92.6	88.1	76.8	78.6	75.8	73.7
54	127.2	107.0	91.9	94.9	91.1	88.1
60	146.5	121.1	118.4	111.1	106.1	101.9
72	194.9	142.2	153.6	141.3	133.3	127.9
RIPRAP	B	B	B	B	B/C	B/C


EROSION CONTROL PLAN LEGEND:

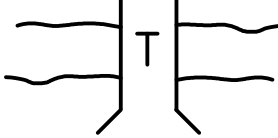

TEMPORARY STREAM CROSSING

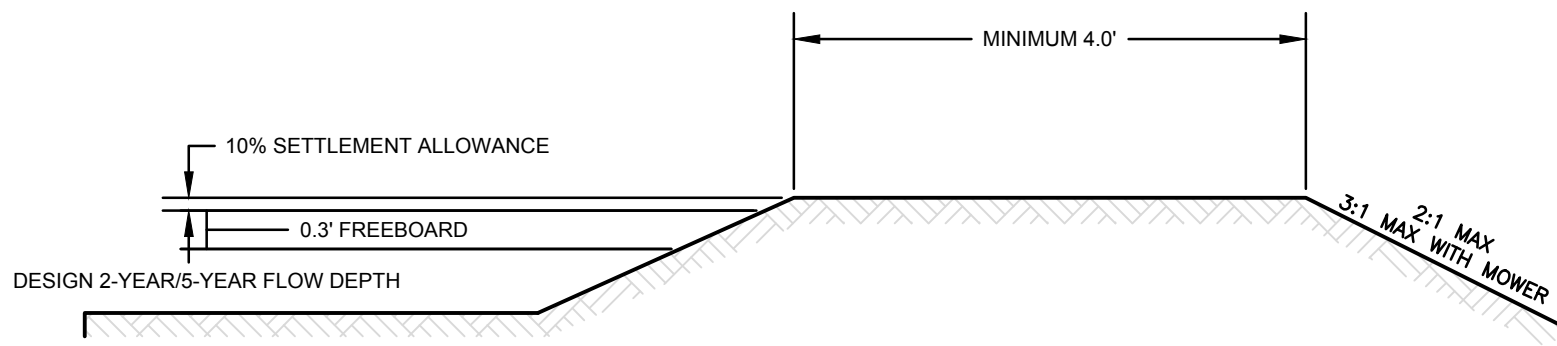

DIVERSION BERM

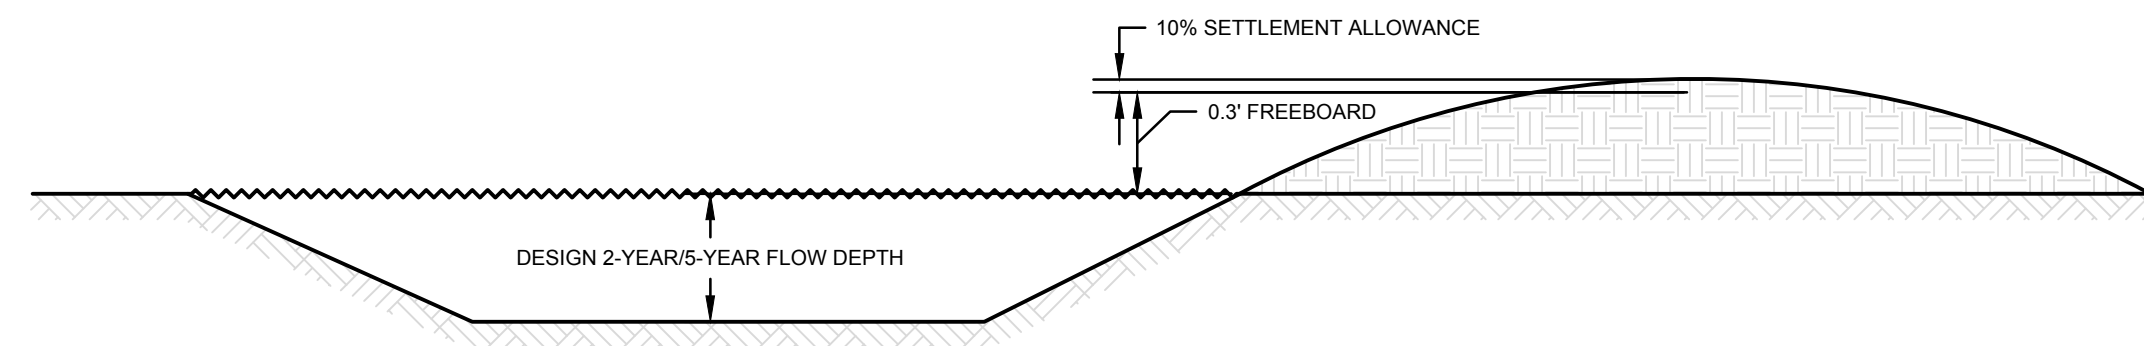


DIVERSION CHANNEL WITH BERM

DIVERSION


TENNESSEE EROSION AND SEDIMENT CONTROL HANDBOOK - CHAPTER 7.22

SCALE: NOT TO SCALE

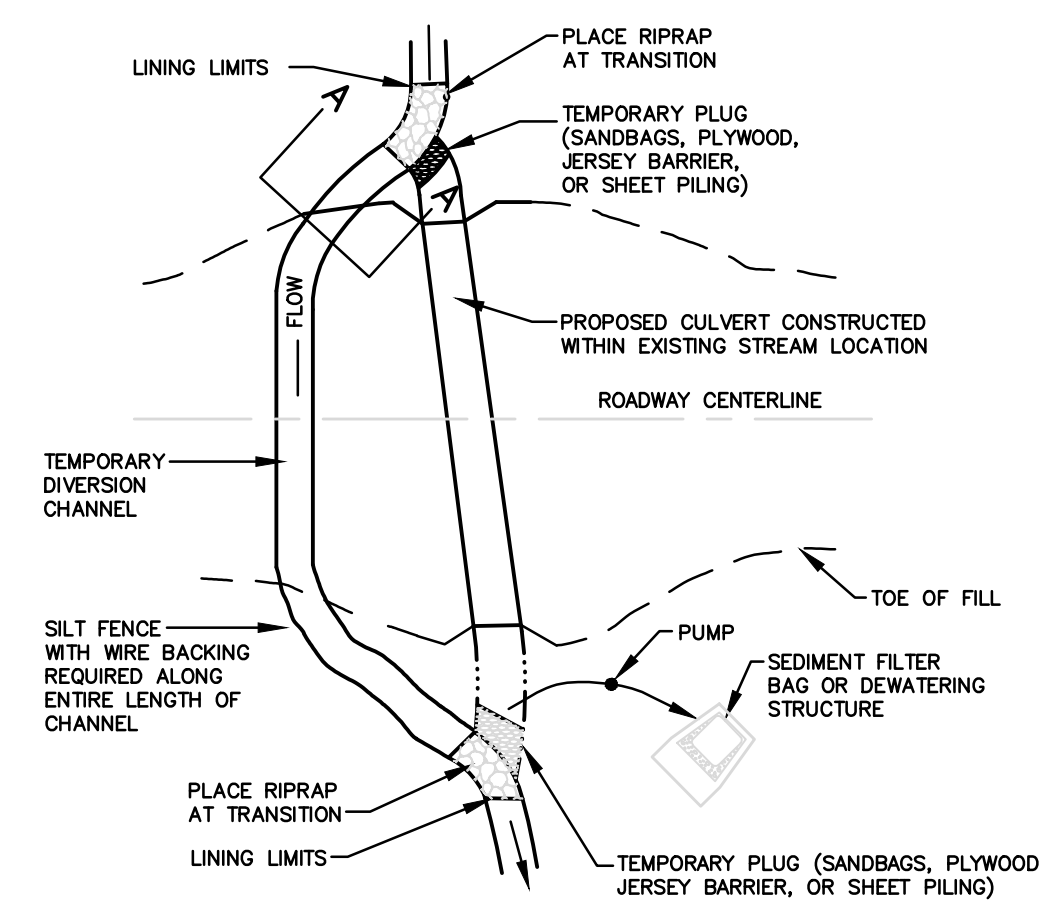

PLAN VIEW

CULVERT CONSTRUCTED WITHIN EXISTING STREAM

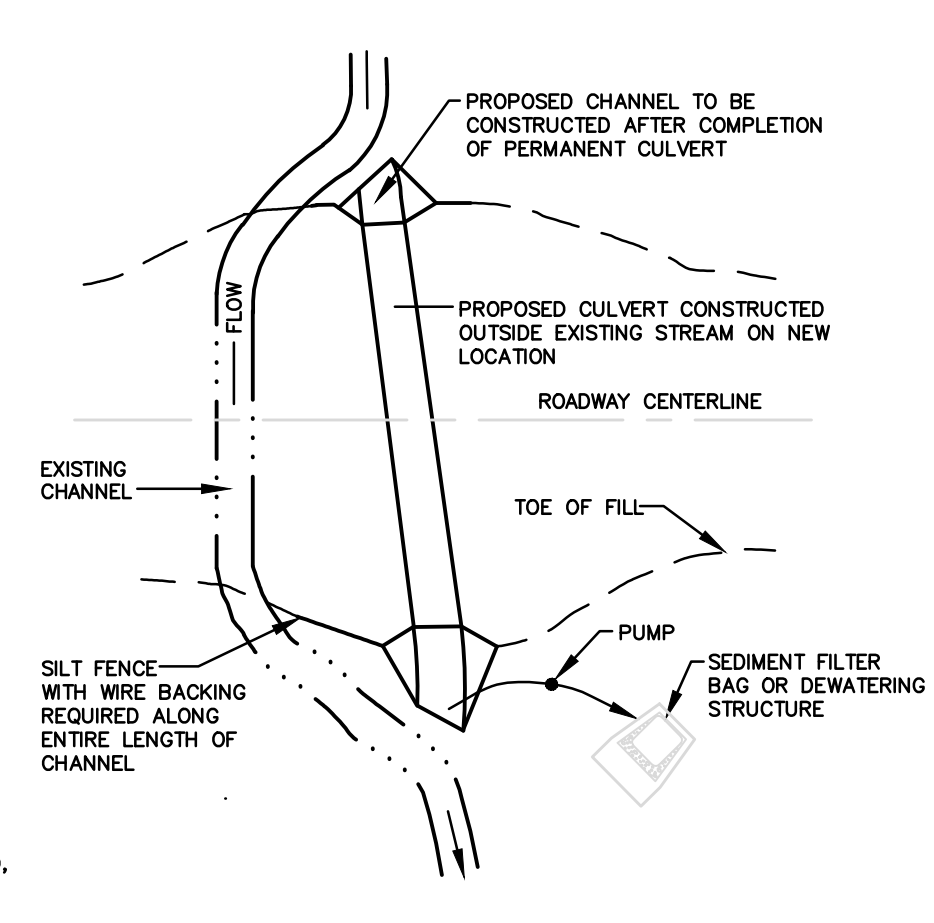


PLAN VIEW

CULVERT CONSTRUCTED OUTSIDE EXISTING STREAM


TEMPORARY STREAM DIVERSION

TENNESSEE EROSION AND SEDIMENT CONTROL HANDBOOK - CHAPTER 7.42

SCALE: NOT TO SCALE

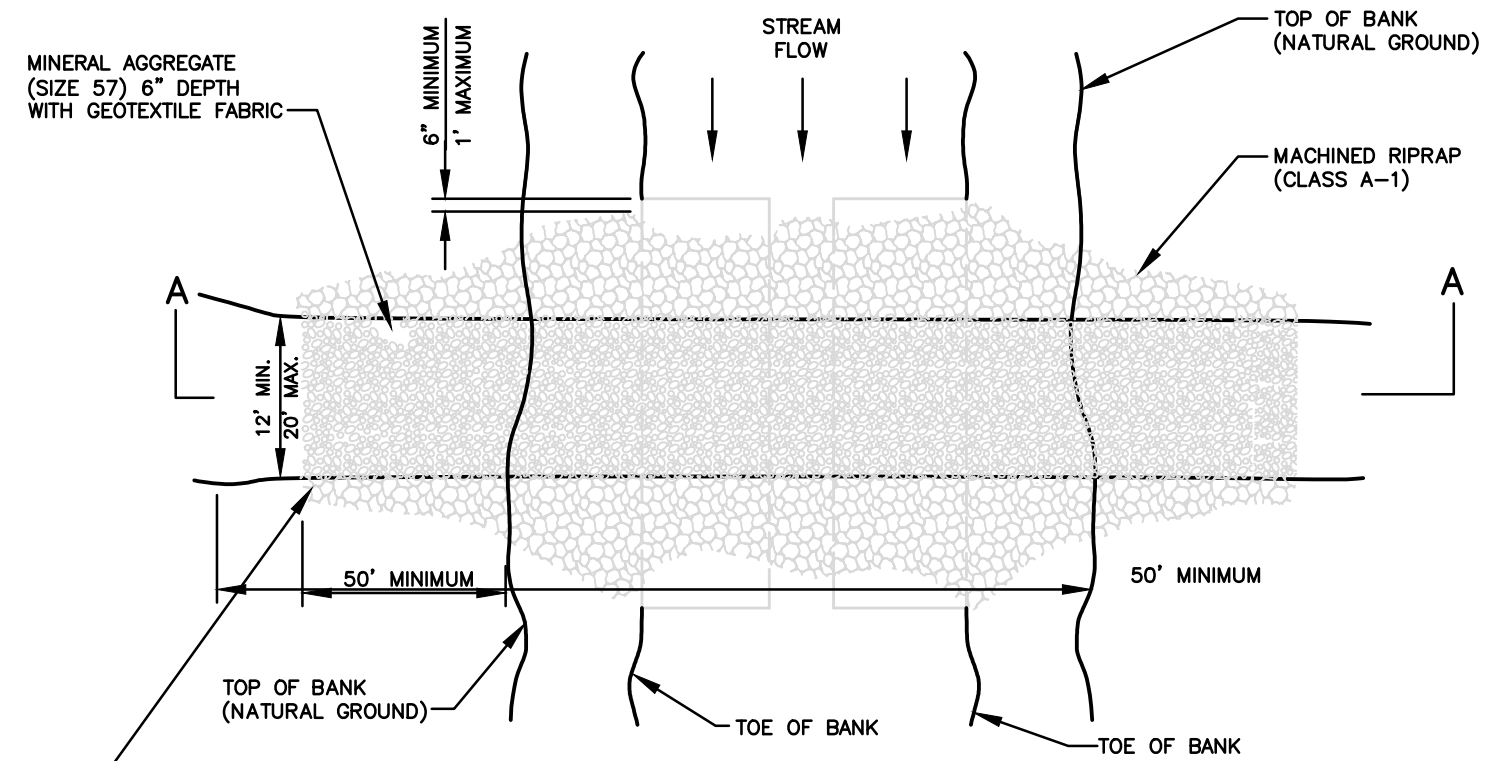

PLAN VIEW OF TEMPORARY CULVERT CROSSING

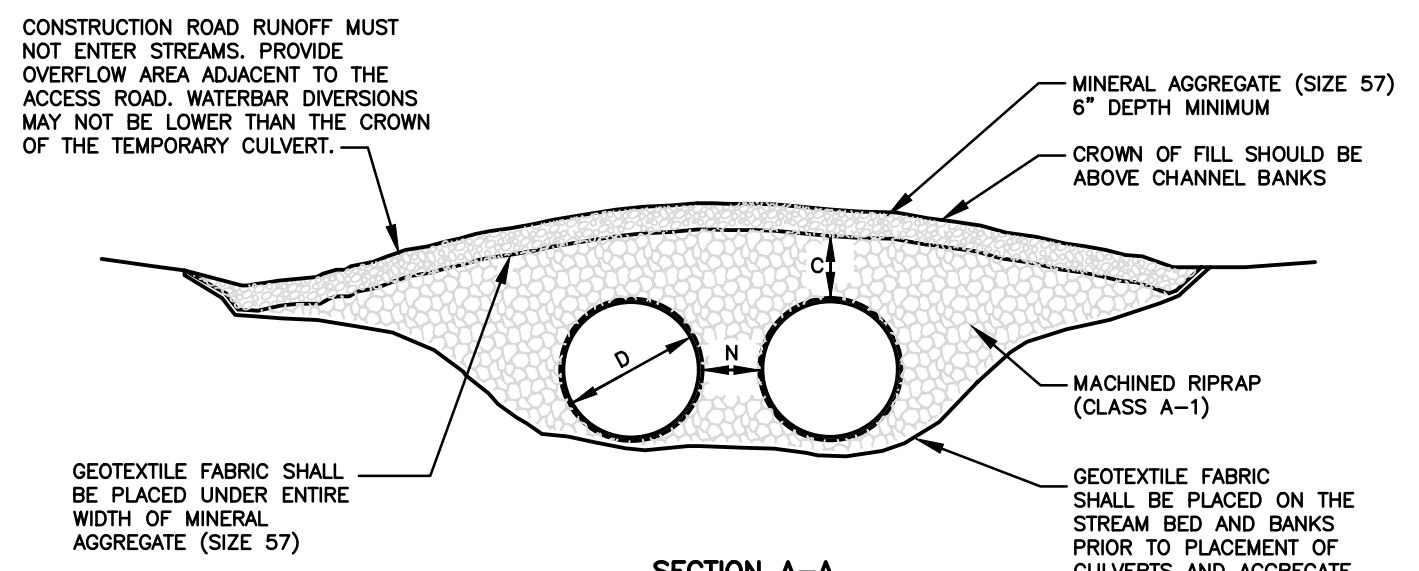


SECTION A-A

C = 1/2 DIAMETER OF PIPE OR 18" WHICHEVER IS GREATER
N = 1/2 DIAMETER OF PIPE OR 12" WHICHEVER IS GREATER
D = PIPE DIAMETER


TEMPORARY STREAM CROSSING

TENNESSEE EROSION AND SEDIMENT CONTROL HANDBOOK - CHAPTER 7.43

SCALE: NOT TO SCALE

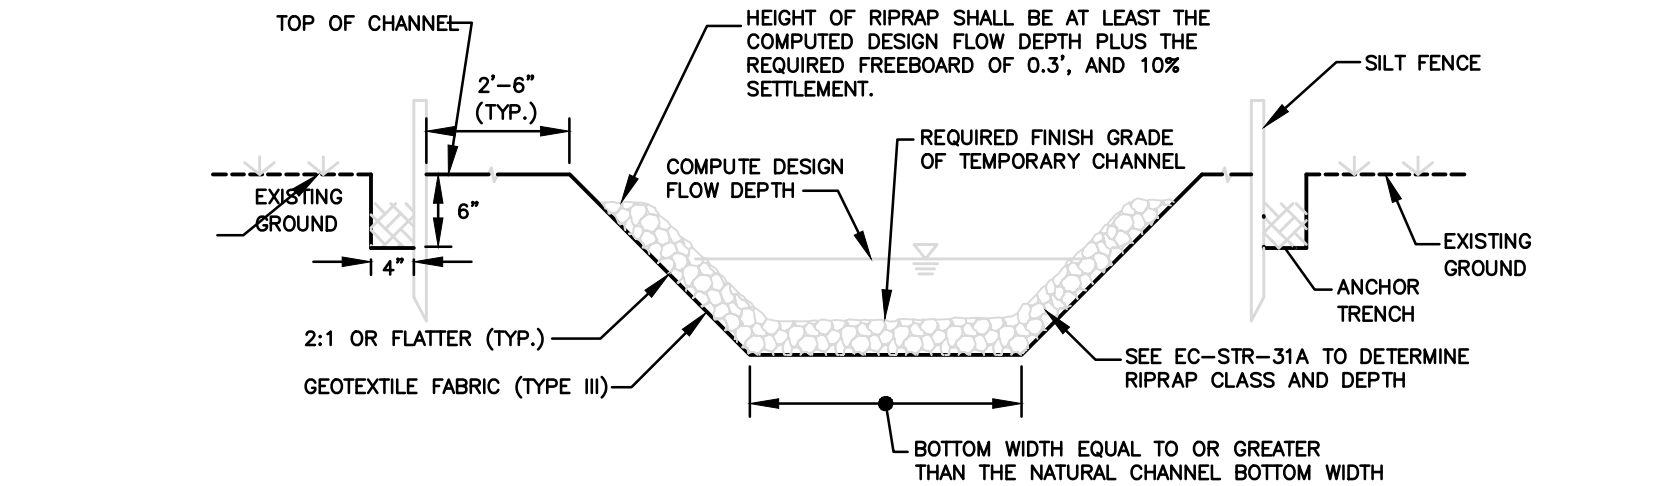

SECTION A-A

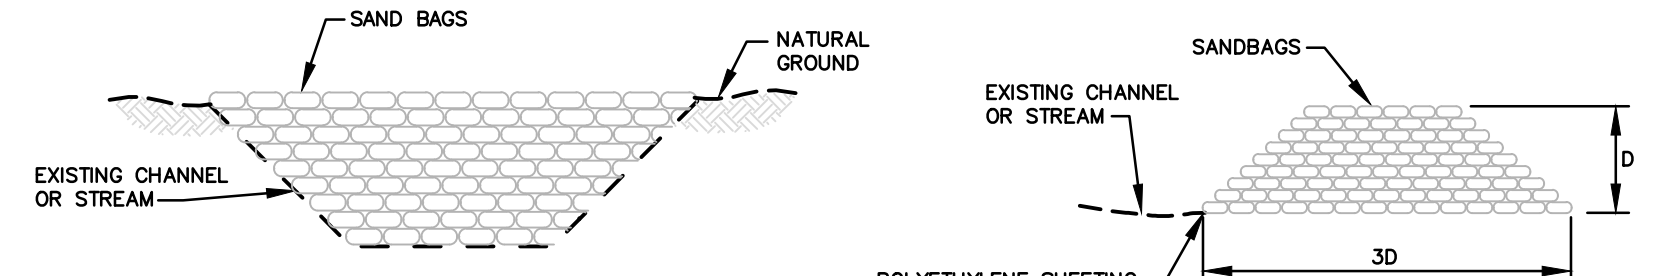


ELEVATION VIEW

CROSS SECTION VIEW

PLUG DETAIL

EROSION CONTROL PLAN LEGEND:

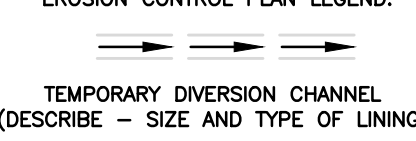

TEMPORARY DIVERSION CHANNEL (DESCRIBE - SIZE AND TYPE OF LINING)

THIS RECORD DOCUMENT HAS BEEN PREPARED BASED ON INFORMATION PROVIDED BY THE CONSTRUCTION CONTRACTOR. GRW ENGINEERS, INC. HAS ATTEMPTED TO VERIFY THE ACCURACY AND/OR COMPLETENESS OF THIS INFORMATION BUT SHALL NOT BE RESPONSIBLE FOR ANY ERRORS OR OMISSIONS WHICH MAY BE INCORPORATED HEREIN AS A RESULT.

GRW
engineering | architecture | geospatial
www.grwinc.com
ENGINEER/ARCHITECT: GRW Engineers, Inc.
CONSTRUCTION COMPANY: Hughes Construction Co.
DATE: 11/6/2015

This document, originally issued, sealed, and signed by Barry L. Cloyd, Tennessee Professional Engineer, No. 100893, on JULY 2013, shall not be used in lieu of a certified document.

GRW PROJECT NO. 3827-06



ENGINEERS - ARCHITECTS - PLANNERS
www.grwinc.com

STANDARD EROSION CONTROL DETAILS

2012-D DISASTER RECOVERY EMERGENCY
WATER CONNECTION IMPROVEMENTS - CONTRACT 34821
CITY OF LOBELVILLE, TENNESSEE

NO.	REVISIONS	DESCRIPTION	DATE	BY	DESIGNED	BLC	DRAWN	DM	REVIEWED	BLC	APPROVED	BLC

DATE: JULY 2013
SCALE: AS NOTED
SHEET NO.

C-0-13