


PROJECT AREA MAP
SCALE: 1" = 5000'

811
CALL BEFORE YOU DIG
IT IS THE CONTRACTOR'S RESPONSIBILITY TO CONTACT UTILITY COMPANIES PRIOR TO ANY CONSTRUCTION. THE LOCATION OF UTILITIES SHOWN ON THESE PLANS ARE APPROXIMATE AND POSSIBLY INCOMPLETE. THEREFORE CERTIFICATION TO THE LOCATION OF ALL UNDERGROUND UTILITIES IS WITHHELD.
IN TENNESSEE DIAL 811
OR 1-800-351-1111
THREE WORKING DAYS BEFORE YOU DIG

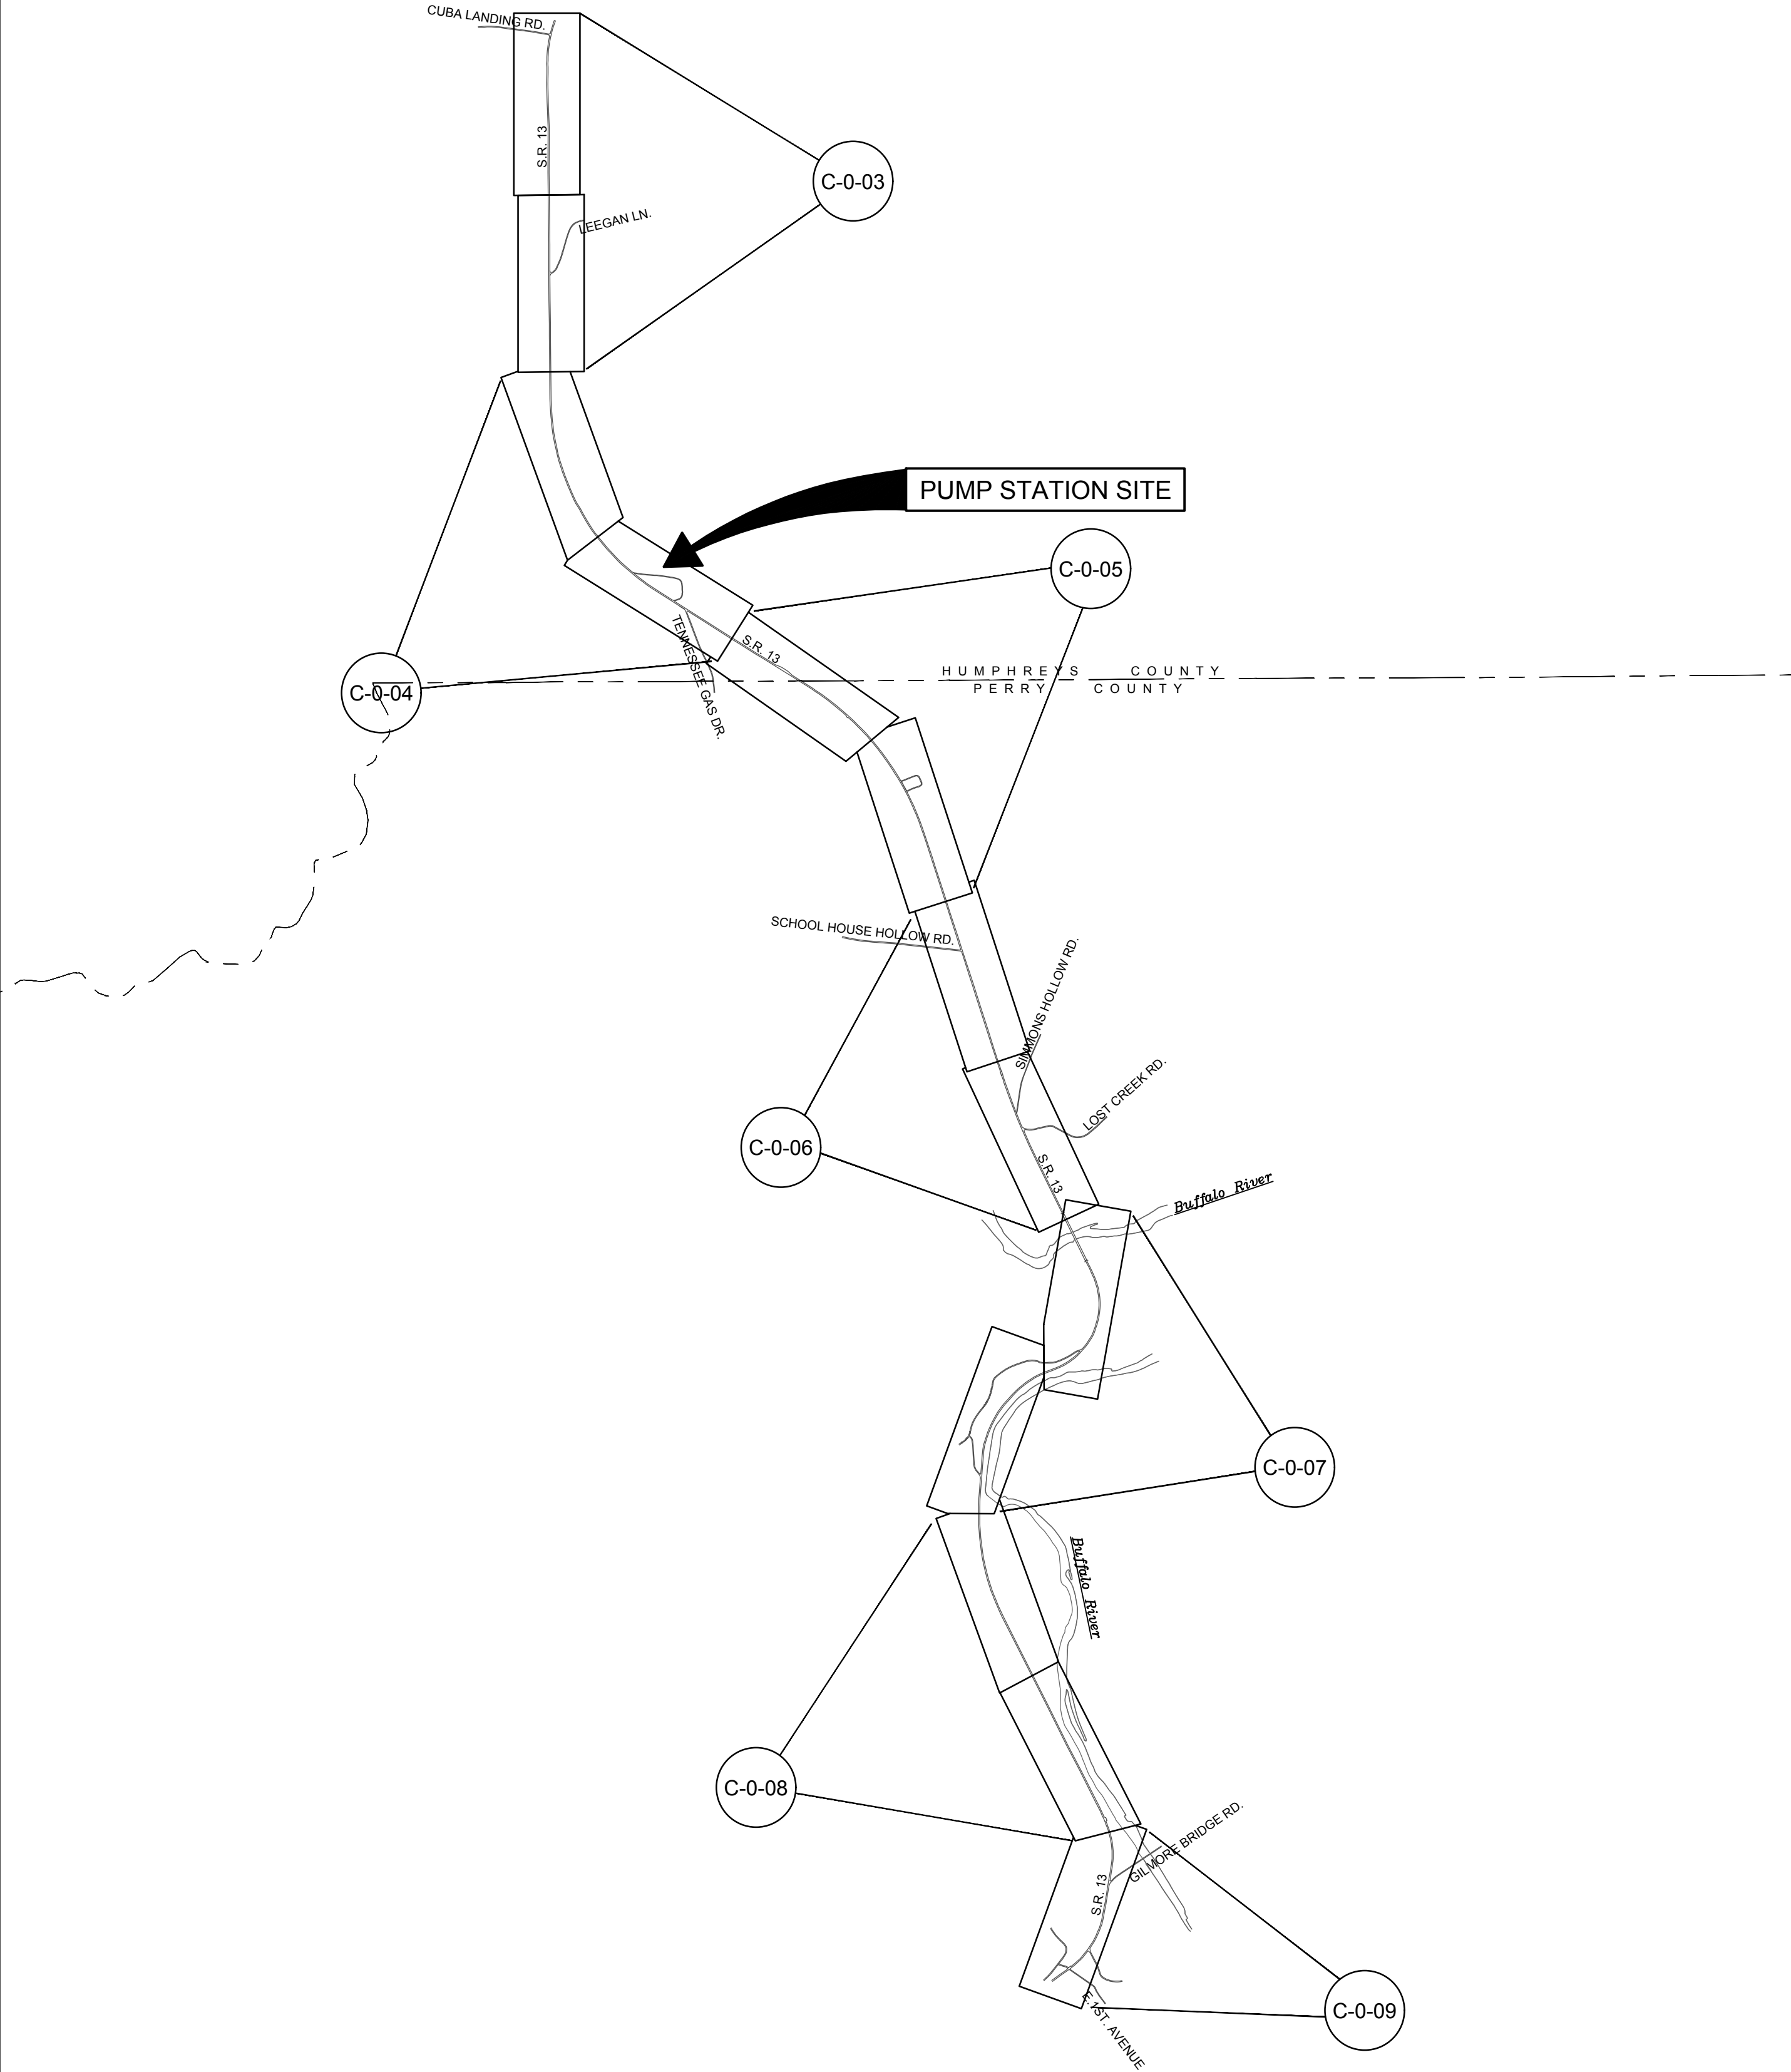

PROJECT SHEET KEYMAP
SCALE: 1" = 2000'

THIS RECORD DOCUMENT HAS BEEN PREPARED BASED ON INFORMATION PROVIDED BY THE CONSTRUCTION CONTRACTOR. GRW ENGINEERS, INC. HAS ATTEMPTED TO VERIFY THE ACCURACY AND/OR COMPLETENESS OF THIS INFORMATION BUT SHALL NOT BE RESPONSIBLE FOR ANY ERRORS OR OMISSIONS WHICH MAY BE INCORPORATED HEREIN AS A RESULT.

GRW
engineering | architecture | geospatial
www.grwinc.com
ENGINEER/ARCHITECT: GRW Engineers, Inc.
CONSTRUCTION COMPANY: Hughes Construction Co.
DATE: 11/6/2015

This document, originally issued, sealed, and signed by Barry L. Cloyd, Tennessee Professional Engineer, No. 100893, on JULY 2013, shall not be used in lieu of a certified document.

GRW PROJECT NO. 3827-06



ENGINEERS - ARCHITECTS - PLANNERS
www.grwinc.com

PROJECT AREA MAP
AND PROJECT SHEET KEYMAP
2012-D DISASTER RECOVERY EMERGENCY
WATER CONNECTION IMPROVEMENTS - CONTRACT 34821
CITY OF LOBELVILLE, TENNESSEE

NO.	REVISIONS DESCRIPTION	DATE	BY	DESIGNED BLC	DRAWN DM	REVIEWED BLC	APPROVED BLC

DATE: JULY 2013
SCALE: AS NOTED
SHEET NO.

C-0-02