


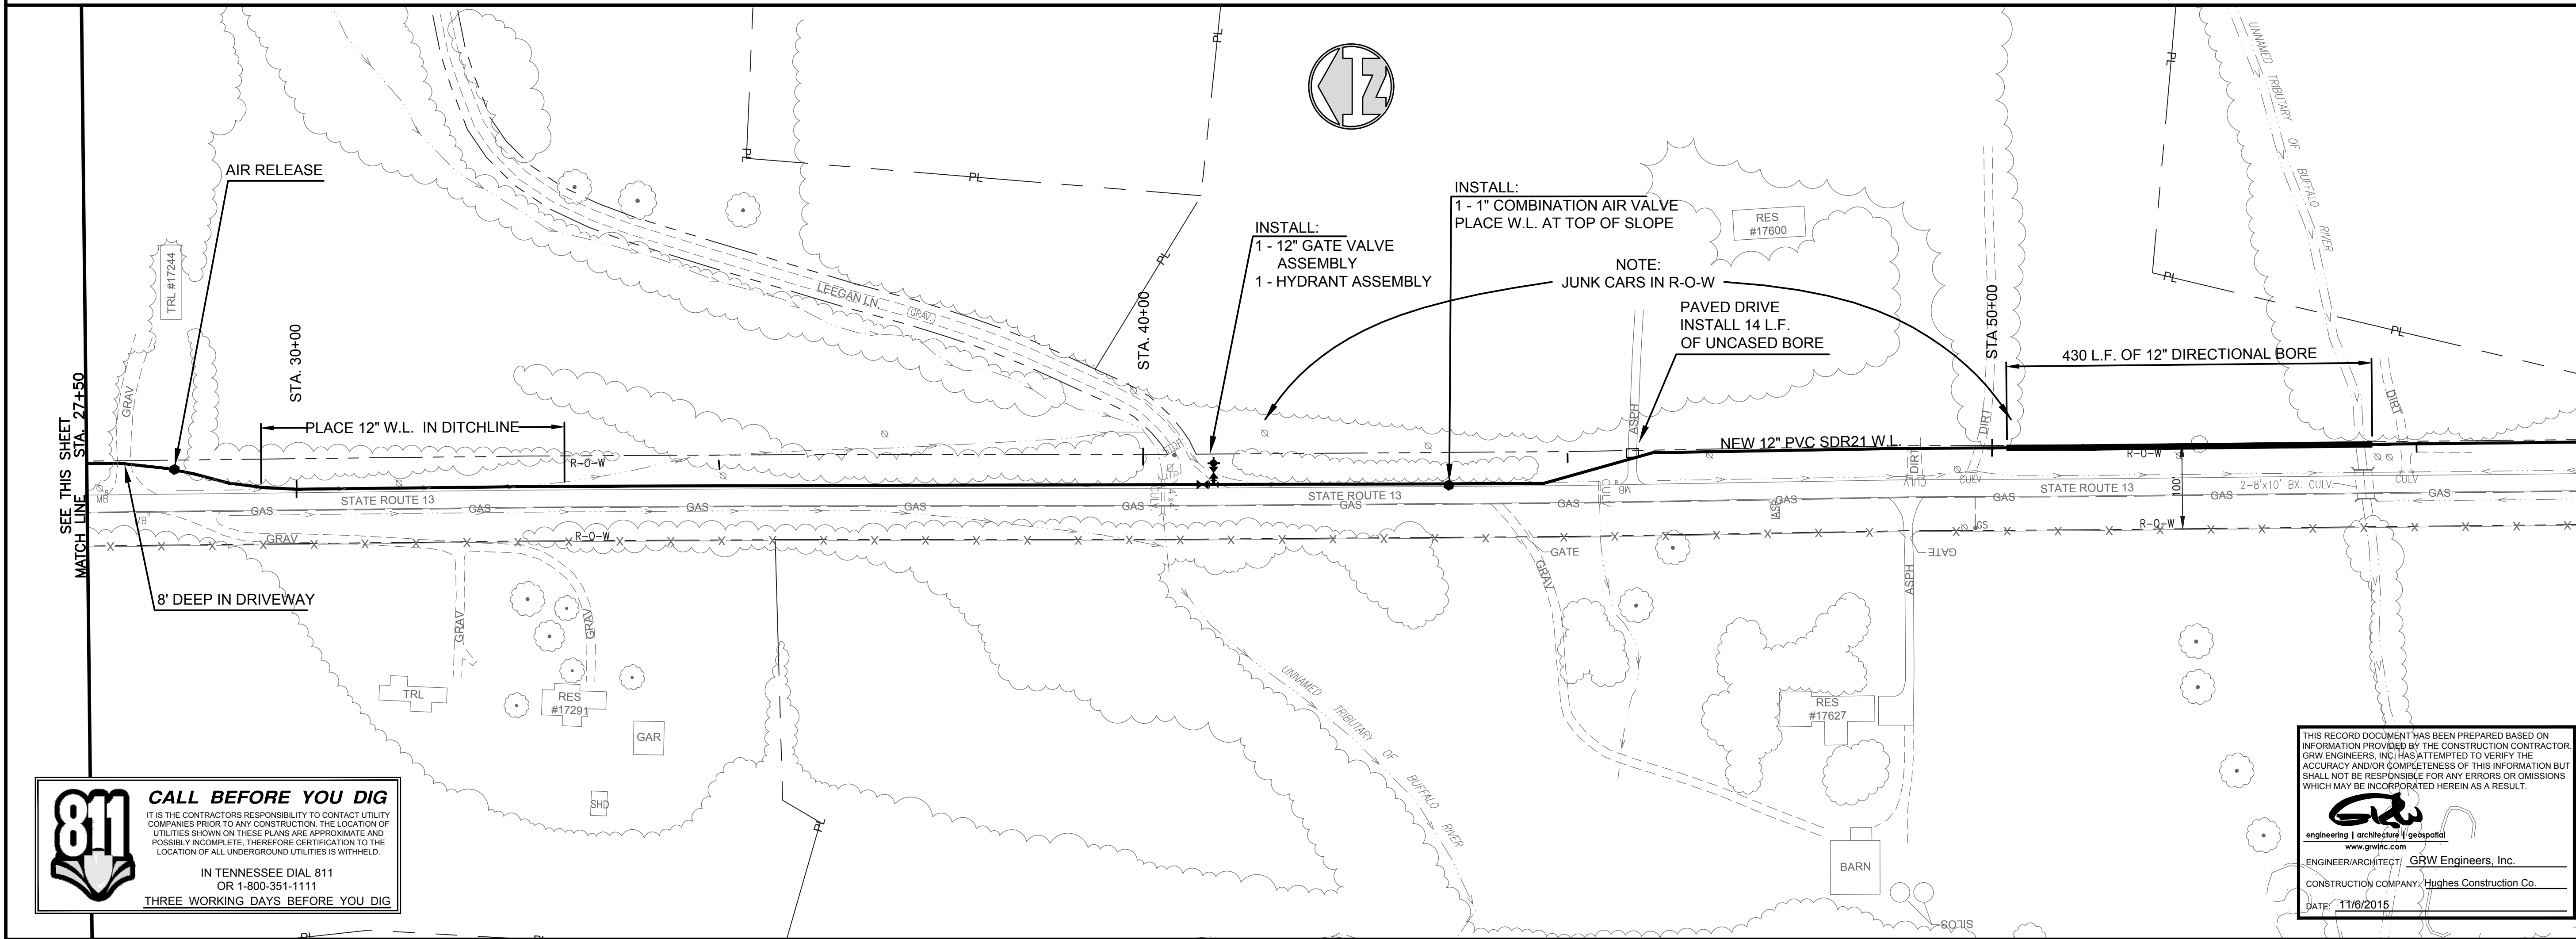

JULY 2013

SCALE:

1" = 100'

SHEET NO.

C-0-03