




PLOTTED BY: nazad

PRINTED: 8/6/2017 @ 3:09PM

FILE NAME: G:\3827-Lobelville\05-Label\Working\Drawings\Record Drawings\3827-06-C-0-03rnu09.dwg

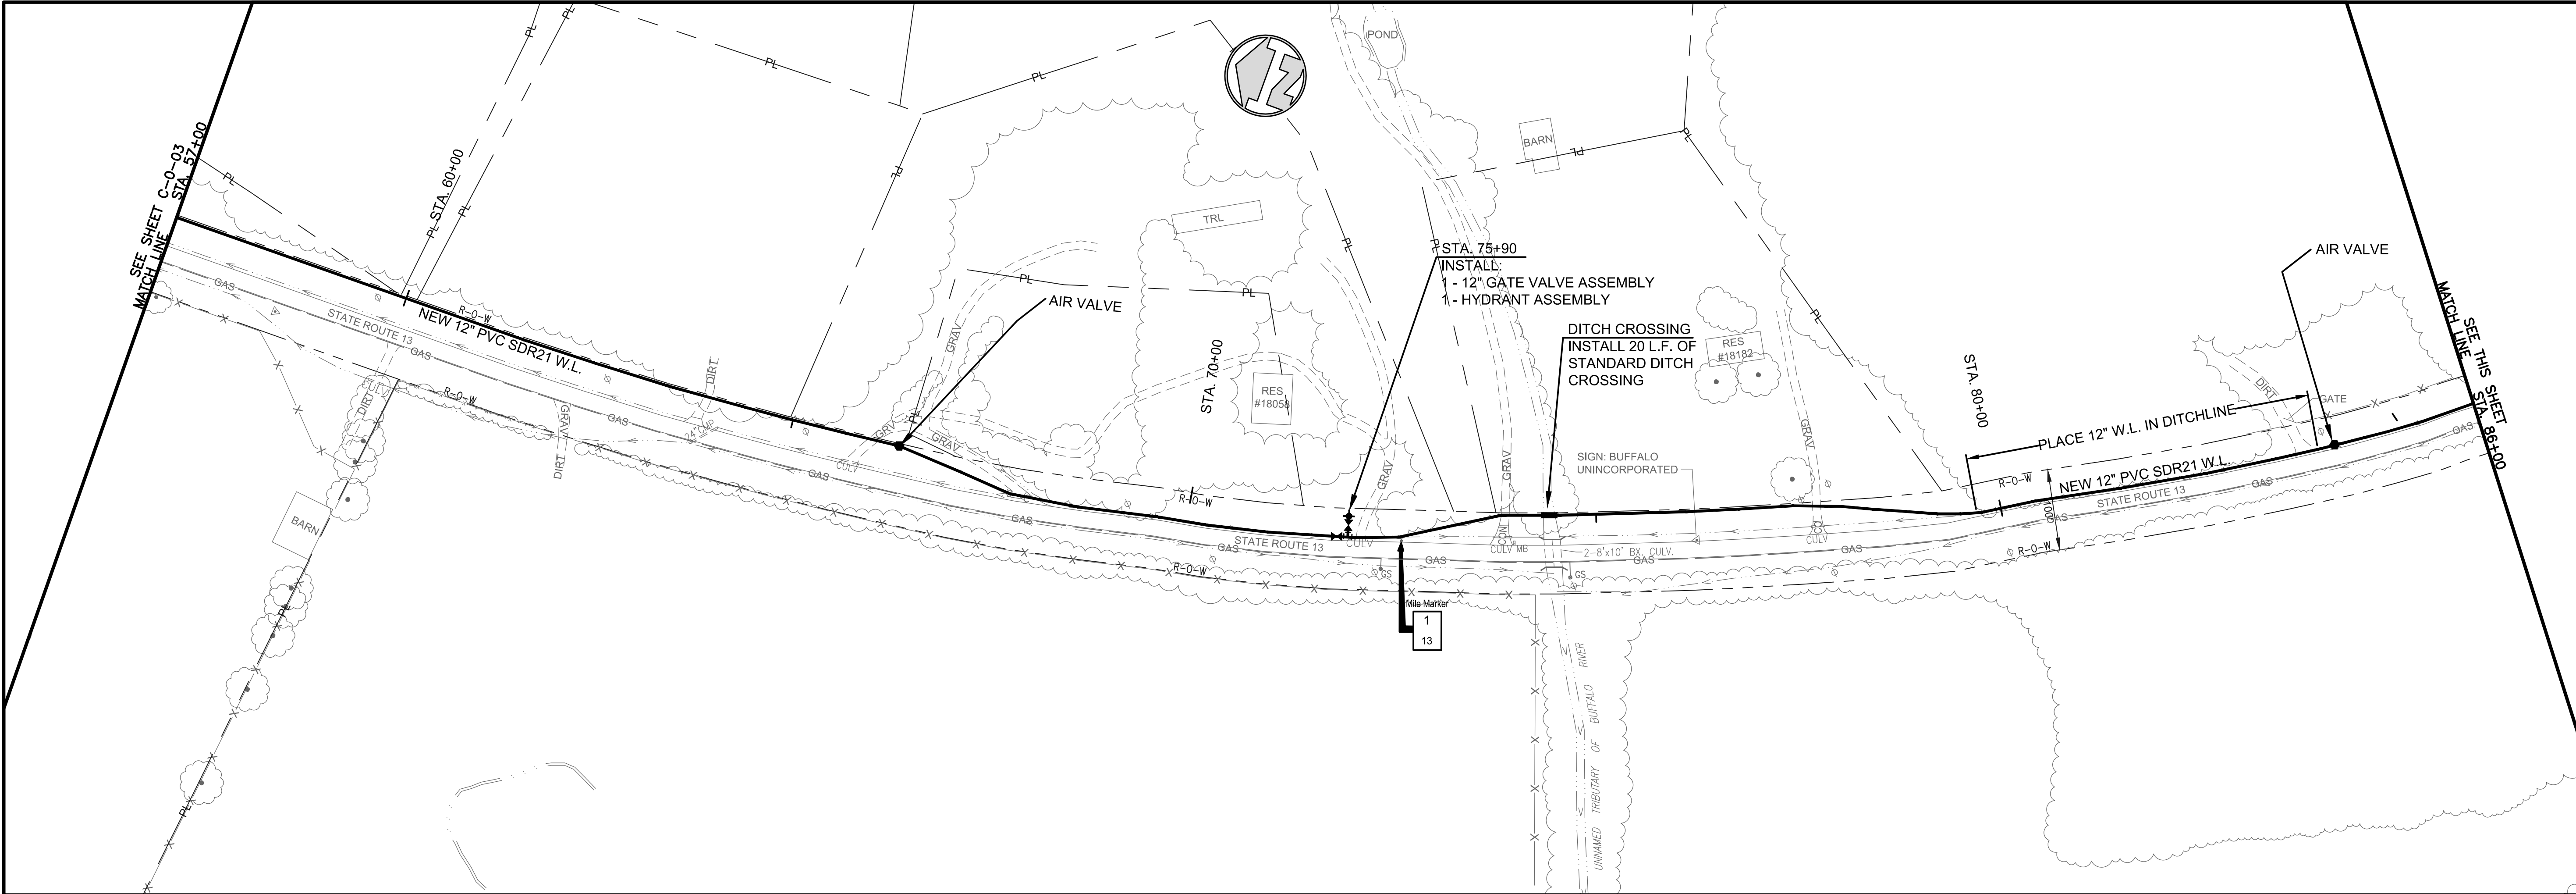

CONTRACTOR NOTE:
UNLESS OTHERWISE INDICATED ON THE
PLANS THE 12" WATER LINE SHALL BE PLACED
3 FEET INSIDE HIGHWAY RIGHT-OF-WAY

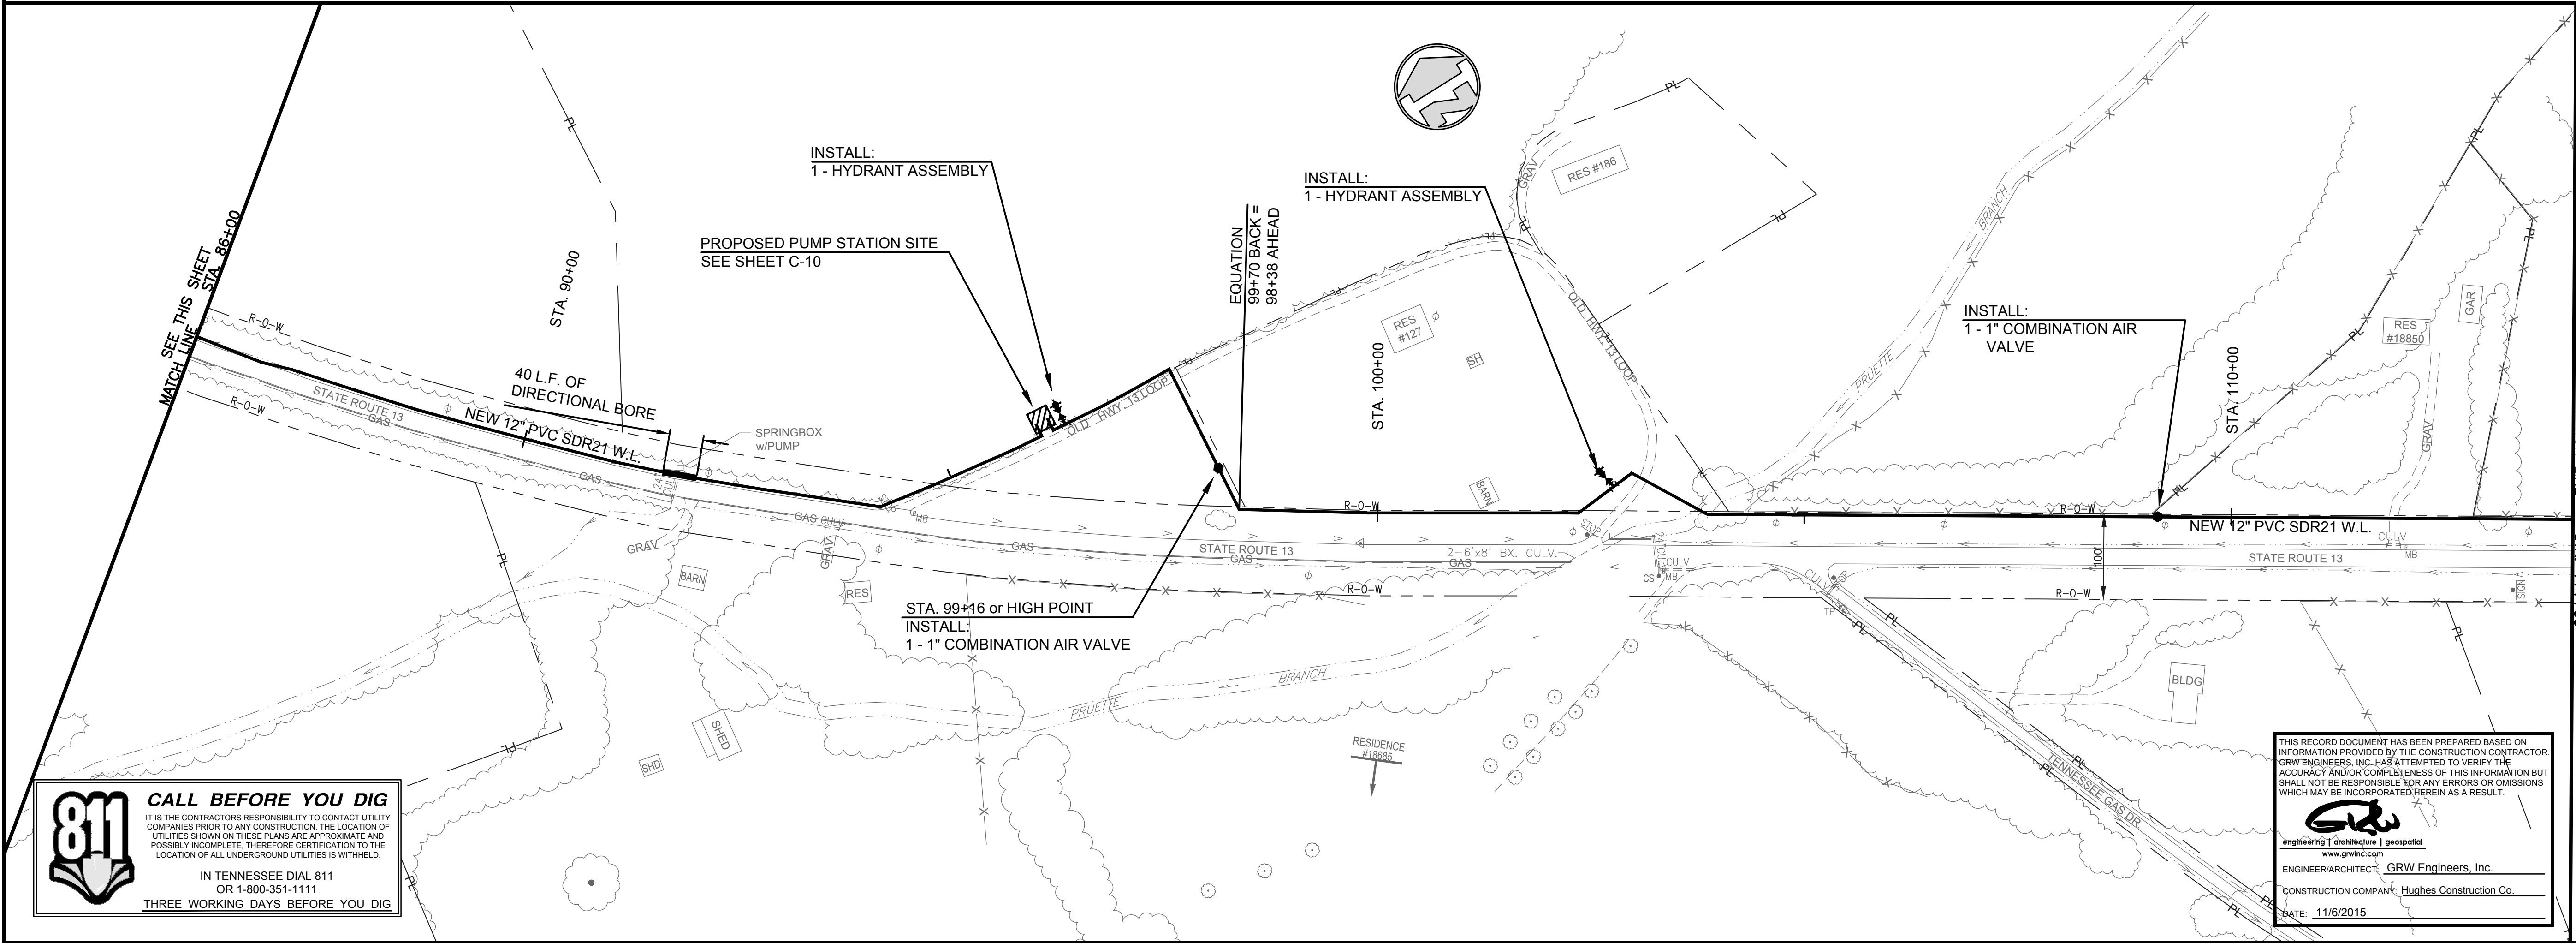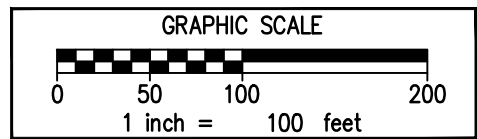



CALL BEFORE YOU DIG

IT IS THE CONTRACTOR'S RESPONSIBILITY TO CONTACT UTILITY COMPANIES PRIOR TO ANY CONSTRUCTION. THE LOCATION OF UTILITIES SHOWN ON THESE PLANS ARE APPROXIMATE AND POSSIBLY INCOMPLETE. THEREFORE CERTIFICATION TO THE LOCATION OF ALL UNDERGROUND UTILITIES IS WITHHELD.

IN TENNESSEE DIAL 811
OR 1-800-351-1111
THREE WORKING DAYS BEFORE YOU DIG

THIS RECORD DOCUMENT HAS BEEN PREPARED BASED ON INFORMATION PROVIDED BY THE CONSTRUCTION CONTRACTOR. GRW ENGINEERS, INC. HAS ATTEMPTED TO VERIFY THE ACCURACY AND/OR COMPLETENESS OF THIS INFORMATION BUT SHALL NOT BE RESPONSIBLE FOR ANY ERRORS OR OMISSIONS WHICH MAY BE INCORPORATED HEREIN AS A RESULT.



ENGINEERING | ARCHITECTURE | GEOSPATIAL
www.grwinc.com

ENGINEER/ARCHITECT: GRW Engineers, Inc.
CONSTRUCTION COMPANY: Hughes Construction Co.
DATE: 11/6/2015

This document, originally issued, sealed, and signed by Barry L. Cloyd, Tennessee Professional Engineer, No. 100893, on JULY 2013, shall not be used in lieu of a certified document.

GRW PROJECT NO. 3827-06

ALL RIGHTS RESERVED. NO PART OF THIS DOCUMENT MAY BE REPRODUCED OR TRANSMITTED IN ANY FORM OR BY ANY MEANS, ELECTRONIC OR MECHANICAL, WITHOUT WRITTEN PERMISSION.



ENGINEERS - ARCHITECTS - PLANNERS
www.grwinc.com

12" WATER LINE - STA. 57+00 TO STA. 114+00
2012-D DISASTER RECOVERY EMERGENCY
WATER CONNECTION IMPROVEMENTS - CONTRACT 34821
CITY OF LOBELVILLE, TENNESSEE

REVISIONS					DESIGNED:	BLC
NO.	DESCRIPTION	DATE	BY		DRAWN	DM
					REVIEWED: <th>BLC</th>	BLC
					APPROVED: <th>BLC</th>	BLC
SCALE CHECK: _____					THIS MARK SHOULD MEASURE EXACTLY 1" WHEN PLOTTED	

DATE: JULY 2013

SCALE: 1" = 100'

SHEET NO.

C-0-04

DESIGN DRAWINGS